FED. ROAD DIST. NO.	STATE	PROJ. NO.	FISCAL YEAR	SHEET NO.	TOTAL SHEETS
HAWAII	HAW.	11C-01-92M	1992	1	12

11

INDEX TO DRAWINGS

SHEET NO.	DESCRIPTION
1	TITLE SHEET
2	STANDARD PLANS SUMMARY
3	TYPICAL SECTIONS & DETAILS
4-7	ROADWAY & STRIPING PLAN
(1) 8	RECONSTRUCTION DETAIL & SCHEDULE
9	SURVEY MONUMENT SCHEDULE
(2) 10-11	MISCELLANEOUS SCHEDULES
(3) 12	CONSTRUCTION SIGN DETAIL, E.P. MARKING & SCHEDULES

(1) ADD 8S-1, (2) 10S-1, (3) 12S-1 ARE SUPPLEMENT SHEETS TO THIS PROJECT. TOTAL SHEET COUNT AFTER "AS-BUILT" POSTINGS 15 SHEETS.

STATE OF HAWAII

DEPARTMENT OF TRANSPORTATION
HIGHWAYS DIVISION
HONOLULU, HAWAII

"AS-BUILT"
PLANS FOR

HAWAII BELT ROAD RESURFACING

KAAPUNA TO MILOLII

PROJECT NO. 11C-01-92M

DISTRICT OF SOUTH KONA
ISLAND OF HAWAII

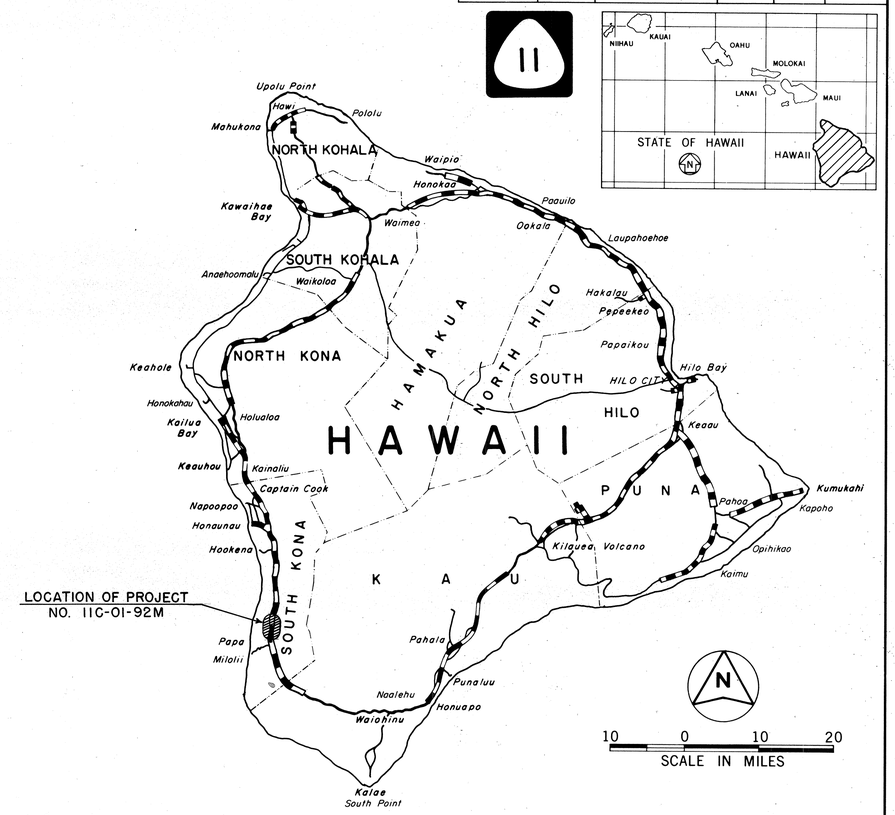

FEDERAL AID PROJECTS PREVIOUSLY CONSTRUCTED OR UNDER CONSTRUCTION

MILE POST 88.99 TO MILE POST 93.21

PROJECT LIMITS
4.22 MILES

BEGIN PROJ. NO. 11C-01-92M
STA. 913+01.67 = (M.P. 93.21)
STA. 40+06.28

STA. 1139+31.20 (M.P. 88.99)
END PROJ. NO. 11C-01-92M

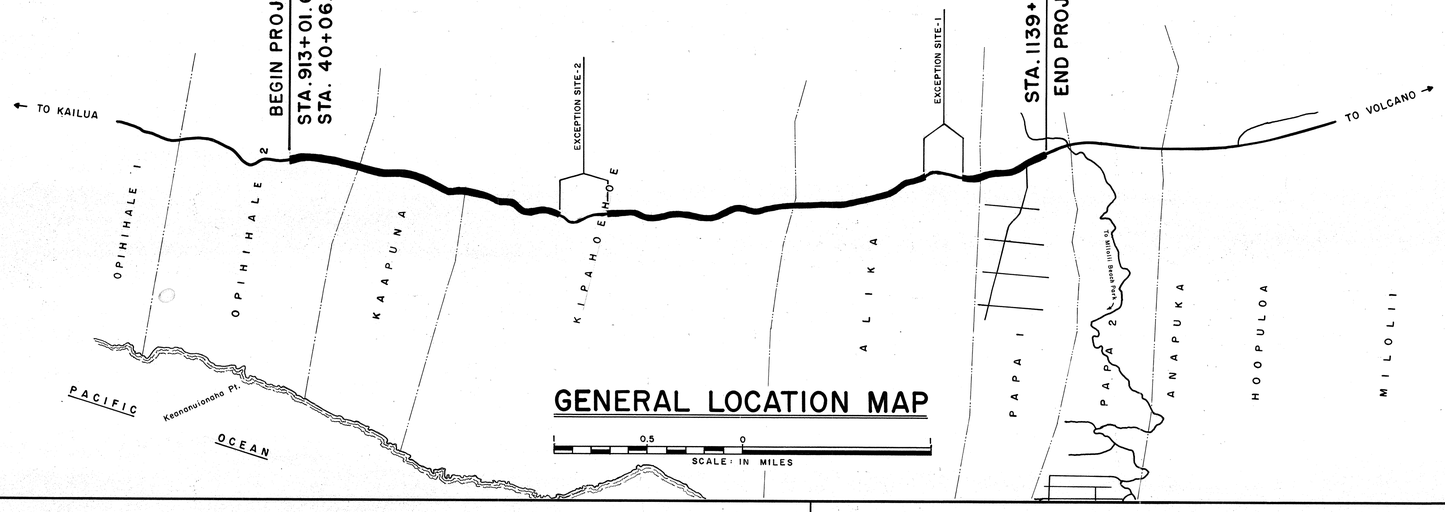

GENERAL LOCATION MAP

CHANGES MADE DURING CONSTRUCTION HAVE BEEN INCORPORATED ON THESE PLANS EXCEPT CHANGES IN THE ORIGINAL THEORETICAL QUANTITIES. FOR ACTUAL QUANTITIES, REFER TO PROJECT LEDGER AND OR COMPUTATION BOOK.

RESIDENT ENGINEER — DATE 4-22-99

DEPARTMENT OF TRANSPORTATION
STATE OF HAWAII
APPROVED:
For DIR. OF TRANSPORTATION — DATE 4/15/92

HAWAII DISTRICT — DESIGNED BY
J. KASAMOTO — P. S. & E. BY
587-2250 — PHONE
JAN. 1992 — DATE

0-7-0