
84732

FED. ROAD DIST. NO.	STATE	PROJ. NO.	FISCAL YEAR	SHEET NO.	TOTAL SHEETS
HAWAII	HAW.	IIBC-01-91	1991	C.O.18	25

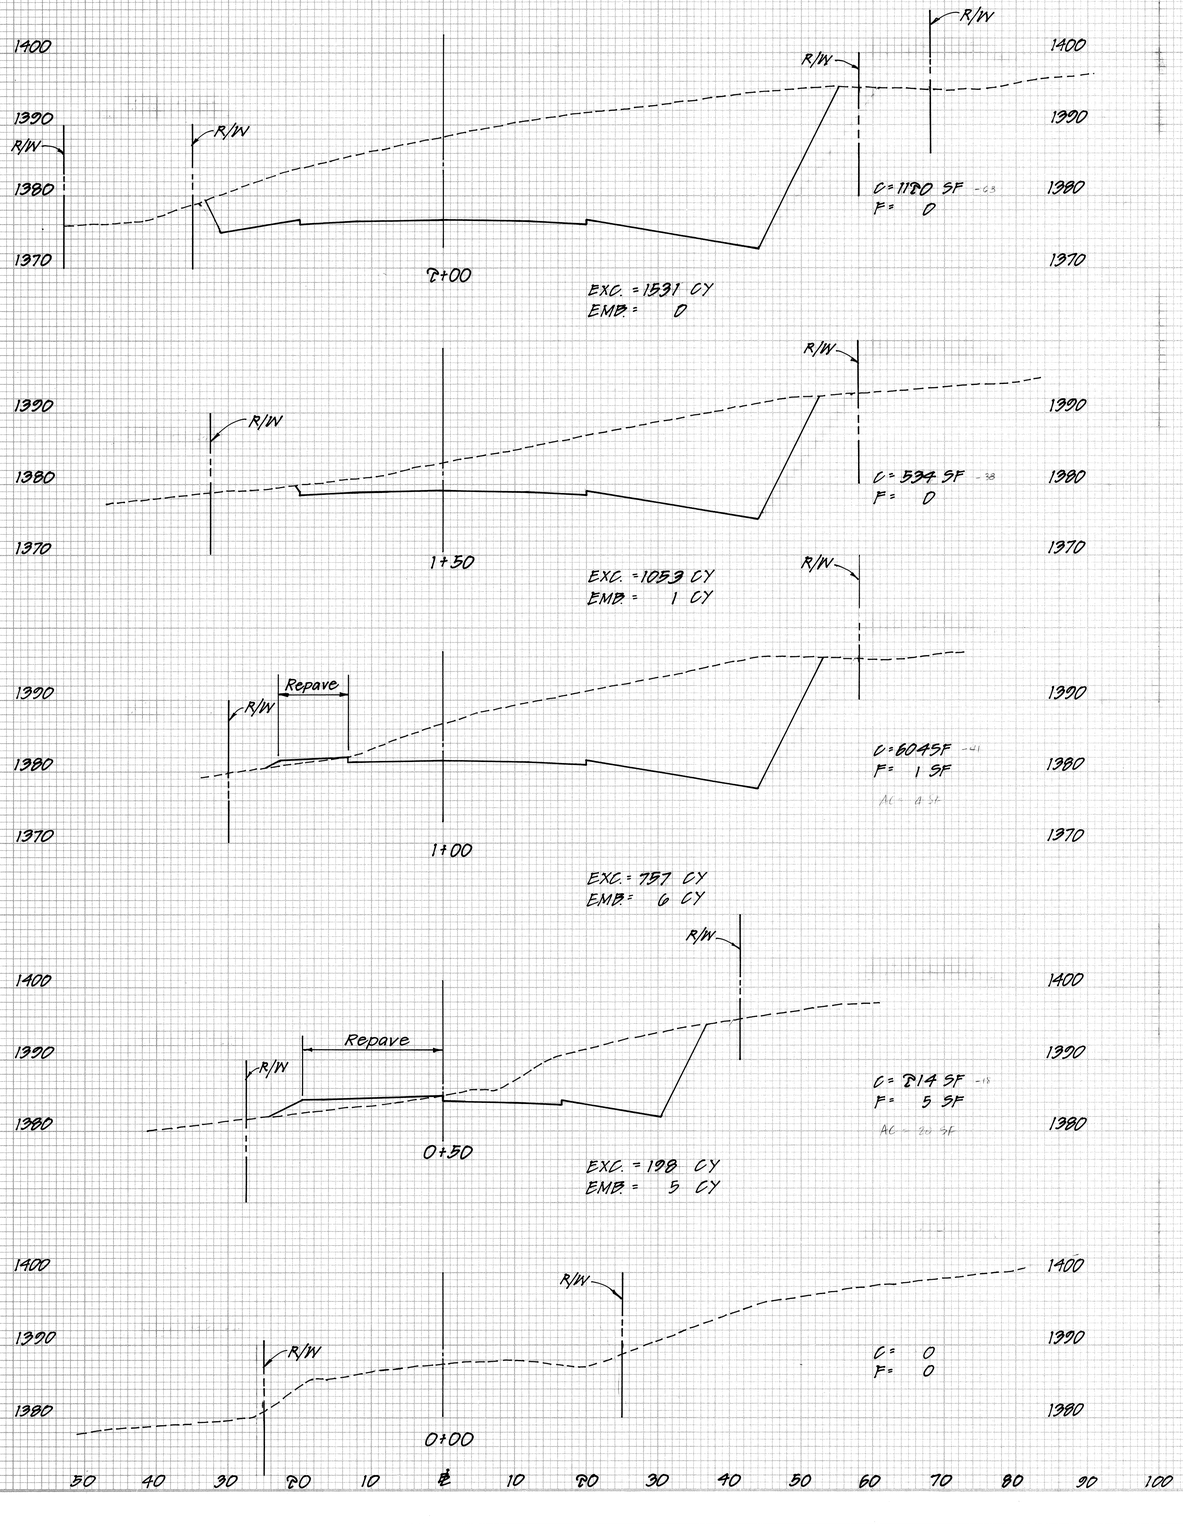

FINAL SURVEY — SURVEYED, PLOTTED, TEMPLATE, AREAS, AREAS CHECKED, NOTE BOOK, NO., BY, DATE

ORIGINAL SURVEY — SURVEYED, PLOTTED, TEMPLATE, AREAS, AREAS CHECKED, NOTE BOOK, NO., BY, DATE

DATE	REVISION
11/19/92	REVISED CUT SLOPE AND QUANTITY

SITE C

Scale: Hor. 1" = 10'
Ver. 1" = 10'


C.O.18

84732

FED. ROAD DIST. NO.	STATE	PROJ. NO.	FISCAL YEAR	SHEET NO.	TOTAL SHEETS
HAWAII	HAW.	IIBC-01-91	1991	C.19	25

FINAL SURVEY — NOTE BOOK — NO. — SURVEYED — PLOTTED — TEMPLATE — AREAS — AREAS CHECKED — BY — DATE

ORIGINAL SURVEY — NOTE BOOK — NO. — SURVEYED — PLOTTED — TEMPLATE — AREAS — AREAS CHECKED — BY — DATE

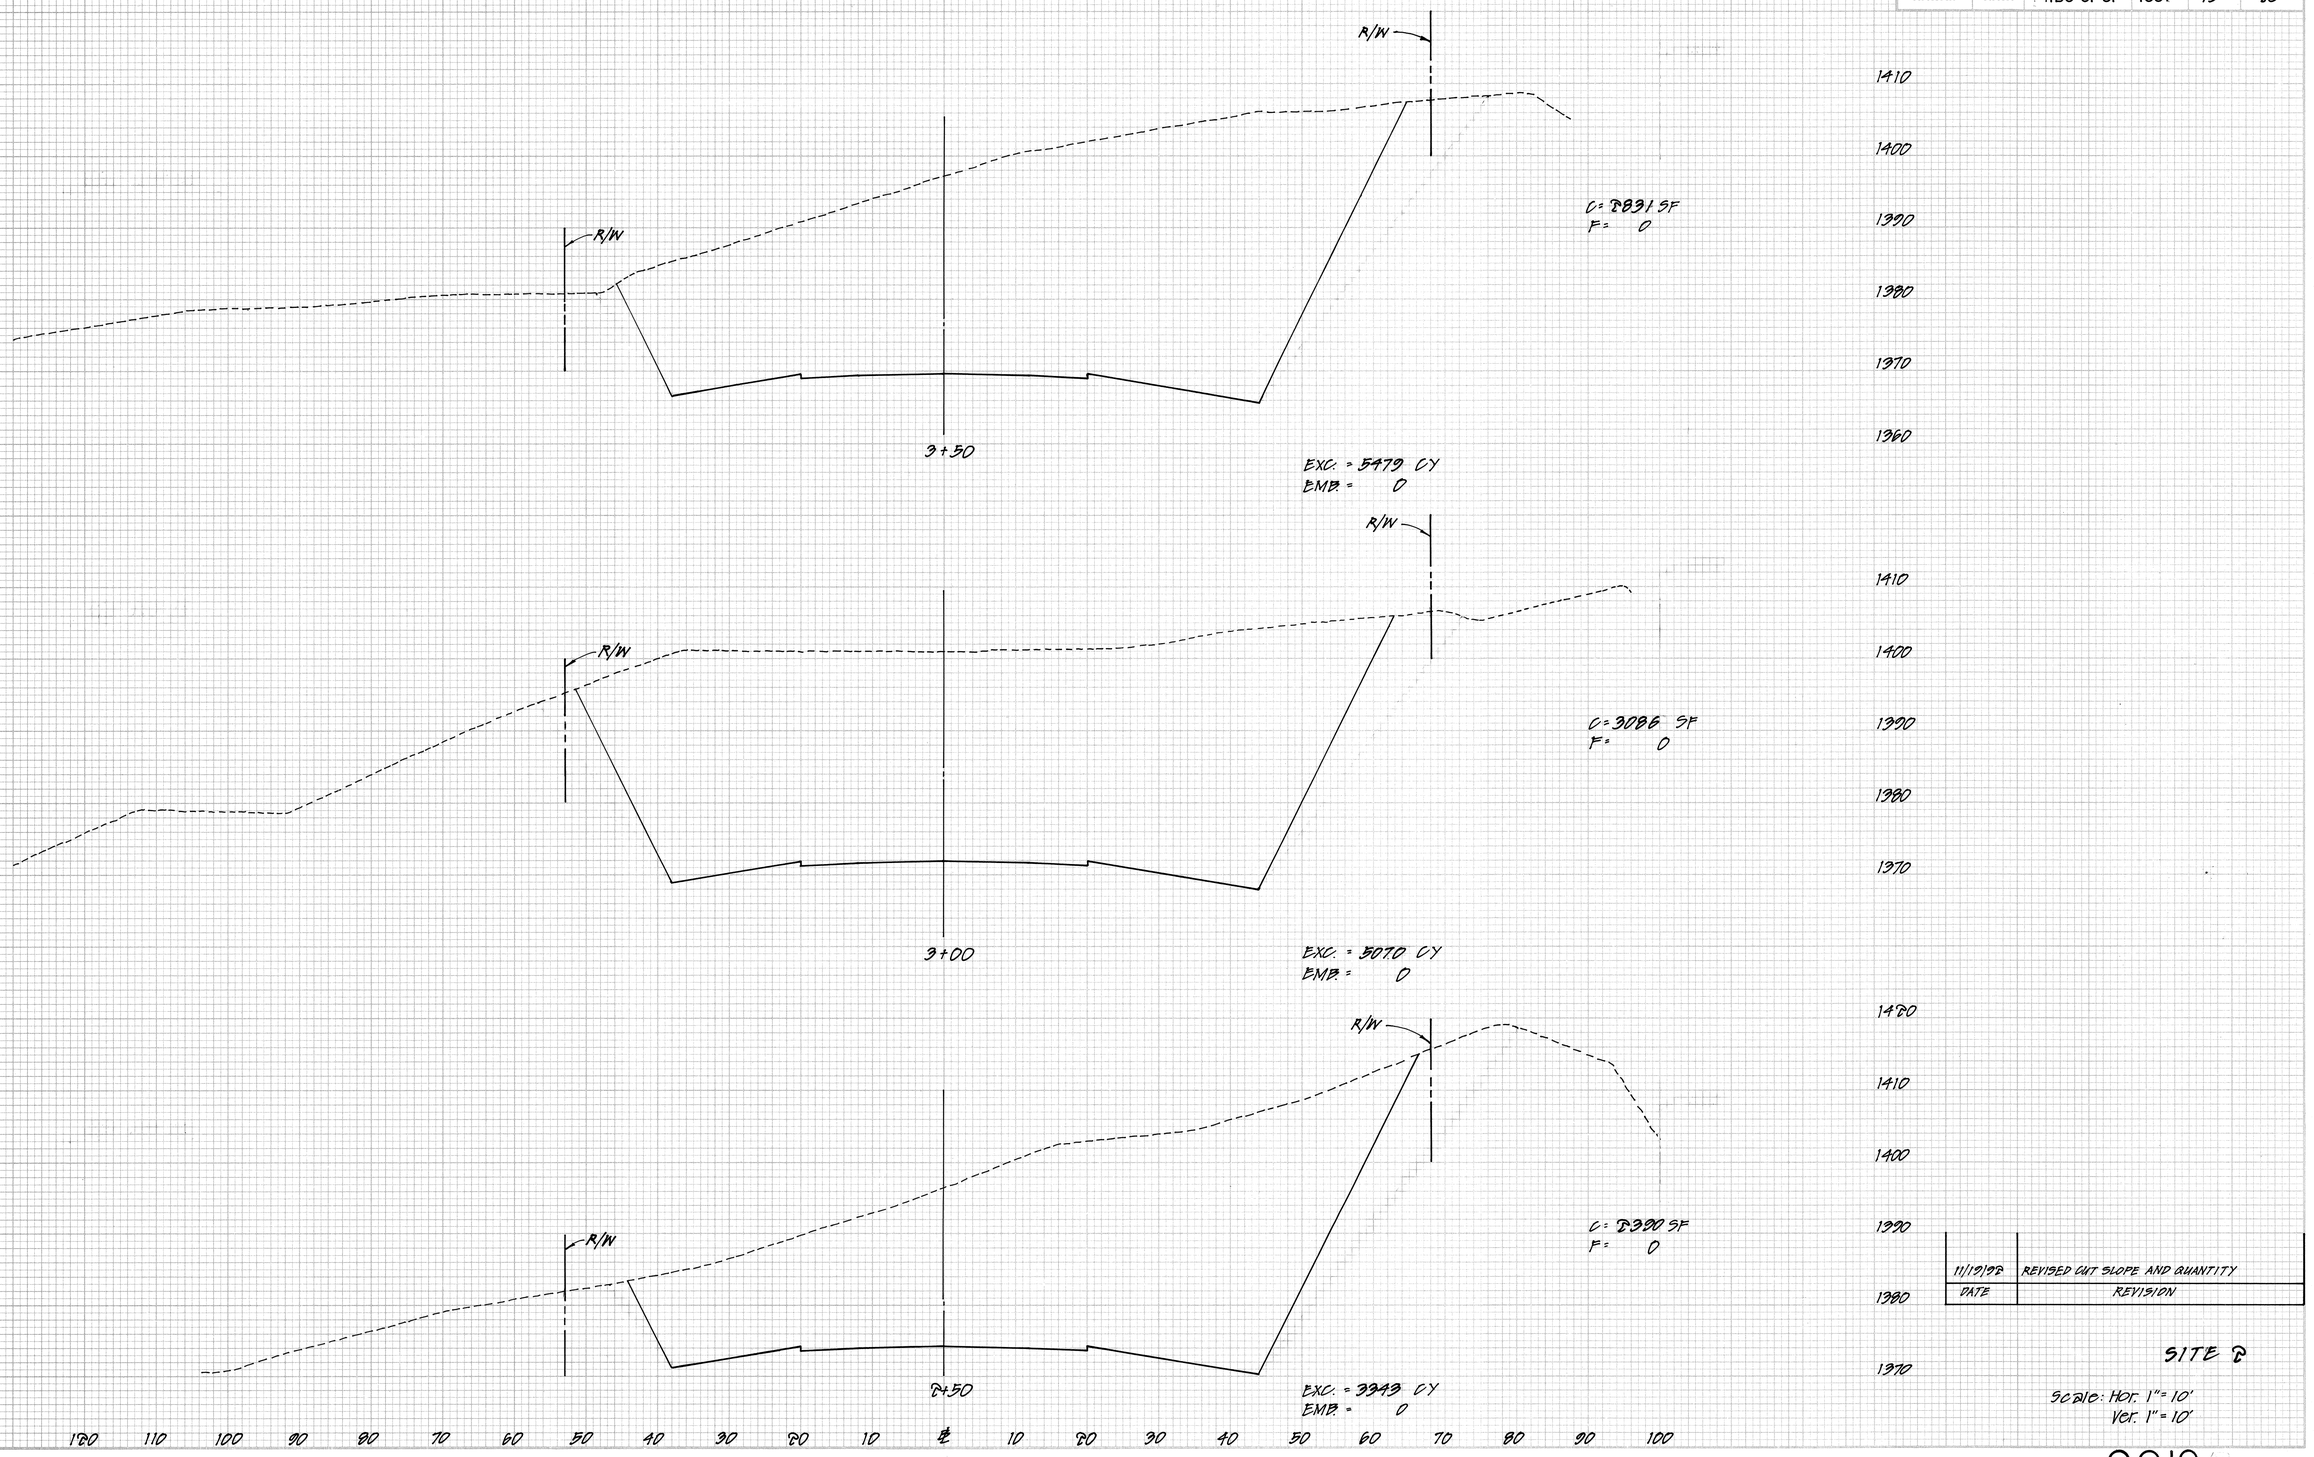

DATE	REVISION
11/19/92	REVISED CUT SLOPE AND QUANTITY

SITE C


SCALE: HOR. 1" = 10'
VER. 1" = 10'

84732

FED. ROAD DIST. NO.	STATE	PROJ. NO.	FISCAL YEAR	SHEET NO.	TOTAL SHEETS
HAWAII	HAW.	IIBC-01-91	1991	C.O. 20	25

DATE	REVISION
11/19/92	REVISED CUT SLOPE AND QUANTITY

ORIGINAL SURVEY
NOTE BOOK
NO.
SURVEYED
PLOTTED
TEMPLATE
AREAS
AREAS CHECKED
BY
DATE

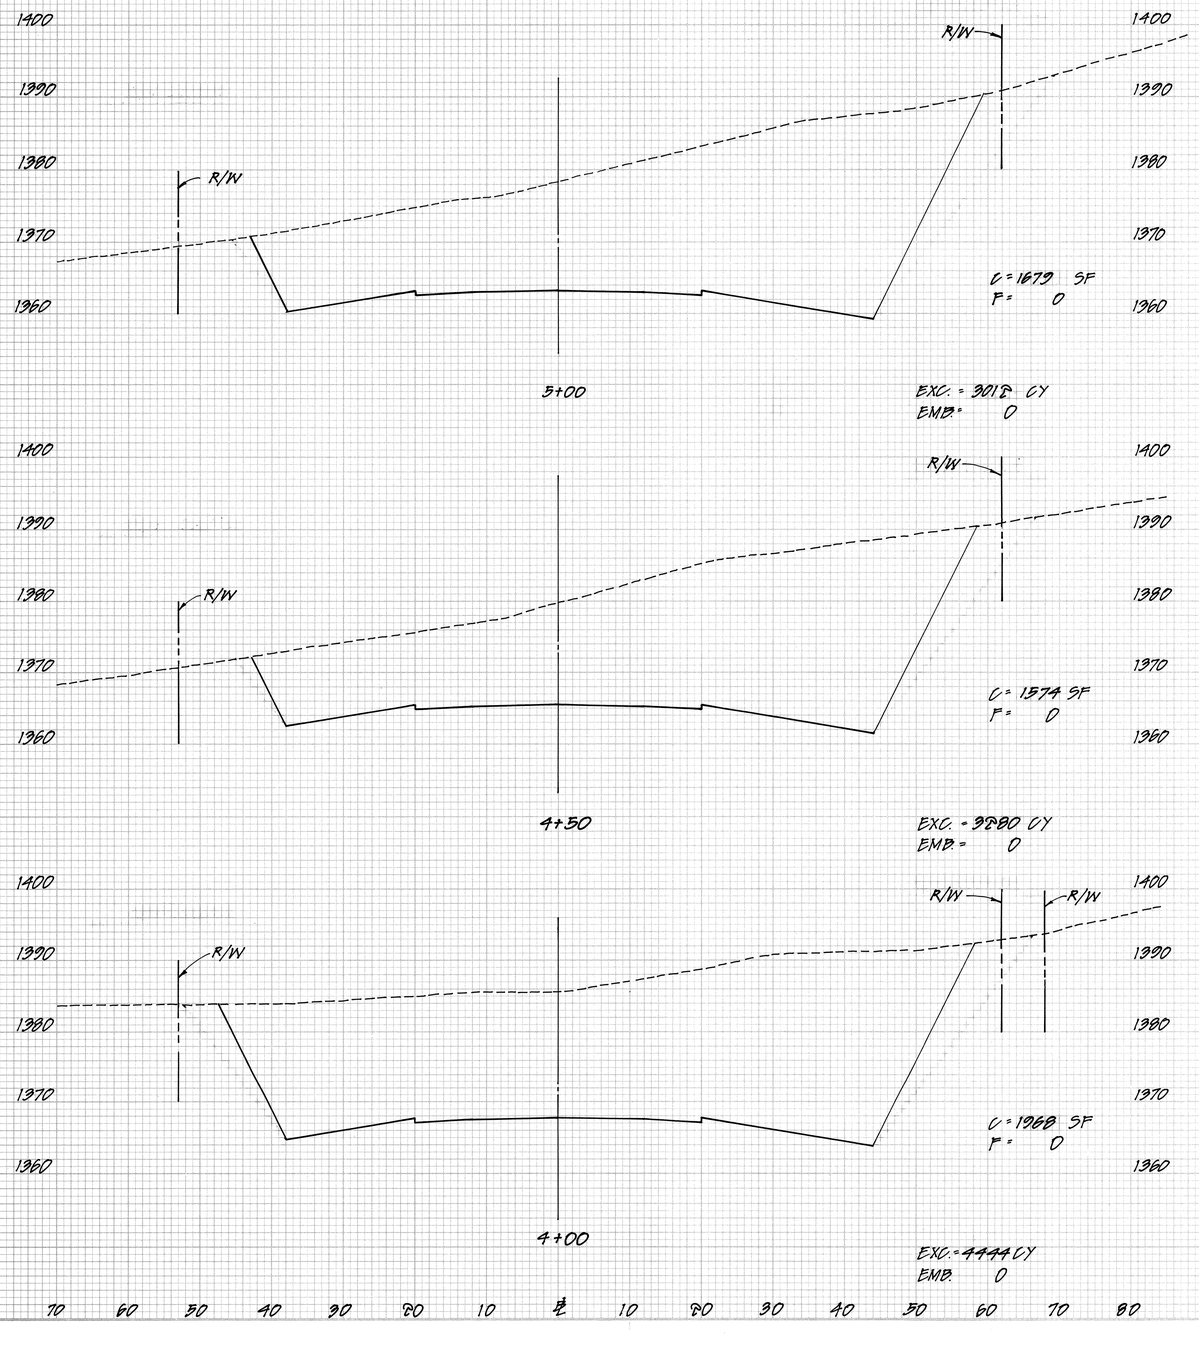

SITE P

C.O. 20


84732

FED. ROAD DIST. NO.	STATE	PROJ. NO.	FISCAL YEAR	SHEET NO.	TOTAL SHEETS
HAWAII	HAW.	IIBC-01-91	1991	C.O. 21	25

DATE	REVISION
11/19/92	REVISED CUT SLOPE AND QUANTITY


FINAL SURVEY — NOTE BOOK — NO. — SURVEYED — PLOTTED — TEMPLATE — AREAS — AREAS CHECKED — BY — DATE

ORIGINAL SURVEY — NOTE BOOK — NO. — SURVEYED — PLOTTED — TEMPLATE — AREAS — AREAS CHECKED — BY — DATE

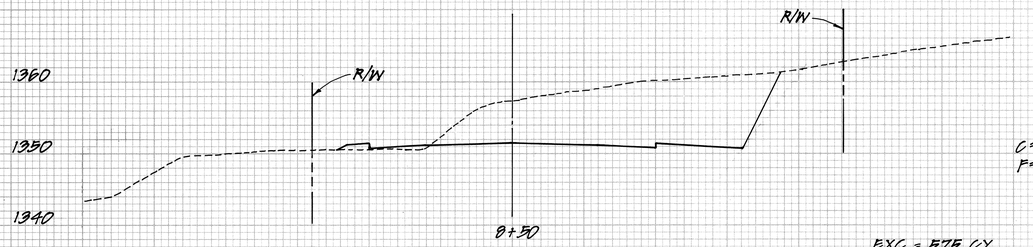


C= 338 SF
F= 7 SF

EXC. = 575 CY
EMB. = 13 CY

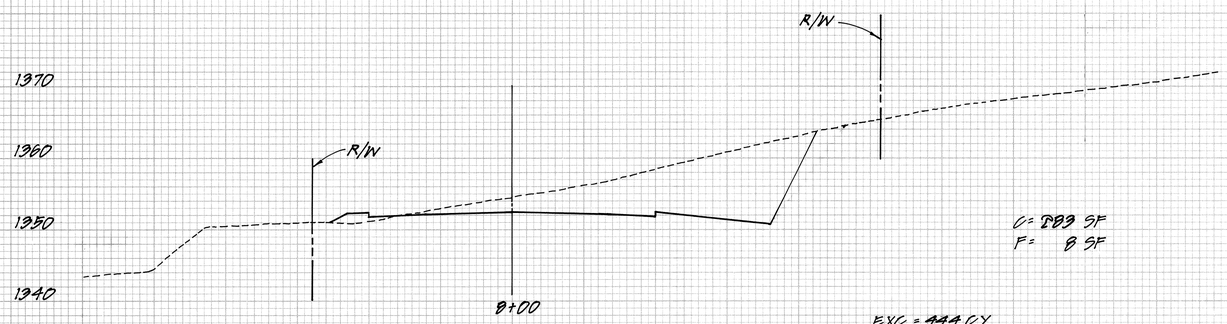


F= 8 SF

EXC. = 444 CY
EMB. = 47 CY

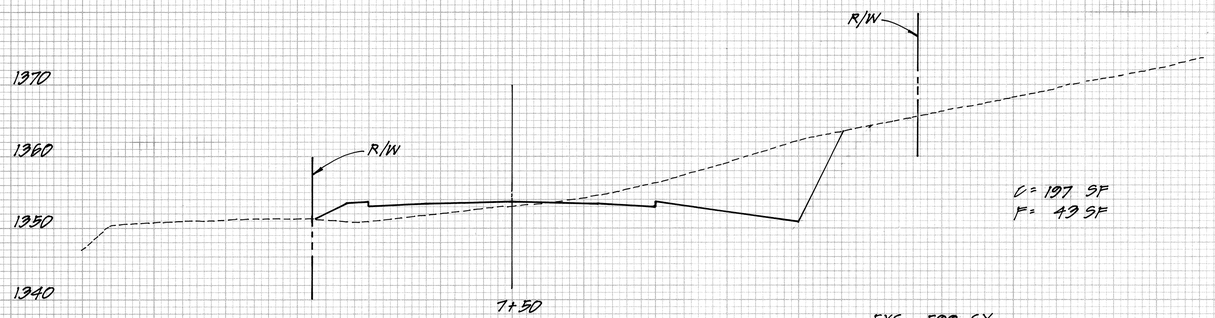

C= 197 SF
F= 43 SF


EXC. = 599 CY
EMB. = 40 CY

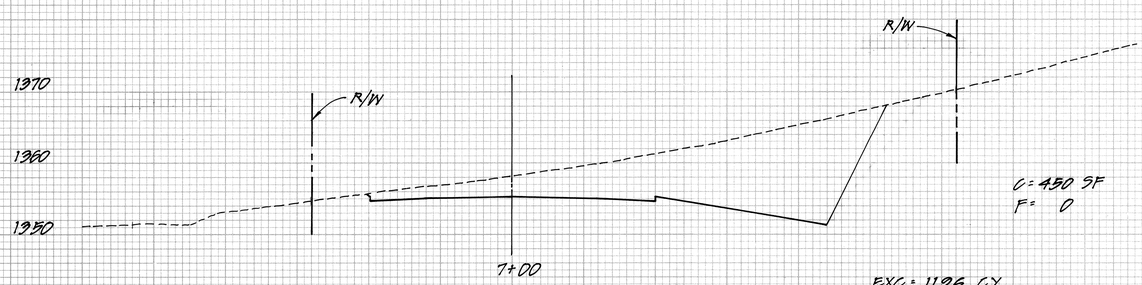

C= 450 SF
F= 0

EXC. = 1196 CY
EMB. = 0


60 50 40 30 20 10 ℄ 10 20 30 40 50 60 70 80

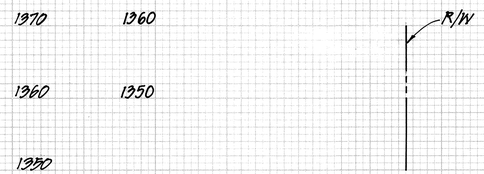

TOTAL
EXC. = 30,787 CY
EMB. = 128 CY


C= 0 SF
F= 0 SF

EXC. = 0 CY
EMB. = 0 CY

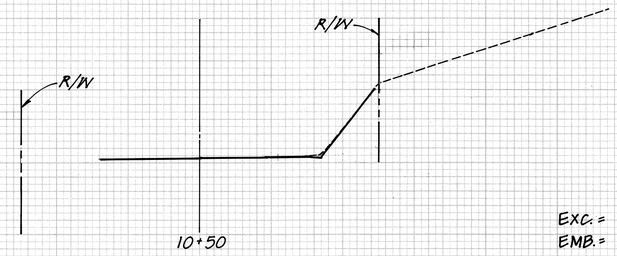


C= 0 SF
F= 0 SF

EXC. = 99 CY
EMB. = 2 CY

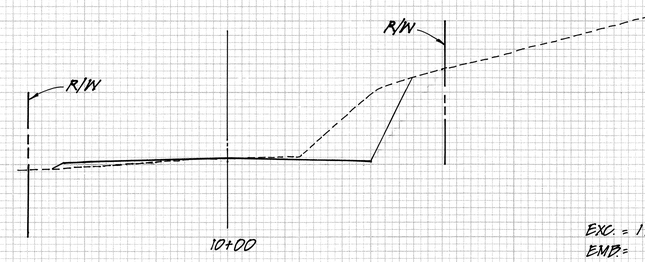


C= 100 SF
F= 2 SF

EXC. = 178 CY
EMB. = 4 CY

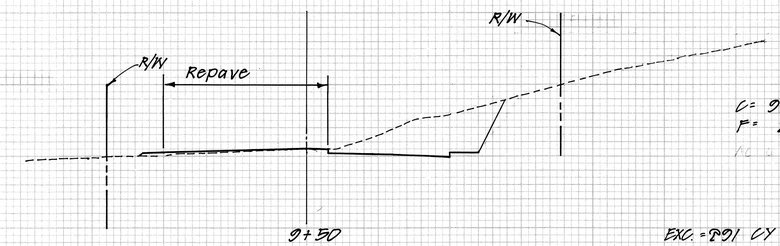

C= 98 SF
F= 2 SF

EMB. = 3 CY

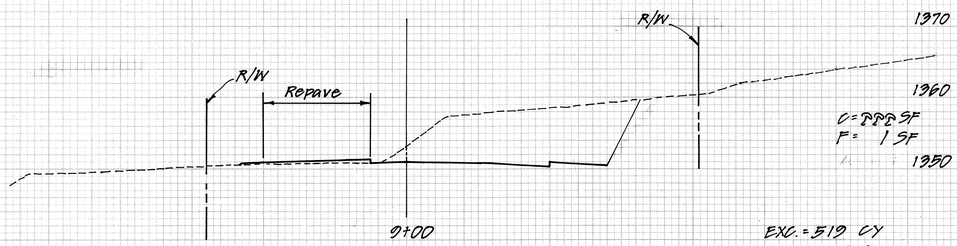

C= 222 SF
F= 1 SF

EXC. = 519 CY
EMB. = 6 CY

SITE 2

50 40 30 20 10 ℄ 10 20 30 40 50

C.O. 21