FED. ROAD DIST. NO.	STATE	FED. AID PROJ. NO.	FISCAL YEAR	SHEET NO.	TOTAL SHEETS
HAWAII	HAWAII	ER-12(2)	2001	9	145

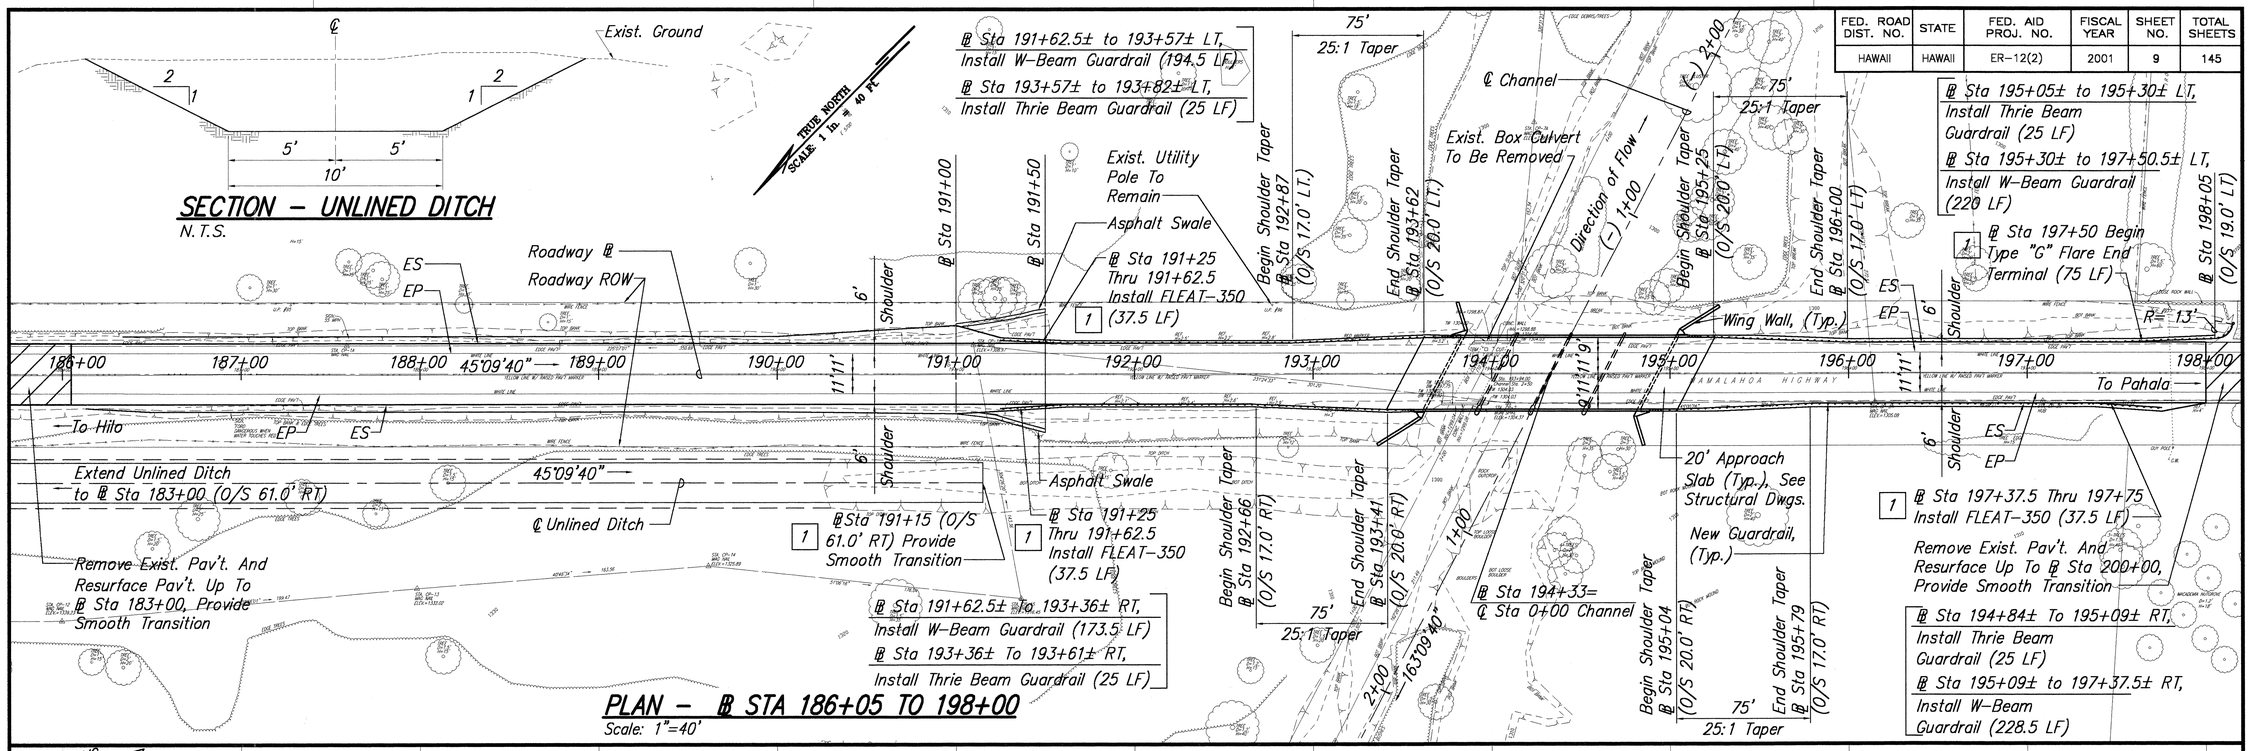

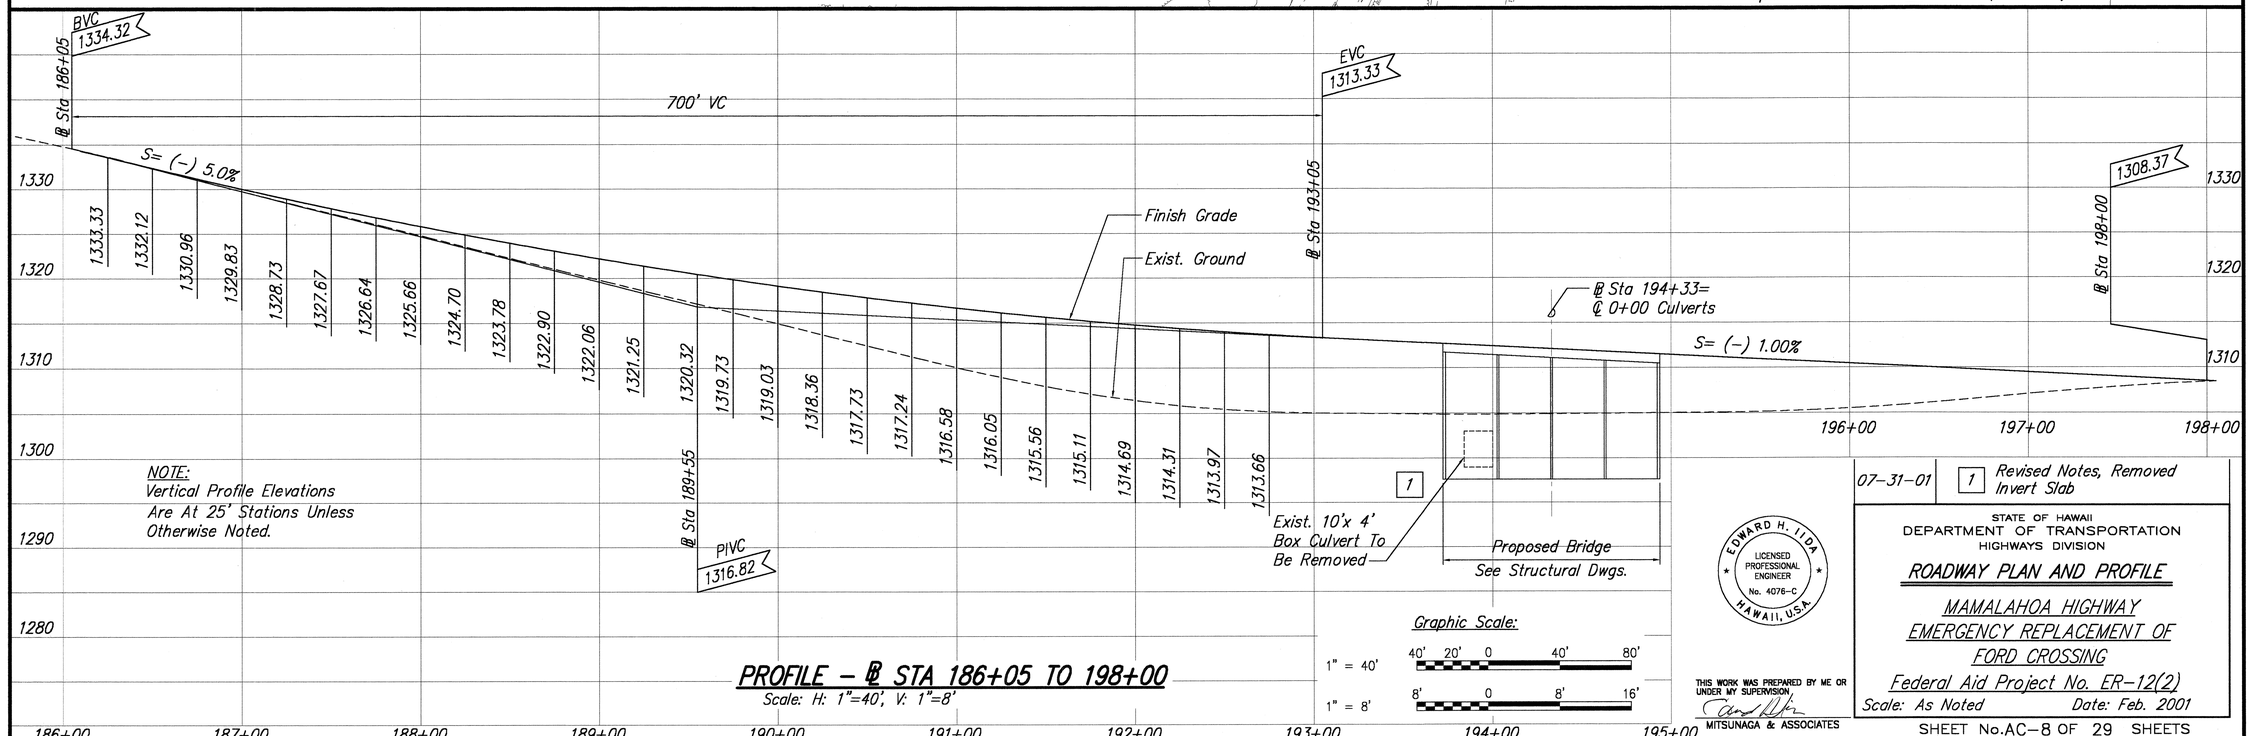

NOTE:
Vertical Profile Elevations Are At 25' Stations Unless Otherwise Noted.

07-31-01	1 Revised Notes, Removed Invert Slab

STATE OF HAWAII
DEPARTMENT OF TRANSPORTATION
HIGHWAYS DIVISION

ROADWAY PLAN AND PROFILE

MAMALAHOA HIGHWAY
EMERGENCY REPLACEMENT OF
FORD CROSSING
Federal Aid Project No. ER-12(2)

Scale: As Noted Date: Feb. 2001

EDWARD H. IIDA
LICENSED PROFESSIONAL ENGINEER
No. 4076-C
HAWAII, U.S.A.

THIS WORK WAS PREPARED BY ME OR UNDER MY SUPERVISION
MITSUNAGA & ASSOCIATES

SHEET No. AC-8 OF 29 SHEETS

ORIGINAL PLAN
NOTE BOOK No.
SURVEY PLOTTED BY
DRAWN BY
TRACED BY
DESIGNED BY
QUANTITIES BY
CHECKED BY
DATE

ADD. 9