FED. ROAD DIST. NO.	STATE	PROJ. NO.	FISCAL YEAR	SHEET NO.	TOTAL SHEETS
HAWAII	HAW.	11BC-01-01M	2001	1	68

INDEX TO DRAWINGS

SHEET NO.	DESCRIPTION
1	TITLE SHEET
2	STANDARD PLANS SUMMARY
3	GENERAL NOTES AND LEGENDS
4, 5	WATER POLLUTION & EROSION CONTROL
	NOTES
6–8	TYPICAL SECTION AND DETAILS
9–11	TYPICAL SECTION SCHEDULES
12–26	ROADWAY PLANS
27 ①	PAVEMENT RECONSTRUCTION SCHEDULE AND
	MISC. DETAILS
28	GUARDRAIL SCHEDULES
29	FLEAT-350 GUARDRAIL DETAILS
30–32	TYPE "A-1" GUARDRAIL DETAILS
33–37	BITUMINOUS CURB TYPE 6 SCHEDULE
38	PAVEMENT MARKING LEGEND AND NOTES
39–53	SIGNING AND STRIPING PLANS
54, 55	SIGN DETAILS AND NOTES
56, 57	SIGN SCHEDULES
58–64	REFLECTOR AND OBJECT MARKER SCHEDULE
②65–67	MISCELLANEOUS SCHEDULES
68	CONSTRUCTION SIGN PLAN AND SCHEDULE

SHEET NO. ① 27 S-1 AND ② 65 S-1 ARE SUPPLEMENTAL SHEETS TO THIS PROJECT. TOTAL SHEET COUNT AFTER "AS-BUILT" POSTING IS 70 SHEETS.

STATE OF HAWAII

DEPARTMENT OF TRANSPORTATION

HIGHWAYS DIVISION

HONOLULU, HAWAII

"AS-BUILT"

PLANS FOR

HAWAII BELT ROAD RESURFACING, HONOKUA TO PAHOEHOE

MP 103.1 TO ~~96.5~~ 5.7

PROJECT NO. 11BC-01-01M

DISTRICT OF SOUTH KONA

ISLAND OF HAWAII

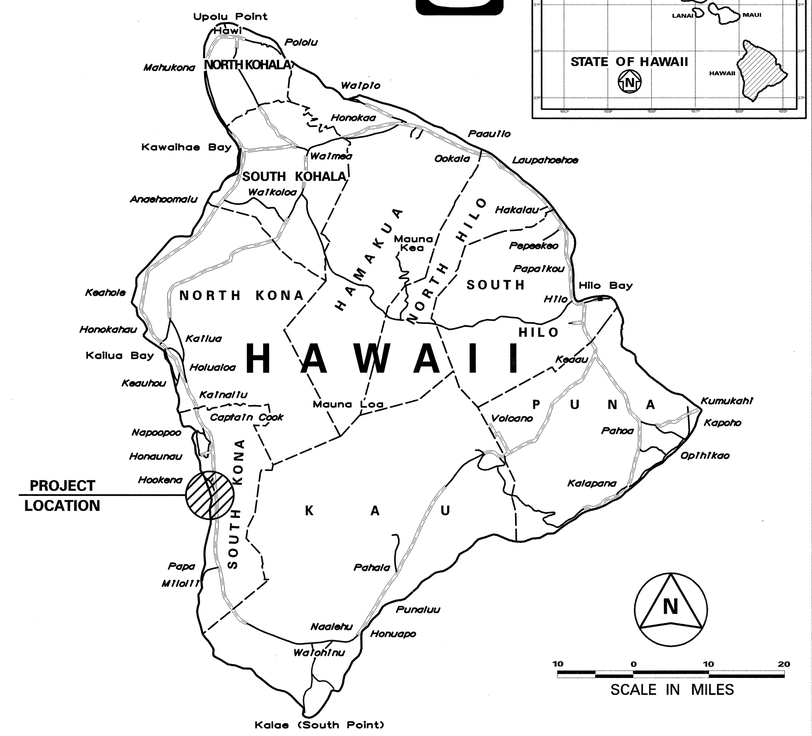

FEDERAL AID PROJECTS PREVIOUSLY CONSTRUCTED OR UNDER CONSTRUCTION

MILE POST ~~96.50~~ 95.69 TO MILE POST 103.10

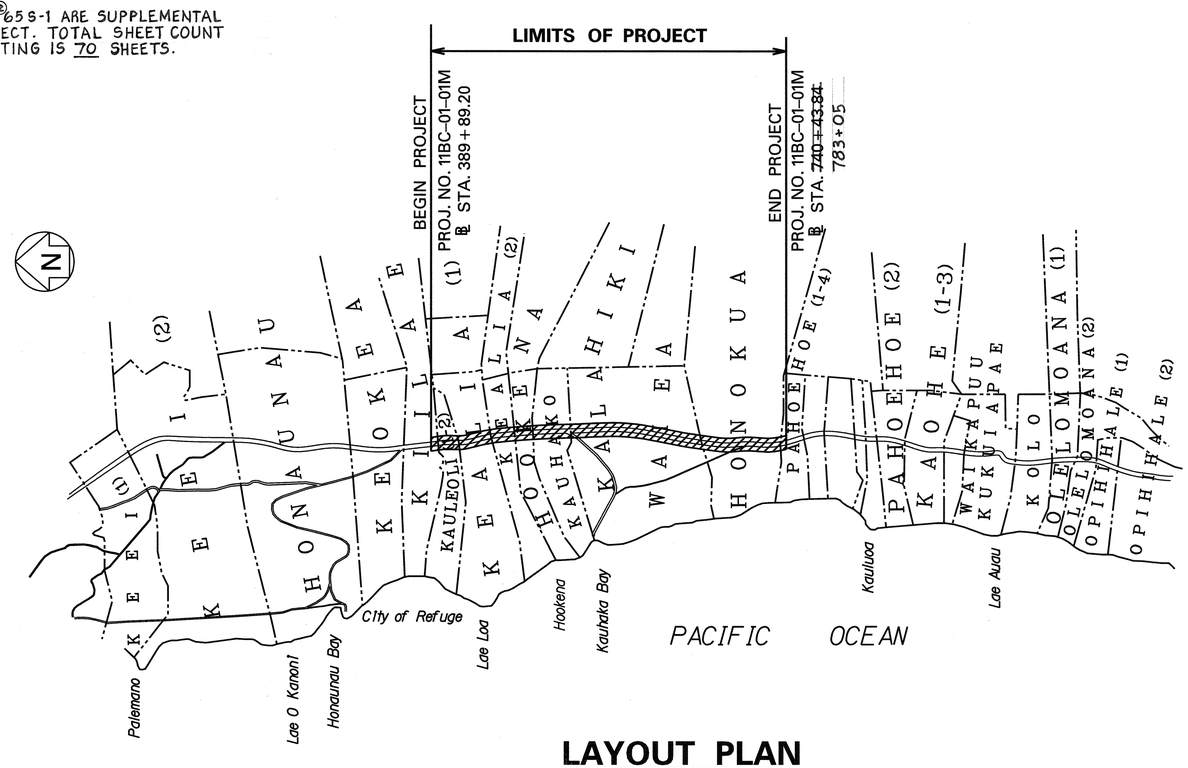

LAYOUT PLAN

NET LENGTH OF PROJECT..... ~~6.60~~ 7.41 MILES

CHANGES MADE DURING CONSTRUCTION HAVE BEEN INCORPORATED ON THESE PLANS EXCEPT CHANGES IN THE ORIGINAL THEORETICAL QUANTITIES. FOR ACTUAL QUANTITIES, REFER TO PROJECT LEDGER AND/OR COMPUTATION BOOK.

Charles A. Sakoda 10-2-04
RESIDENT ENGINEER DATE

APPROVED:

03/19/01
FOR MANAGER, DEPARTMENT OF WATER SUPPLY COUNTY OF HAWAII (G.Y.) DATE

DEPARTMENT OF TRANSPORTATION
STATE OF HAWAII

APPROVED:

4-20-01
FOR DIR. OF TRANSPORTATION DATE

OKAHARA & ASSOC. DESIGNED BY | R. TAIRA P. S. & E. BY | 933-8866 PHONE | APRIL 2001 DATE

96001C1.2d