FED. ROAD DIST. NO.	STATE	FED. AID PROJ. NO.	FISCAL YEAR	SHEET NO.	TOTAL SHEETS
HAWAII	HAW.	STP-011-2(32)	1999	11	34

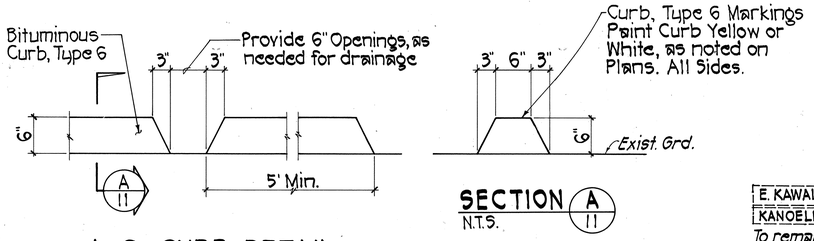

A.C. CURB DETAIL

Not To Scale

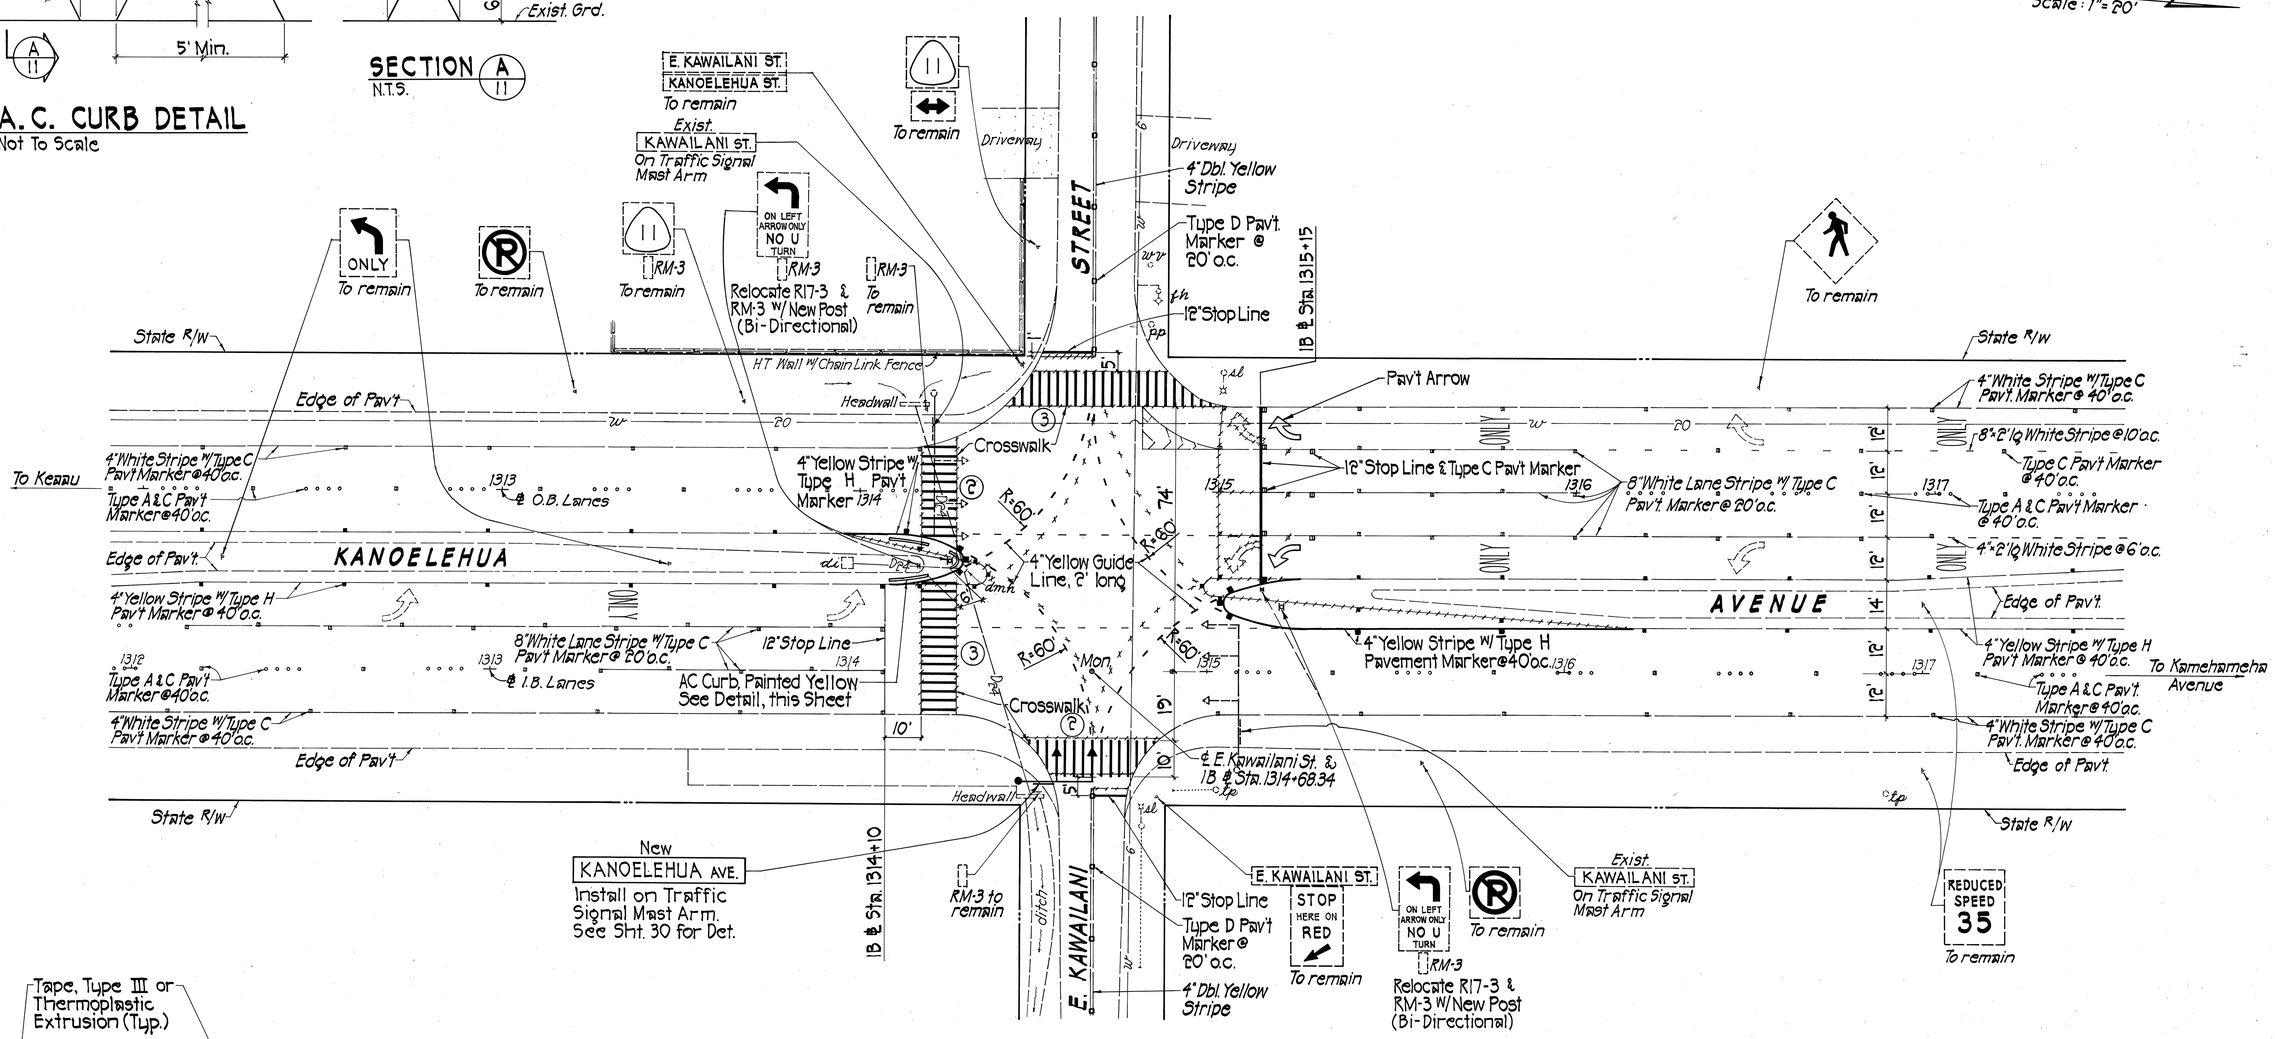

SIGNS, STRIPES & MARKERS PLAN

Scale: 1" = 20'

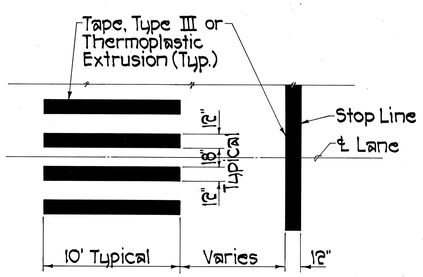

CROSSWALK STRIPING DETAIL

Not To Scale

SURVEY PLOTTED BY	
DRAWN BY	
TRACED BY	
DESIGNED BY	
QUANTITIES BY	
CHECKED BY	
DATE	
ORIGINAL PLAN	
NOTE BOOK	
No.	

HAROLD I. YOSHIZAKI
LICENSED PROFESSIONAL ENGINEER
No. 2091-C
HAWAII, U.S.A.

THIS WORK WAS PREPARED BY ME OR UNDER MY SUPERVISION.

Harold I. Yoshizaki

SHIMABUKURO, ENDO & YOSHIZAKI, INC.
1126 12th Avenue
Honolulu, Hawaii 96816

STATE OF HAWAII
DEPARTMENT OF TRANSPORTATION
HIGHWAYS DIVISION

SIGNS, STRIPES & MARKERS PLAN AT E. KAWAILANI STREET

KANOELEHUA AVENUE
TRAFFIC SIGNAL MODERNIZATION
F.A. PROJ. NO. STP-011-2(32)

SCALE: AS SHOWN DATE: OCT. 1998

SHEET No. 1 OF 1 SHEETS