FED. ROAD DIST. NO.	STATE	PROJ. NO.	FISCAL YEAR	SHEET NO.	TOTAL SHEETS
HAWAII	HAW.	11A–01–02	2003	1	30

11

INDEX TO DRAWINGS	
SHEET NO.	DESCRIPTION
1	TITLE SHEET
2	STANDARD PLANS SUMMARY
3–5	CONSTRUCTION NOTES
6	DEMOLITION PLAN
7	TYPICAL SECTION
8	ROADWAY PLAN
9	GRADING PLAN
10–13	GUARDRAIL DETAILS
14–17	STRIPING AND SIGNING PLANS
18	SIGN DETAILS
19	CONSTRUCTION SIGN PLAN
20–30	ELECTRICAL PLANS

STATE OF HAWAII

DEPARTMENT OF TRANSPORTATION

HIGHWAYS DIVISION

HONOLULU, HAWAII

"AS-BUILT"

PLANS FOR

HAWAII BELT ROAD

INTERSECTION IMPROVEMENTS AT POLICE STATION ROAD AND HUALALAI ROAD

Project No. 11A–01–02

DISTRICT OF NORTH KONA
ISLAND OF HAWAII

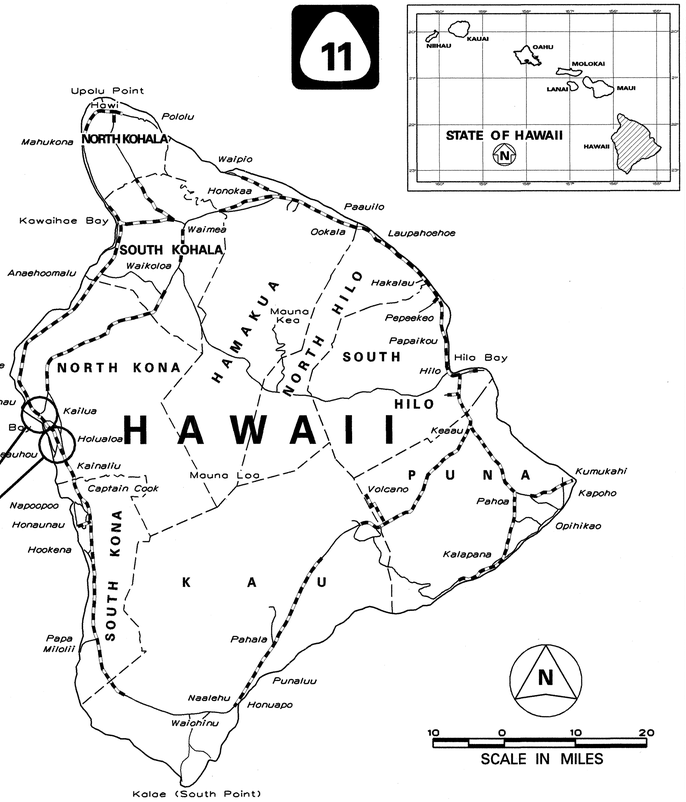

PROJECT LOCATION

FEDERAL AID PROJECTS PREVIOUSLY CONSTRUCTED OR UNDER CONSTRUCTION

POLICE STATION ACCESS ROAD — MILE POST 98.19 TO MILE POST 98.33

HUALALAI — MILE POST 120.35 TO MILE POST 120.45

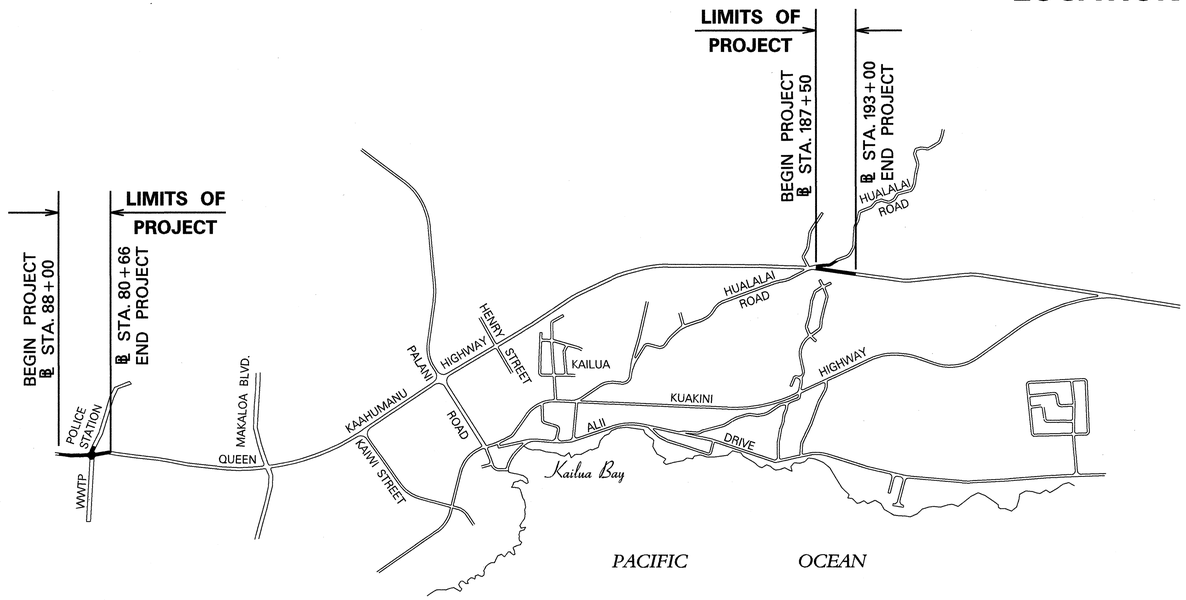

LAYOUT PLAN

GROSS LENGTH OF PROJECT..... 0.14 MILES
NET LENGTH OF PROJECT..... 0.14 MILES

GROSS LENGTH OF PROJECT..... 0.10 MILES
NET LENGTH OF PROJECT..... 0.10 MILES

N

1 0 1 2 3
SCALE IN THOUSAND FEET

CHANGES MADE DURING CONSTRUCTION HAVE BEEN INCORPORATED ON THESE PLANS EXCEPT CHANGES IN THE ORIGINAL THEORETICAL QUANTITIES. FOR ACTUAL QUANTITIES, REFER TO PROJECT LEDGER AND/OR COMPUTATION BOOK.

Charles A. Lakoh — RESIDENT ENGINEER — 8-29-05 DATE

DEPARTMENT OF TRANSPORTATION
STATE OF HAWAII

APPROVED:

for DIR. OF TRANSPORTATION — 12-12-02 DATE

FUJITA & ASSOCIATES, INC.	Christine Yamasaki	692–7572	Dec., 2002
DESIGNED BY	P. S. & E. BY	PHONE	DATE

17Ts-H.dgn