FED. ROAD DIST. NO.	STATE	PROJ. NO.	FISCAL YEAR	SHEET NO.	TOTAL SHEETS
HAWAII	HAW.	11K-01-03M	2003	1	20

11

INDEX TO DRAWINGS

SHEET NO.	DESCRIPTION
1	TITLE SHEET
2	STANDARD PLANS SUMMARY
3	GENERAL NOTES
4 – 5	WATER POLLUTION AND EROSION CONTROL NOTES
6	TYPICAL SECTION AND DETAILS
7	RECONSTRUCTION AREA SCHEDULE AND DETAILS
8 – 12	ROADWAY PLANS
13	PAVEMENT MARKING LEGEND AND NOTES
14	STRIPING AND PAVEMENT MARKING SCHEDULE AND DETAIL
15	SIGN DETAILS AND NOTES
16	SIGN SCHEDULE
17 – 18	REFLECTOR AND OBJECT MARKER SCHEDULE
19	MISCELLANEOUS SCHEDULES
20	CONSTRUCTION SIGN PLAN AND SCHEDULE

STATE OF HAWAII

DEPARTMENT OF TRANSPORTATION

HIGHWAYS DIVISION

HONOLULU, HAWAII

"AS-BUILT"

PLANS FOR

MAMALAHOA HIGHWAY RESURFACING

VICINITY OF HAWAII
VOLCANOES NATIONAL PARK

PROJECT NO. 11K-01-03M

DISTRICT OF KA'U
ISLAND OF HAWAII

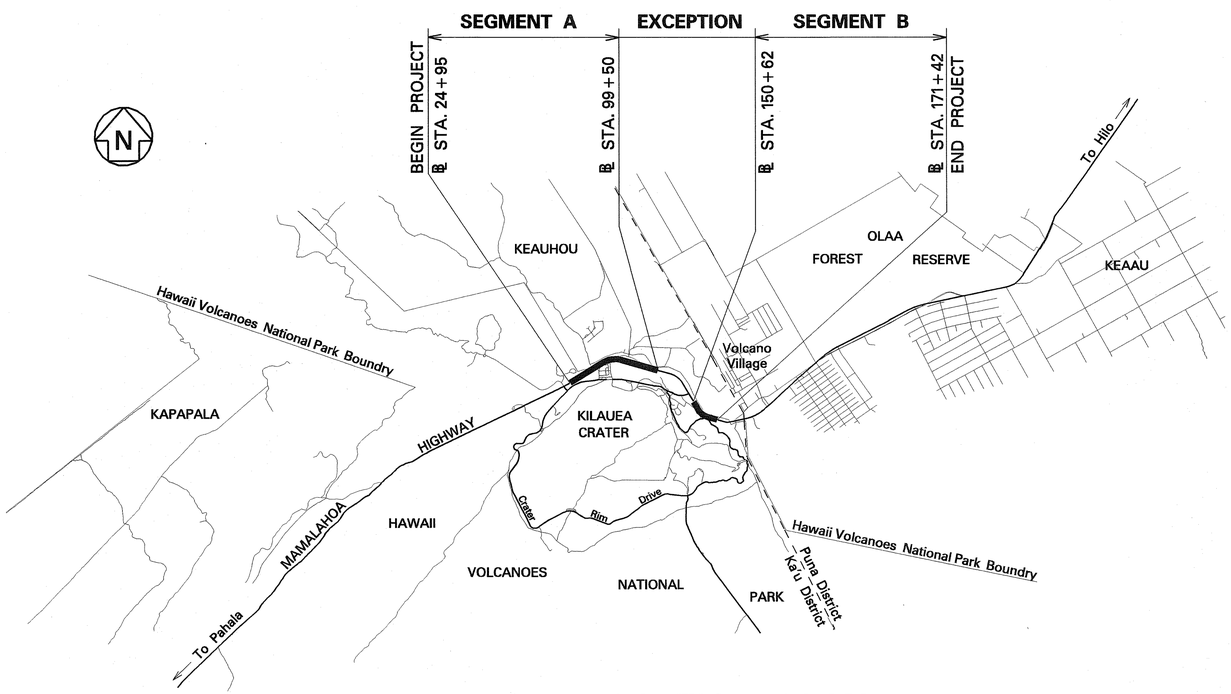

LOCATION PLAN

GROSS LENGTH OF PROJECT..... 2.89 MILES
NET LENGTH OF PROJECT..... 1.81 MILES

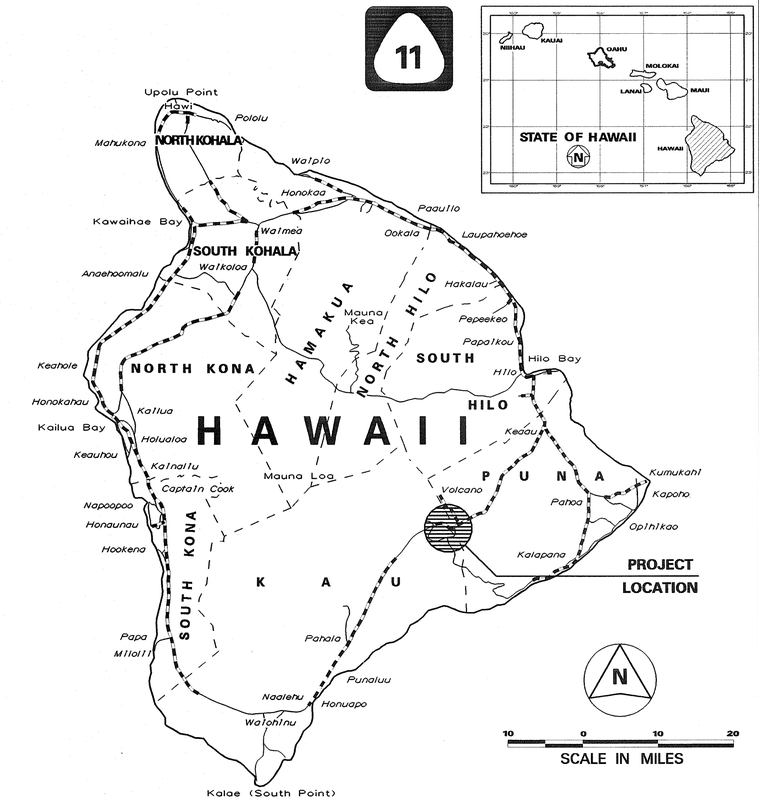

FEDERAL AID PROJECTS PREVIOUSLY CONSTRUCTED OR UNDER CONSTRUCTION

MILE POST 29.12 TO MILE POST 31.00

6 0 6 12 18
SCALE IN THOUSAND FEET

CHANGES MADE DURING CONSTRUCTION HAVE BEEN INCORPORATED ON THESE PLANS EXCEPT CHANGES IN THE ORIGINAL THEORETICAL QUANTITIES. FOR ACTUAL QUANTITIES, REFER TO PROJECT LEDGER AND/OR COMPUTATION BOOK.

Robert Yuk-Lee 10/15/08
PROJECT ENGINEER DATE

DEPARTMENT OF TRANSPORTATION
STATE OF HAWAII

APPROVED: 5/9/03
for DIR. OF TRANSPORTATION DATE

HAWAII DISTRICT DESIGNED BY
ROBERT TAIRA MANAGED BY
933-8866 PHONE
APRIL, 2003 DATE