FED. ROAD DIST. NO.	STATE	FED. AID PROJ. NO.	FISCAL YEAR	SHEET NO.	TOTAL SHEETS
HAWAII	HAW	W.P.H. 8-F	1935	1	19

INDEX TO DRAWINGS

SHEET NO.	DESCRIPTION
1	Title Sheet
2	Typical Road Sections
3-6	Plan and Profile Sheets
7-8	Standard Details Nos 1 & 2
9-10	Culvert Details
11-19	Cross Sections
	Cross Sections

TERRITORY OF HAWAII

TERRITORIAL HIGHWAY DEPARTMENT

HONOLULU - T.H.

PLANS OF

HAWAII BELT ROAD

HONAUNAU—KEEI—KAHAULOA SECTION

U. S. WORKS PROGRAM HIGHWAY PROJECT NO. W.P.H.-8-F

DISTRICT OF SOUTH KONA

ISLAND OF HAWAII

CONVENTIONAL SIGNS

- Existing Fence
- Existing Stonewall Fence
- Existing Road
- Center Line
- Culverts
- House
- Boundary Line
- Dry Rubble Masonry Walls

SCALES

PLAN		1 INCH = 100 FEET
PROFILE	HOR	1 INCH = 100 FEET
	VERT	1 INCH = 10 FEET
CROSS SECTIONS		1 INCH = 10 FEET

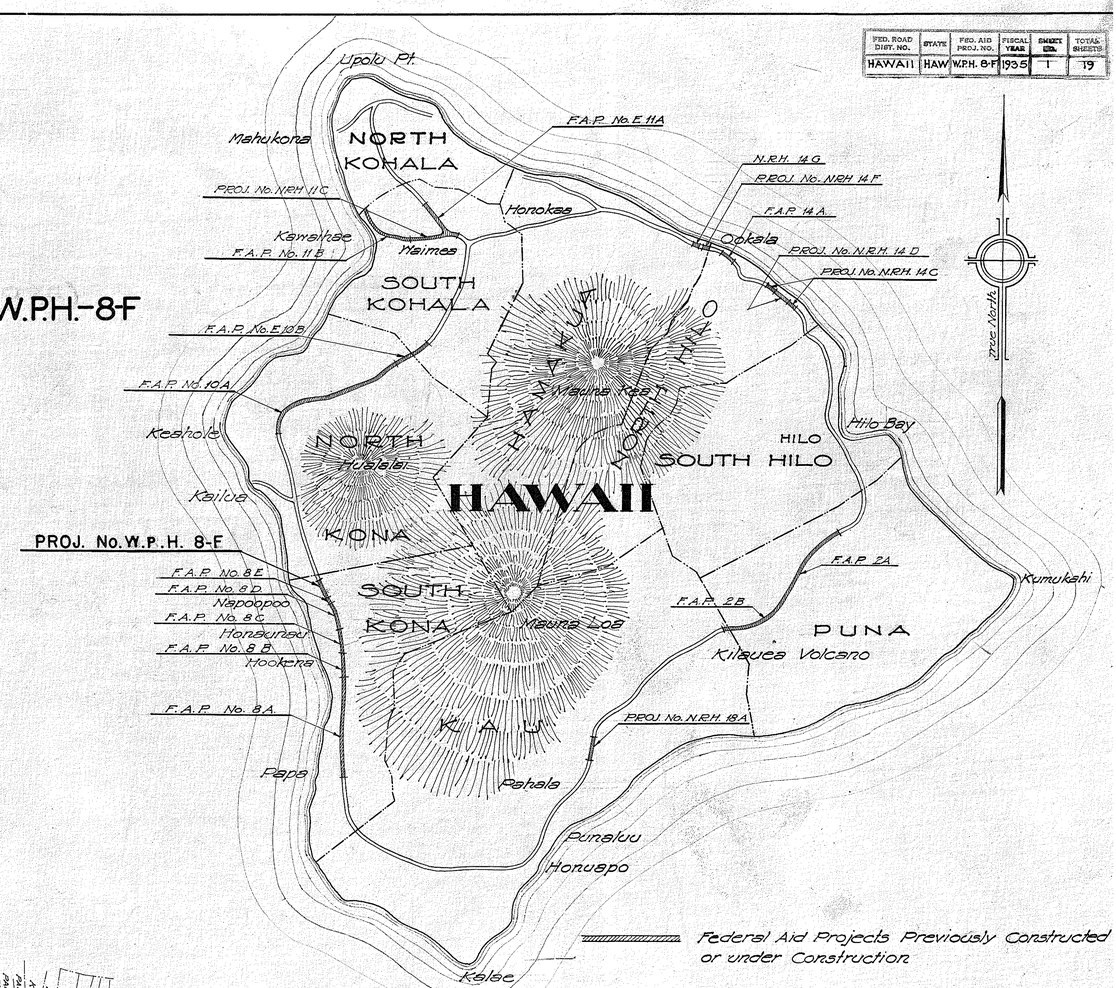

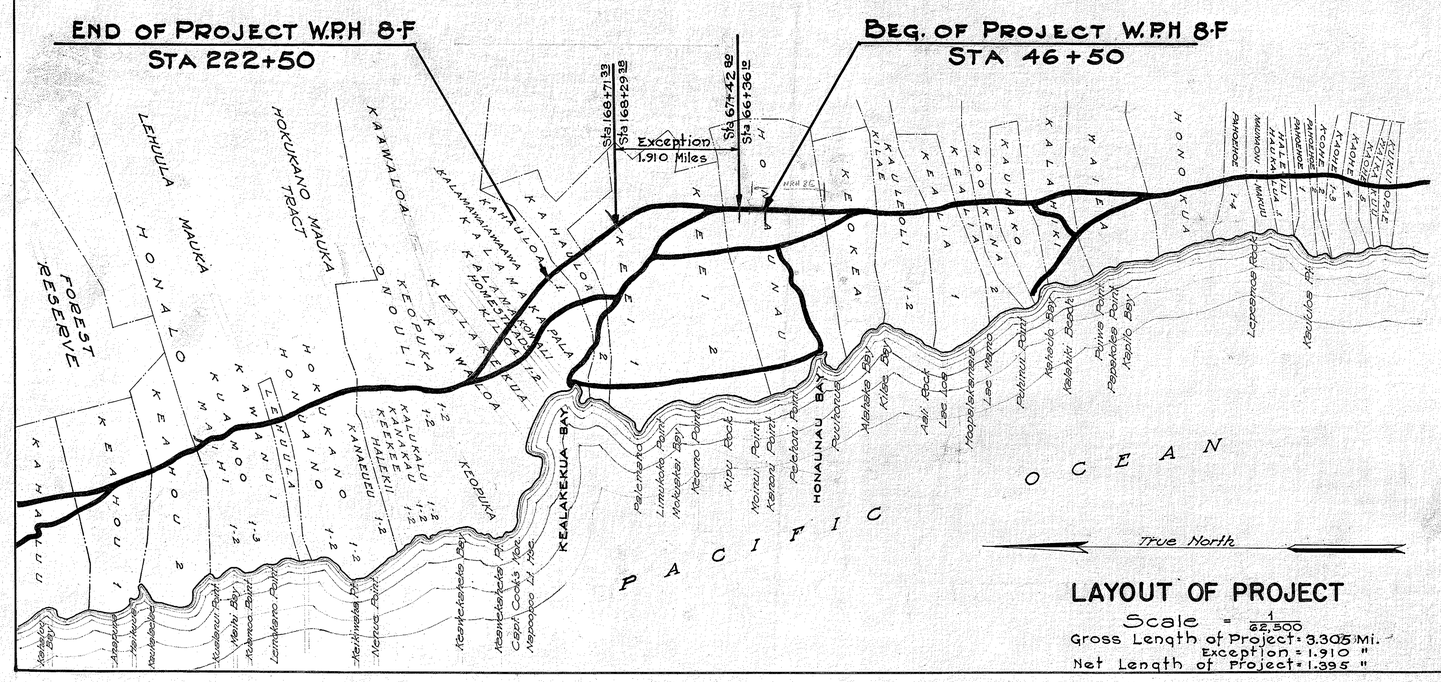

LAYOUT OF PROJECT

Scale = $\frac{1}{62,500}$

Gross Length of Project = 3.305 Mi.

Exception = 1.910 "

Net Length of Project = 1.395 "

APPROVED

Louis E. Cain

TERRITORIAL HIGHWAY ENGINEER

RECOMMENDED FOR APPROVAL

PRINCIPAL HIGHWAY ENGINEER, Bu. of Pub. Rds.

RECOMMENDED FOR APPROVAL

CHIEF ENGINEER, Bureau of Public Roads

APPROVED

CHIEF, Bureau of Public Roads

4352.1