

FED. ROAD DIST. NO.	STATE	FED. AID PROJ. NO.	FISCAL YEAR	SHEET NO.	TOTAL SHEETS
HAWAII	HAW	FAH284	1938	15	16

DATE _____ BY _____

FINAL SURVEY _____

NOTE BOOK _____

NO. _____

AREAS CHECKED _____


DATE _____ BY _____

ORIGINAL SURVEY _____

NOTE BOOK _____

NO. _____

AREAS CHECKED _____

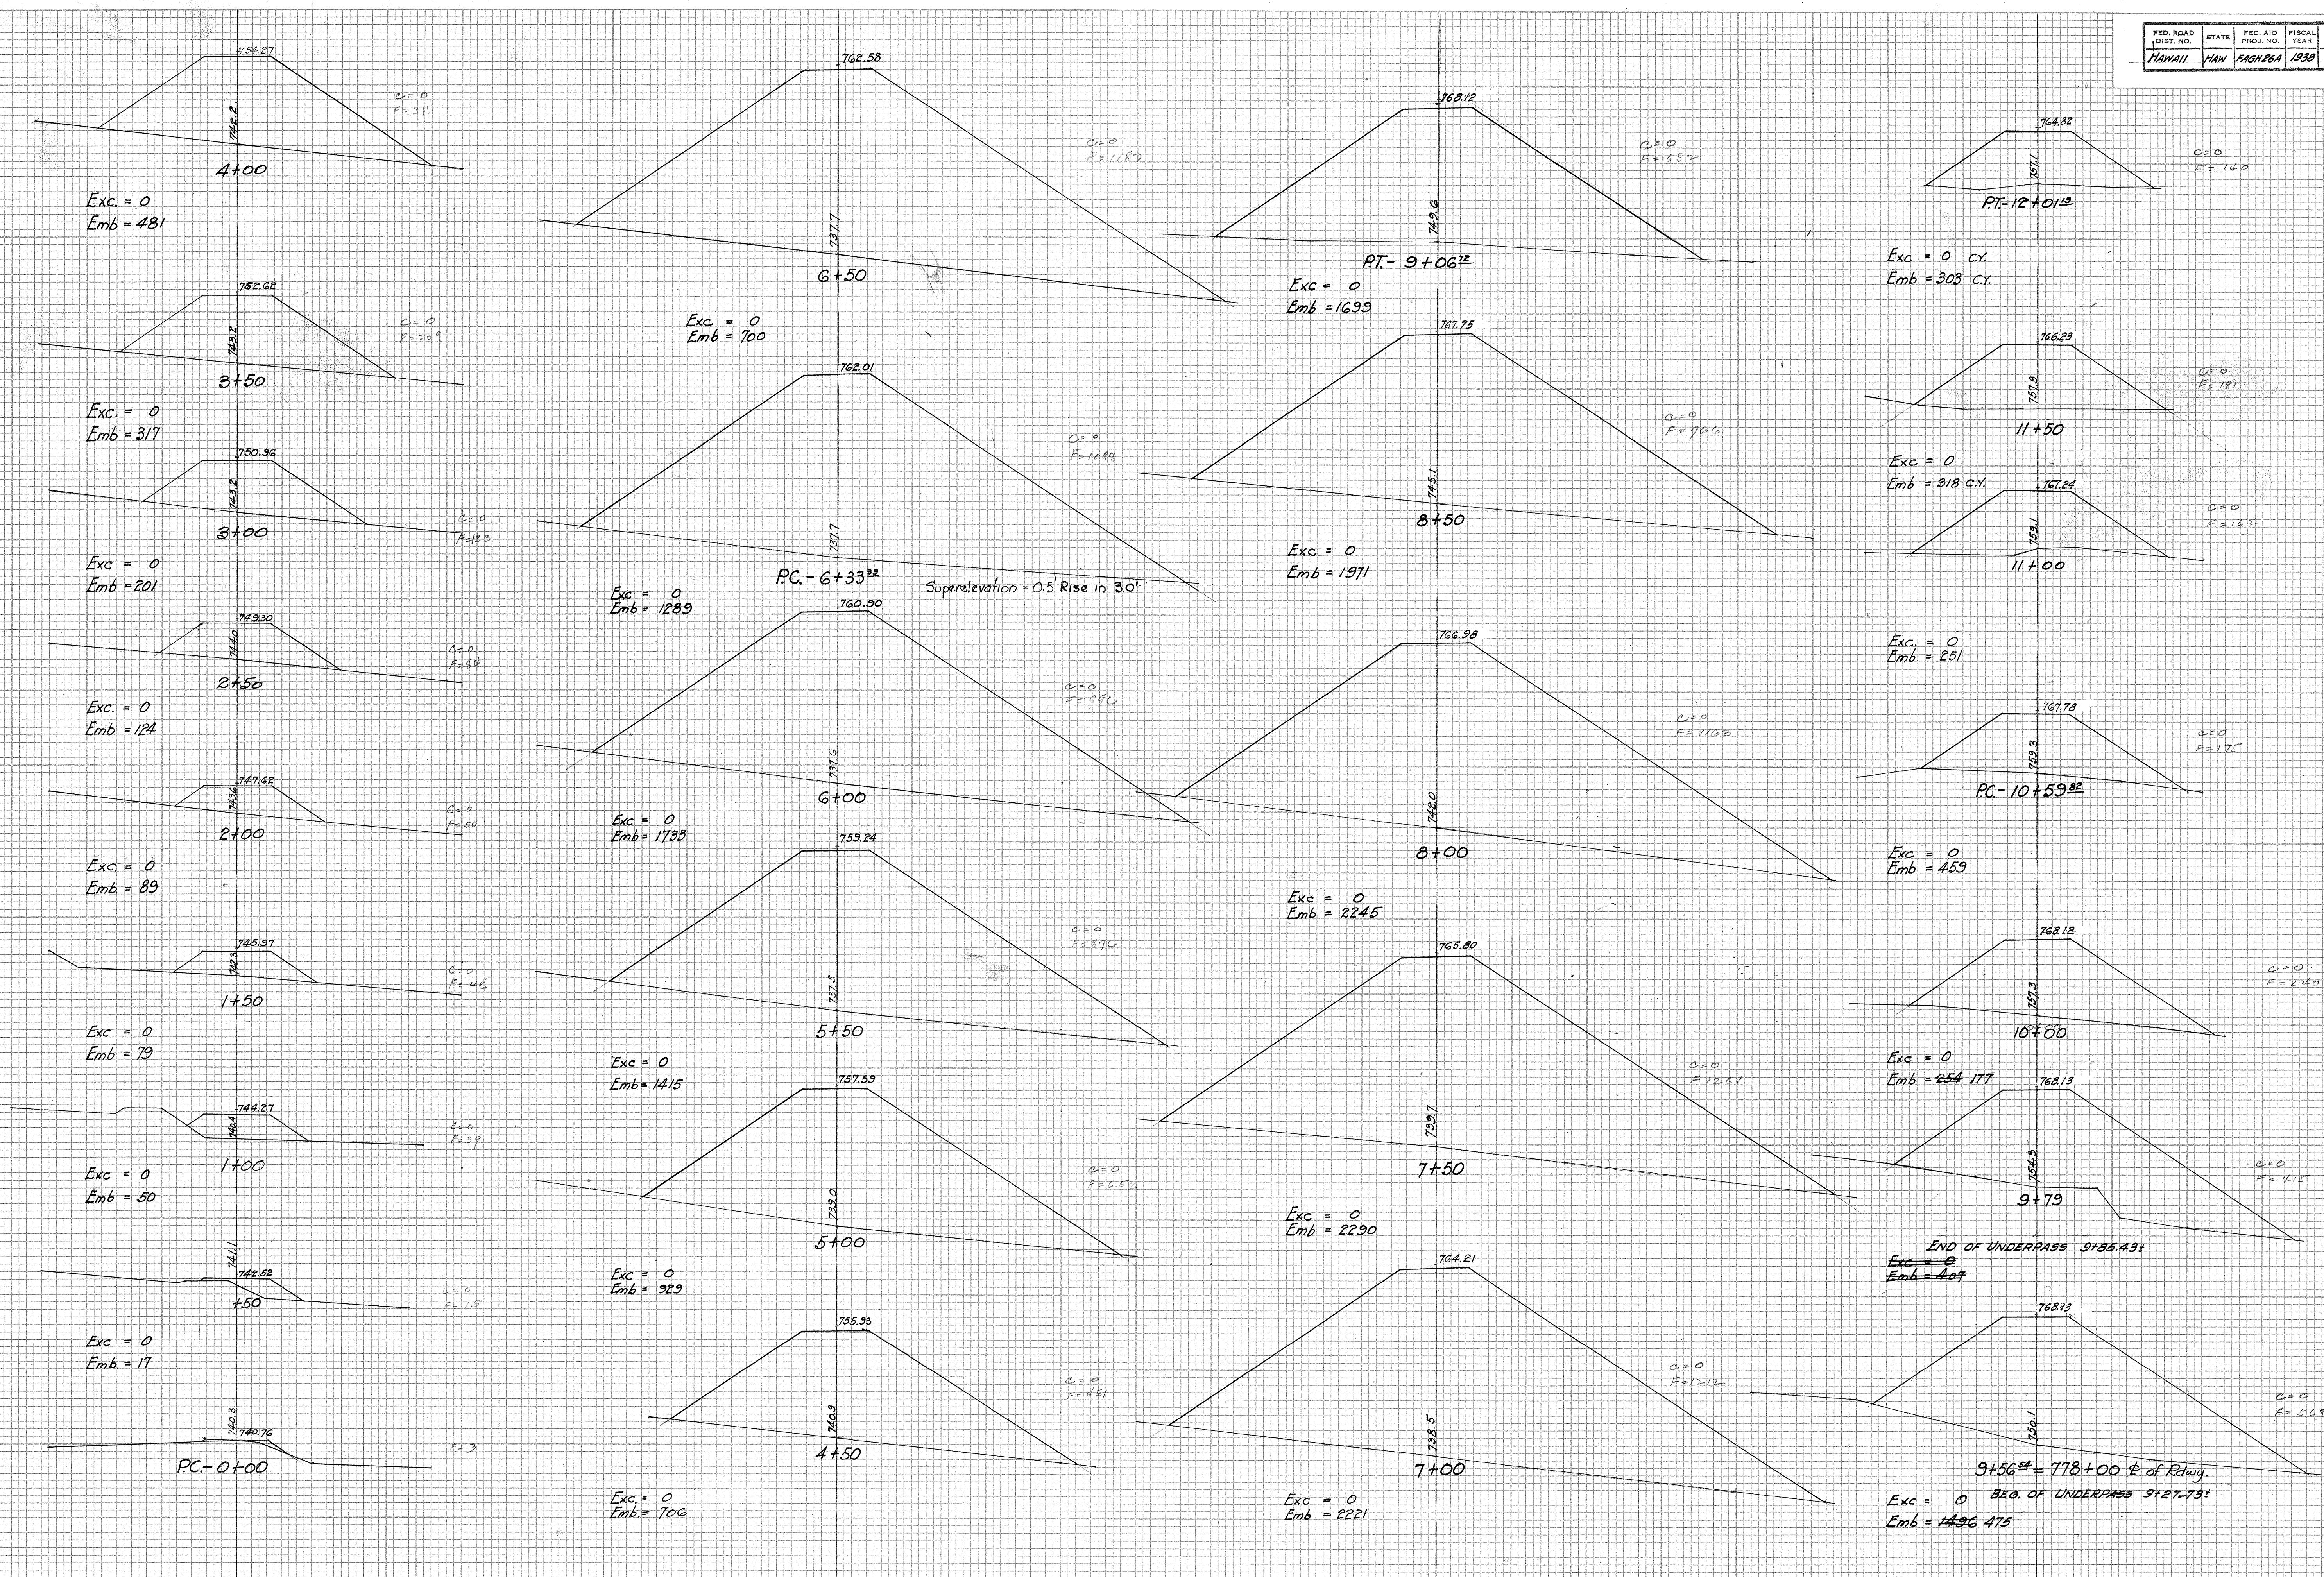

FINAL SURVEY	SURVEYED PLOTTED TEMPLATE	BY	DATE
NOTE BOOK	AREAS AREAS CHECKED		
NO.			

	SURVEYED		BY	DATE
	PLOTTED			
	TEMPLATE			
	NOTE BOOK			
	AREAS CHECKED			
	NO.			

