FED. ROAD DIST. NO.	STATE	FED AID PROJ. NO.	FISCAL YEAR	SHEET NO.	TOTAL SHEETS
HAWAII	HAW.	SDR 3(1)	1948	1	65

INDEX TO DRAWINGS

SHEET	DESCRIPTION
1	TITLE SHEET
2	TYPICAL SECTIONS & BORROW PIT
3-8	PLAN & PROFILE
9	SOIL PROFILE
10-11	INTERSECTION DETAILS
12-15	STANDARD DETAILS
16-21	BOX CULVERT DETAILS
22-28	HWY. OVERCROSSING (Conc) Sta 45+40
29-30	(Cane Flume) Sta 0+80
31-35	" " Sta 54+18
36-38	HWY. OVERCROSSING (Steel) Sta 64+62.6
39	STANDARD BRIDGE DETAILS
40-45	PUKIHAE BRIDGE
46-65	CROSS SECTIONS
8 A	CESSPOOL DETAILS
35A,B	CANE FLUME Sta 37+25

TERRITORY OF HAWAII

TERRITORIAL HIGHWAY DEPARTMENT

HONOLULU T.H.

PLANS OF

HAWAII BELT ROAD

SEISMIC WAVE DAMAGE REHABILITATION

PROJECT NO. SDR 3 (1)

DISTRICT OF SOUTH HILO — ISLAND OF HAWAII

SCALE

PLAN ---------- 1 INCH = 50 FEET

PROFILE ---------- HOR. 1 INCH = 50 FEET
VER. 1 INCH = 5 FEET

CROSS SECTIONS ---------- HOR. 1 INCH = 10 FEET
VER. 1 INCH = 10 FEET

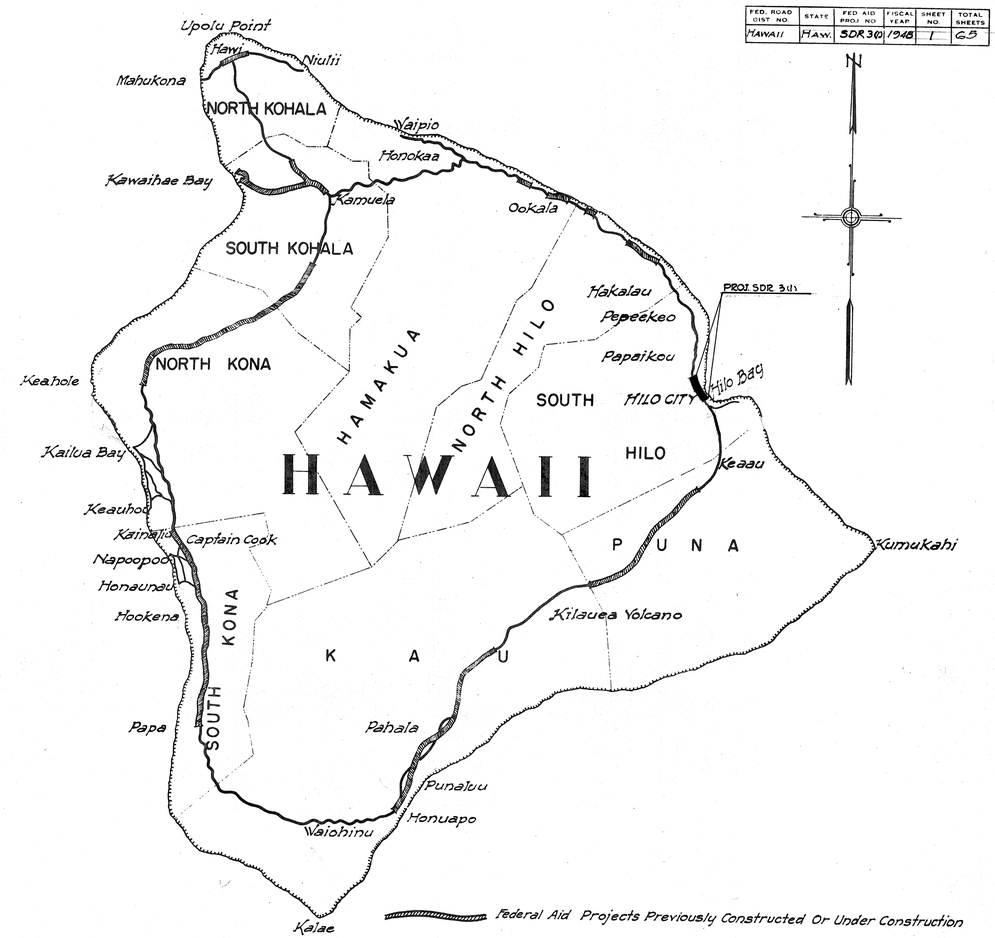

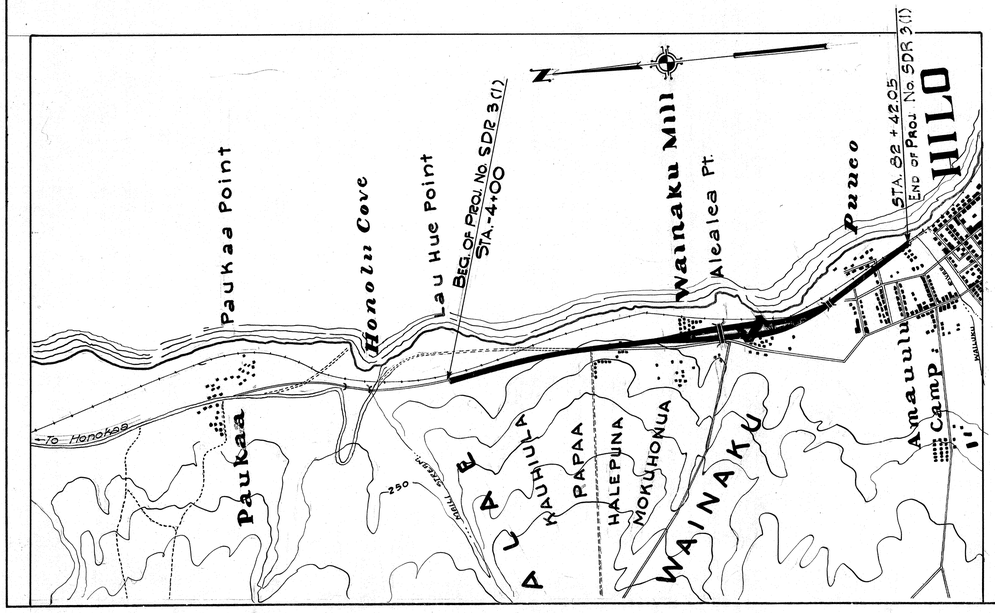

LAYOUT PLAN

Scale - 1" = 15,625

Gross Length of Project	1.637 Miles
Bridges over 20' ft. Span	0.028 Mile
Net Length of Roadway	1.609 Miles

NOTE:

ALL CHANGES MADE DURING CONSTRUCTION HAVE BEEN NOTED IN RED ON THESE TRACINGS AND CHECKED BY:

O. F. Morrison
RESIDENT ENGINEER

DATE 1/4/51

RECOMMENDED FOR APPROVAL: DATE: [redacted]

[redacted]

DISTRICT ENGINEER
PUBLIC ROADS ADMINISTRATION
FEDERAL WORKS AGENCY

APPROVED: DATE: 11-1-48

TERRITORIAL HIGHWAY ENGINEER

APPROVED: DATE: [redacted]

[redacted]

DIVISION ENGINEER
PUBLIC ROADS ADMINISTRATION
FEDERAL WORKS AGENCY

AS BUILT DATE 11-9-50

ORIGINAL PLAN		DATE
	SURVEY PLOTTED BY	"
	TRACED BY	"
	DRAWN BY	"
NOTE BOOK	TRACED BY	"
	QUANTITIES BY	"
No.	QUANTITIES CHECKED BY	"
	CHECKED BY	"

5333.1