FED. ROAD DIST. NO.	STATE	FED. AID PROJ. NO.	FISCAL YEAR	SHEET NO.	TOTAL SHEETS
HAWAII	HAW.	SDR 2(2)	1949	1	39

INDEX TO DRAWINGS

SHEET	DESCRIPTION
1	TITLE SHEET
2	TYPICAL SECTION
3-3A	MISCELLANEOUS DETAILS — SEAWALL FOR SHORE PROTECTION
4-8	PLAN & PROFILE
9	DETAILS - SEWER PUMP HOUSE
10	DETAILS - CULVERT EXTENSION AT STA. 11 ± 50
11-13	INTERSECTION DETAILS
14-18A	STANDARD DETAILS
19-39	CROSS SECTIONS
2A	LOCATION - BORROW PIT

TERRITORY OF HAWAII

TERRITORIAL HIGHWAY DEPARTMENT

HONOLULU T.H.

PLANS OF

HILO WATERFRONT HIGHWAY

SEISMIC WAVE DAMAGE REHABILITATION

PROJECT NO. SDR 2 (2)

DISTRICT OF SOUTH HILO — ISLAND OF HAWAII

SCALE

PLAN	1 INCH = 50 FT.
PROFILE HOR.	1 INCH = 50 FT.
VER.	1 INCH = 5 FT.

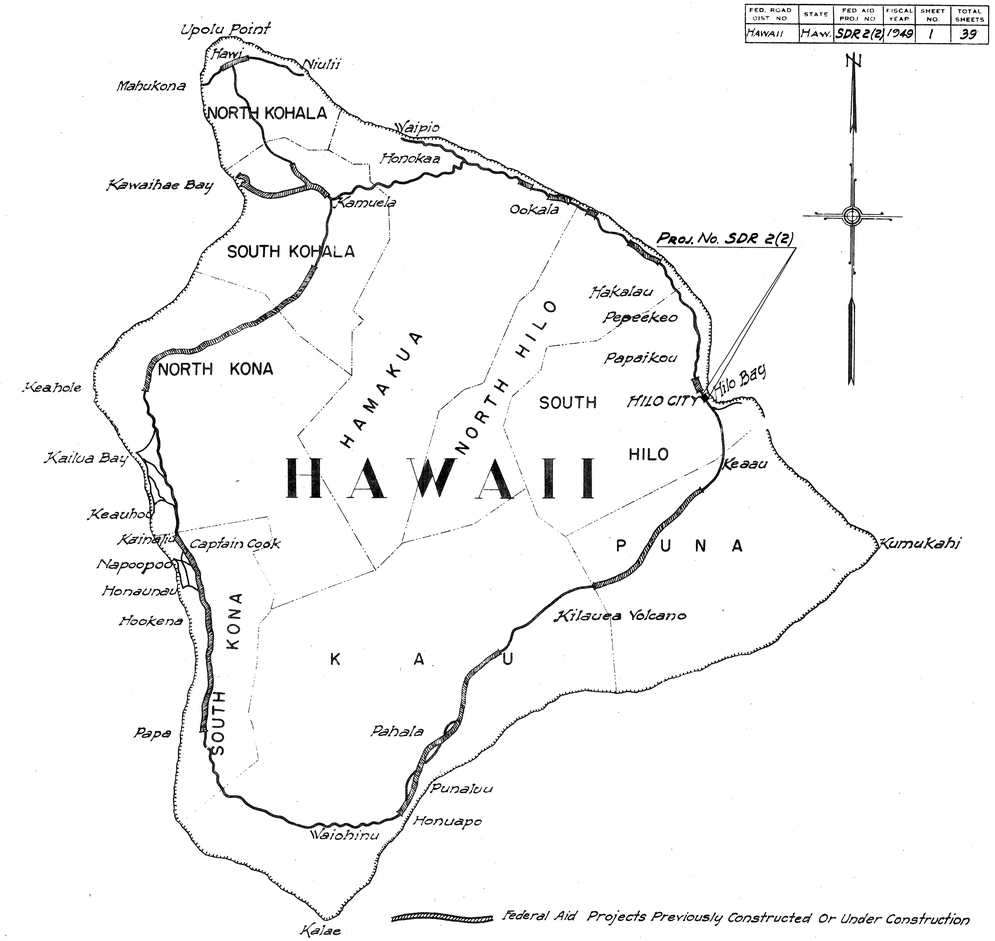

LAYOUT OF PROJECT

Scale —— 1" = 600'

Gross & Net Length of Project —— 1.136 Mile

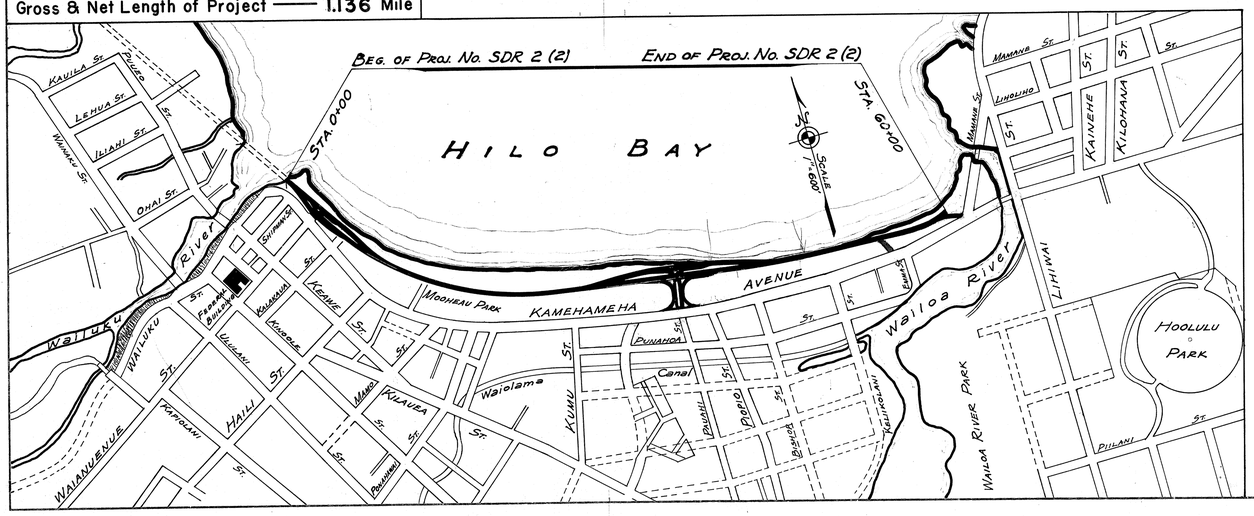

NOTE:
ALL CHANGES MADE DURING CONSTRUCTION ARE NOTED IN RED ON THESE TRACINGS AND CHECKED BY:

Resident Engineer
Jan 7 1952
Date

RECOMMENDED FOR APPROVAL: DATE:

DISTRICT ENGINEER
PUBLIC ROADS ADMINISTRATION
FEDERAL WORKS AGENCY

APPROVED: DATE: 11-17-49

TERRITORIAL HIGHWAY ENGINEER

APPROVED: DATE:

DIVISION ENGINEER
PUBLIC ROADS ADMINISTRATION
FEDERAL WORKS AGENCY

		DATE
ORIGINAL PLAN	SURVEYS PLOTTED BY	
	DESIGNED BY	
	DRAWN BY	
	TRACED BY	
NOTE BOOK	QUANTITIES BY	
	QUANTITIES CHECKED BY	
No.	CHECKED BY	

5399.1