FED. ROAD DIST. NO.	STATE	FED. AID PROJ. NO.	FISCAL YEAR	SHEET NO.	TOTAL SHEETS
HAWAII	HAW.	SDR 2(3)	1952	1	4

INDEX TO DRAWINGS

SHEET	DESCRIPTION
1	TITLE SHEET
2	TYPICAL SECTION
2	PLAN
3	STANDARD DETAIL
4	CROSS SECTION

CONVENTIONAL SIGNS

Centerline
Boundary Lines
Fences (Named)
Existing Roadways
Circular Culvert
Box Culvert
Bridge
Telephone Pole
Electric Power Pole
Water Main — W_2 — W_2 — ($W_{8, 8, 12}$, Etc)
Storm Drain — SD_{12} — SD_{12} — ($SD_{18, 24}$, Etc)
Concrete Drop Intake
Standard Catch Basin
Standard Manhole
Sewer Manhole — S_8 — S_8 — S_{12}
Telephone Manhole
Fire Hydrant
Tree (Large, named)
Railroad

TERRITORY OF HAWAII

TERRITORIAL HIGHWAY DEPARTMENT

HONOLULU T.H.

PLANS OF

HILO WATERFRONT HIGHWAY (EROSION CONTROL)

SEISMIC WAVE DAMAGE REHABILITATION

PROJECT NO. SDR 2(3)

DISTRICT OF SOUTH HILO ISLAND OF HAWAII

SCALES

PLAN ---------- 1 INCH = 50 FT.
CROSS SECTIONS ---------- 1 INCH = 10 FT.

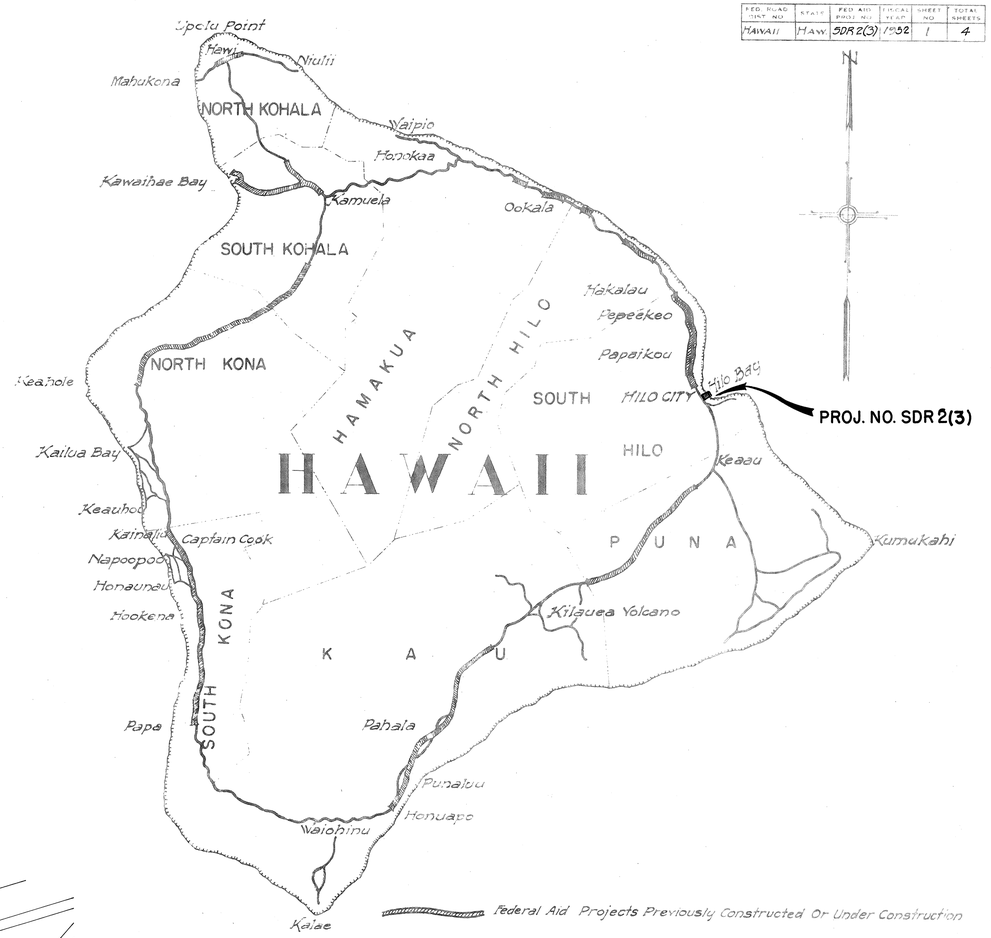

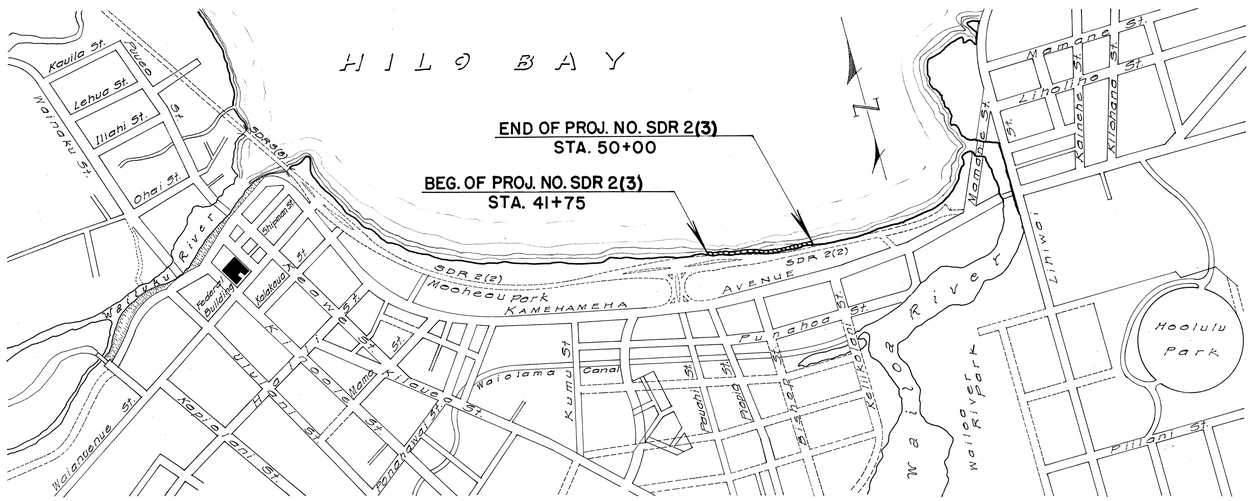

LAYOUT OF PROJECT
Scale 1" = 600'

NOTE:
All changes made during construction have been noted in red on these tracings and checked by:

Edward A. Kaaua
District Engineer
8/26/52
Date

APPROVED: DATE 4-2-52
TERRITORIAL HIGHWAY ENGINEER

DEPARTMENT OF COMMERCE
BUREAU OF PUBLIC ROADS
RECOMMENDED FOR APPROVAL:
DISTRICT ENGINEER — DATE
APPROVED:
DIVISION ENGINEER — DATE

ORIGINAL SURVEY PLOTTED BY
TRACING PREPARED BY
PLANS DRAWN BY
NOTE BOOK DRAWING CHECKED BY
QUANTITIES COMPUTED BY
QUANTITIES CHECKED BY
DATE

5594.1