FED. ROAD DIST. NO.	STATE	FED. AID PROJ. NO.	FISCAL YEAR	SHEET NO.	TOTAL SHEETS
HAWAII	HAW.	F 019-2(2)	1956	1	30

INDEX TO DRAWINGS

SHEET	DESCRIPTION
1	TITLE SHEET
2	TYPICAL SECTION
3	SOIL PROFILE
4-5	BORROW PIT & WASTE AREA
6-8	PLAN & PROFILE
9-11	INTERSECTIONS & CONC. STEPS DETAILS
12	WATER PIPE RELOCATION
13-17	CULVERT DETAILS
18-30A	KAULA BRIDGE
31-37	HIGHWAY SEPARATION
38-50	CROSS SECTIONS
50A-50C	SIDE ROAD APPROACHES
50D-50G	CROSS SECTIONS FOR SIDE ROADS

TERRITORY OF HAWAII

TERRITORIAL HIGHWAY DEPARTMENT

HONOLULU T.H.

PLANS OF

HAWAII BELT ROAD

FEDERAL AID PROJECT NO. F 019-2(2)

DISTRICTS OF NORTH HILO & HAMAKUA

ISLAND OF HAWAII

SCALES

PLAN		1 INCH = 100 FT.
PROFILE	HOR.	1 INCH = 100 FT.
	VER.	1 INCH = 10 FT.
CROSS SECTION	HOR.	1 INCH = 10 FT.
	VER.	1 INCH = 10 FT.

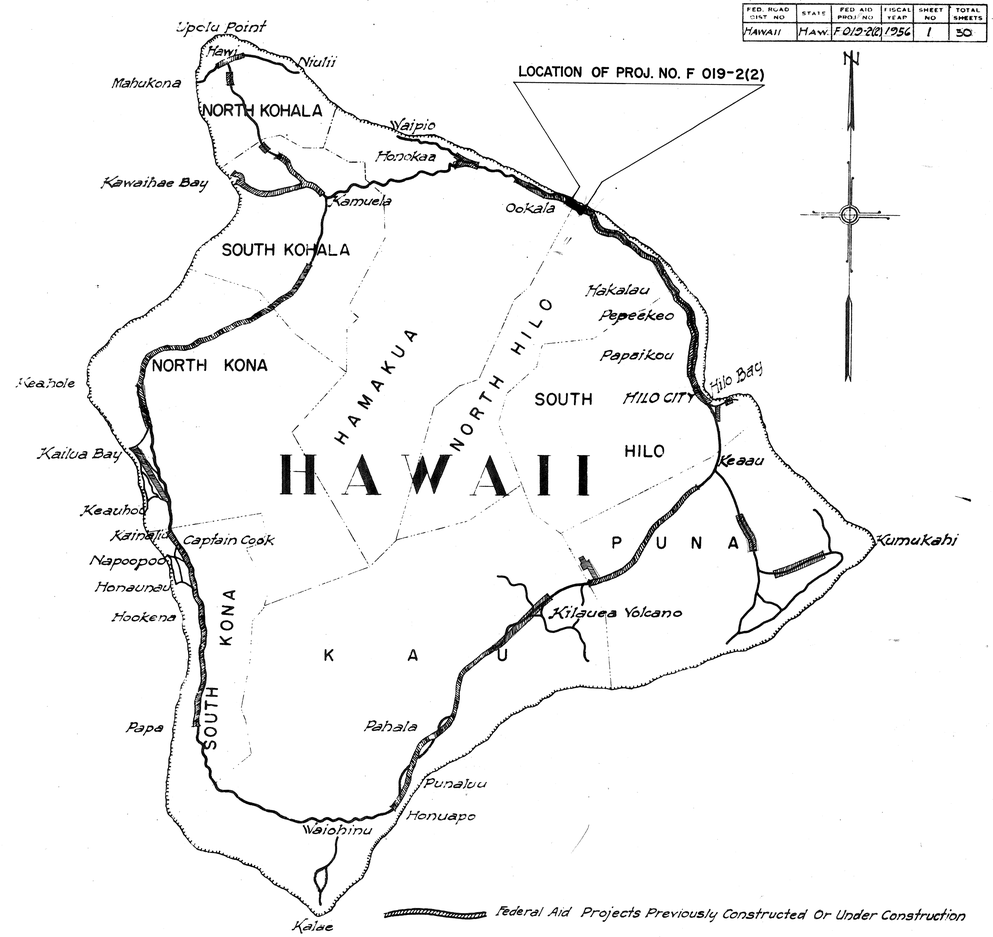

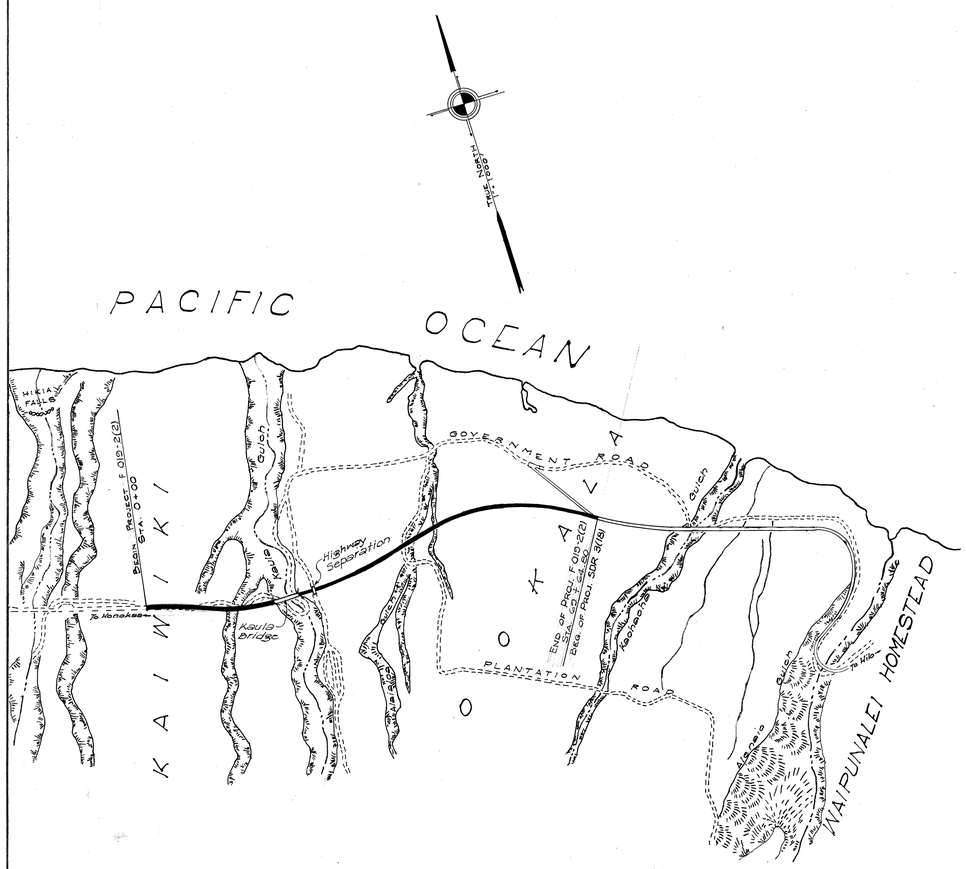

GROSS LENGTH OF PROJECT..... 1.319 mi.
BRIDGES OVER 20'-0" SPAN ..... 0.068 mi
NET LENGTH OF ROADWAY..... 1.251 mi.

"AS BUILT" PLANS

NOTE: ALL CHANGES MADE DURING CONSTRUCTION HAVE BEEN NOTED IN RED ON THESE TRACINGS AND CHECKED BY:

T. Harano
Acting DISTRICT ENGINEER

5/8/57
DATE

APPROVED: DATE June 24, 1957

W. M. Wachter
TERRITORIAL HIGHWAY ENGINEER

DEPARTMENT OF COMMERCE
BUREAU OF PUBLIC ROADS

APPROVED:

DIVISION ENGINEER DATE

ORIGINAL PLAN		DATE
	SURVEY PLOTTED BY	
	DESIGNED BY	
	DRAWN BY	
	TRACED BY	
NOTE BOOK	QUANTITIES BY	
	QUANTITIES CHECKED BY	
	CHECKED BY	
No.		

5907.1