FED. ROAD DIST. No.	STATE	FED. AID PROJ. No.	FISCAL YEAR	SHEET No.	TOTAL SHEETS
HAWAII	HAW	DF-019-2(5)	1958	11	85

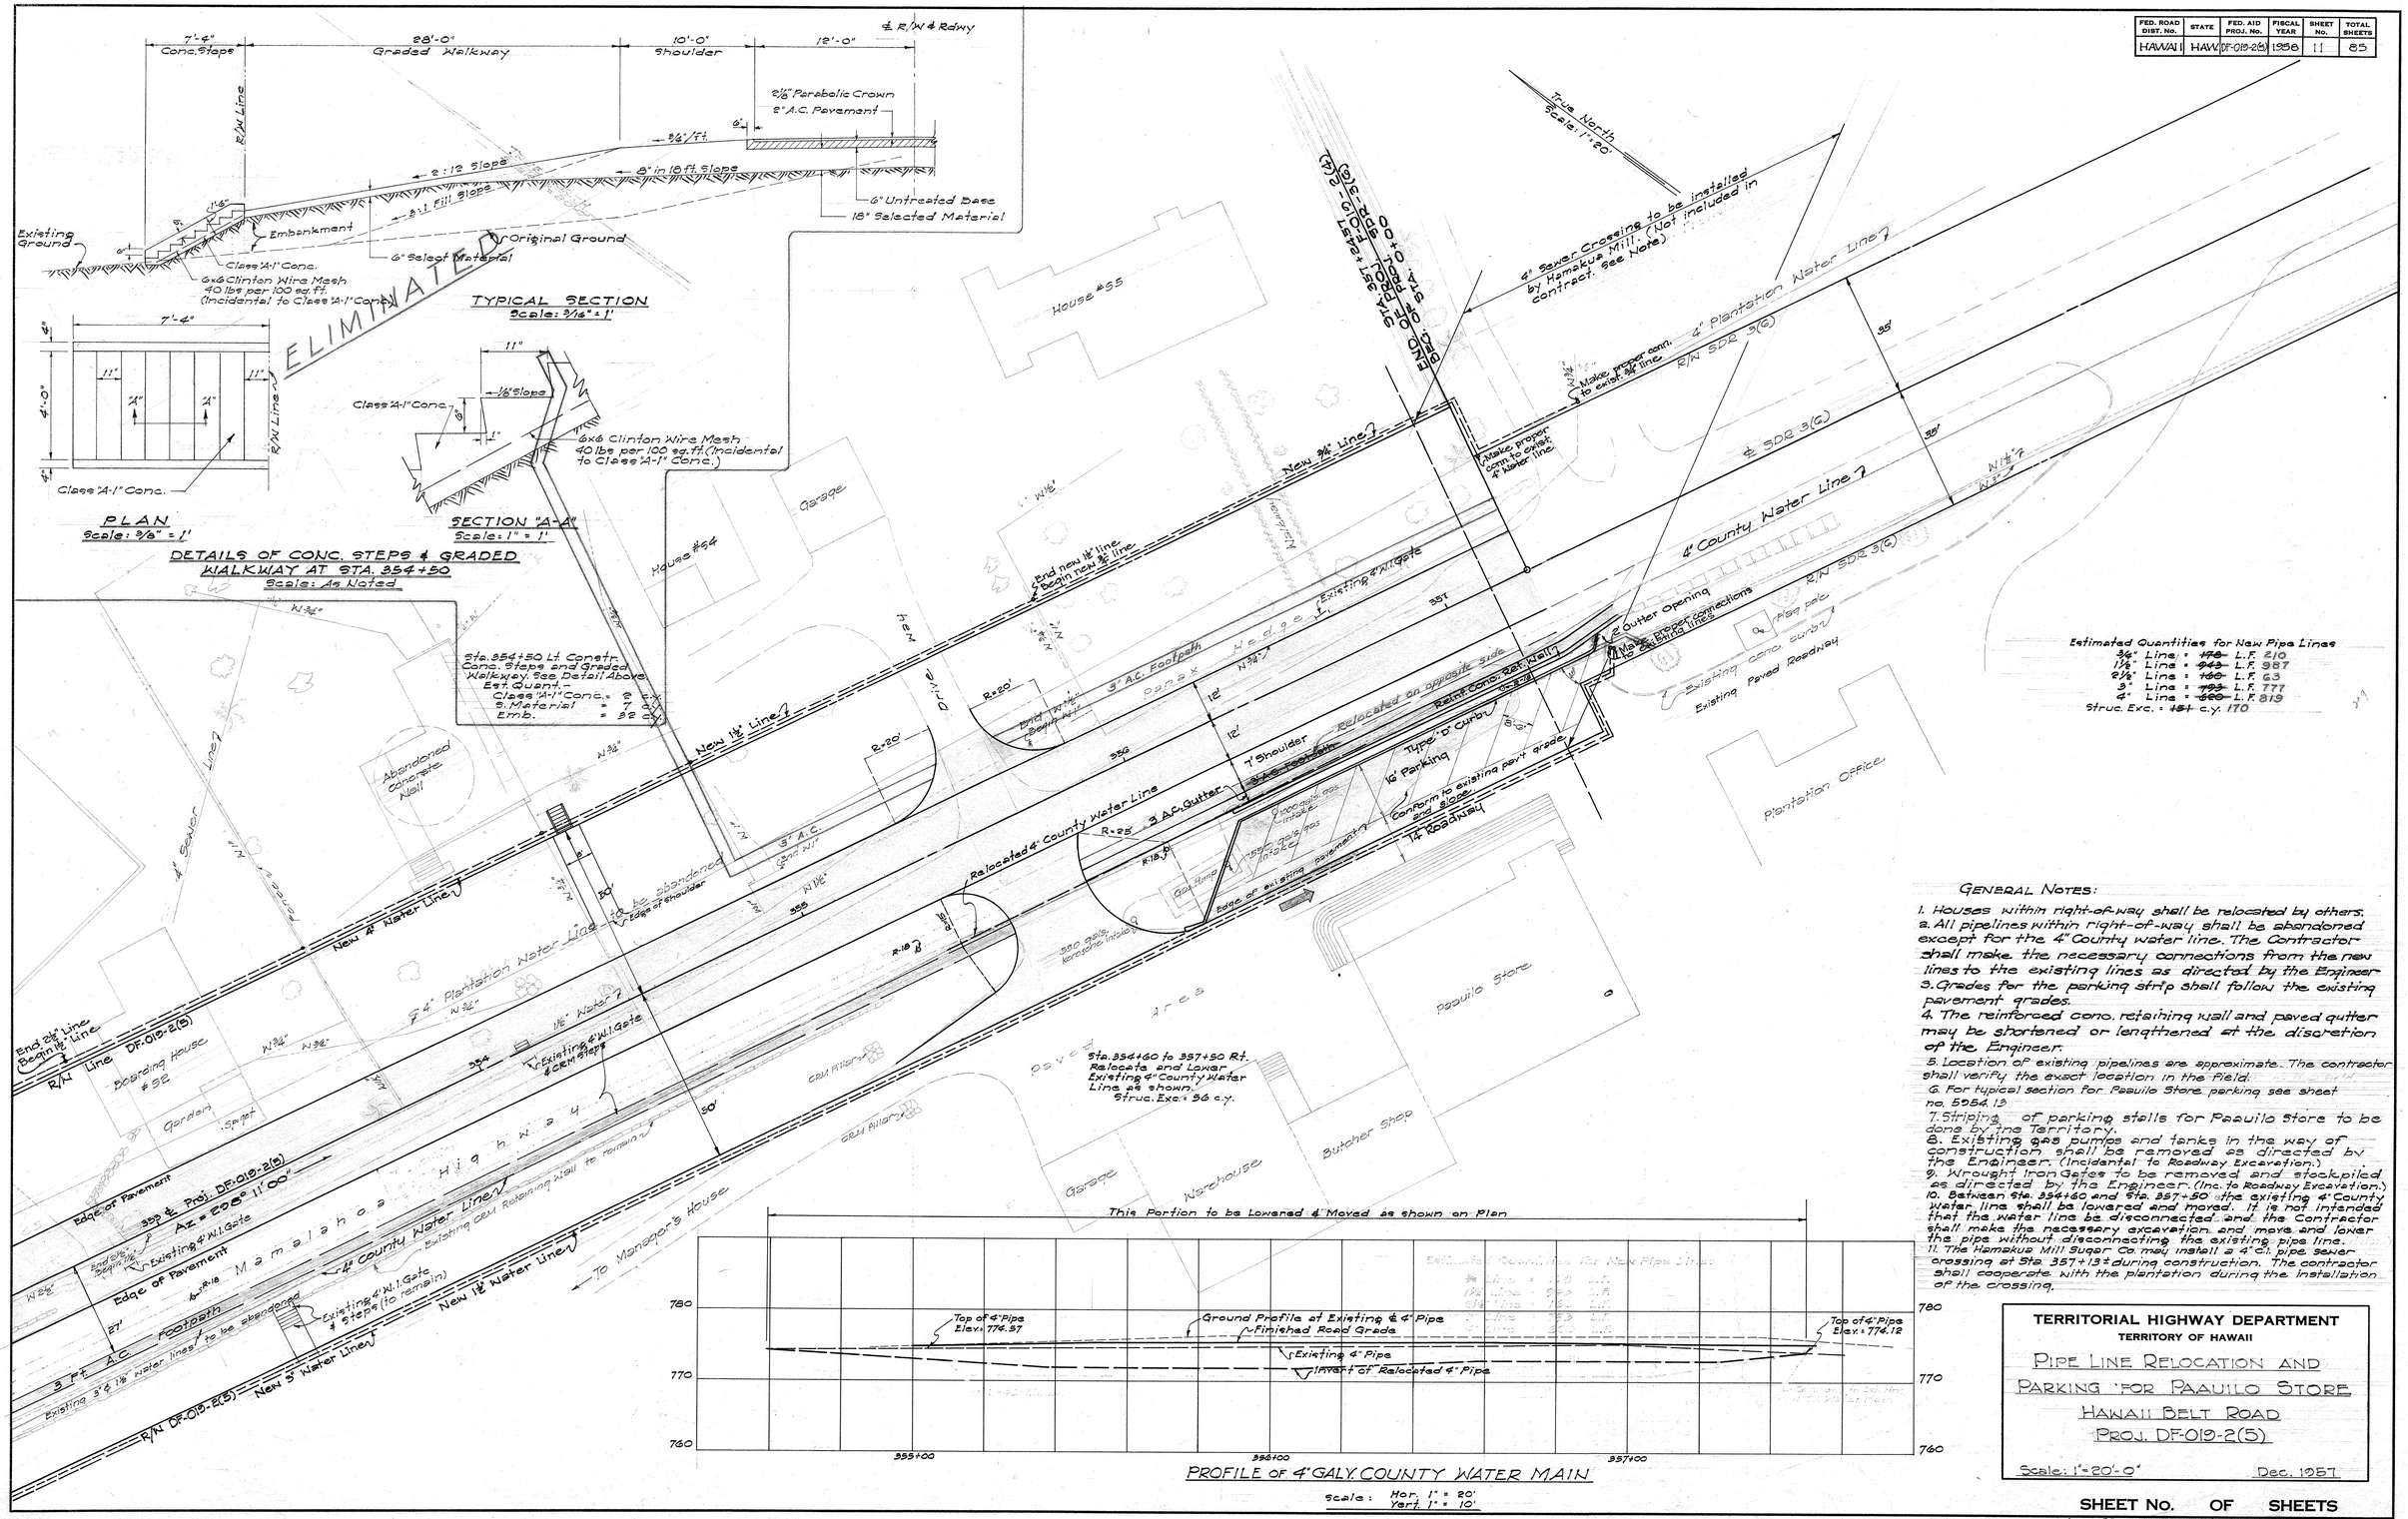

SHEET No. OF SHEETS

5954.11

PRINTED ON DIEPO 1000H CLEARPRINT