FED. ROAD DIST. NO.	STATE	FED. AID PROJ. NO.	FISCAL YEAR	SHEET NO.	TOTAL SHEETS
HAWAII	HAW.	F-019-1(1) Unit 2	1961	1	127

INDEX TO DRAWINGS

SHEET	DESCRIPTION
1	TITLE SHEET
2	TYPICAL SECTION
3	BORROW PIT SITES
4-20	PLAN AND PROFILE
21-22	DETAIL PLAN OF CONNECTIONS
23	DETAIL OF SPECIAL HEADWALL
24-29	NIENIE BRIDGE
30-31	DETAIL OF DITCH COVERS
32-42	DETAIL OF CONCRETE BOX CULVERTS
43-51	STANDARD DETAILS
52-127	CROSS SECTIONS

STATE OF HAWAII
DEPARTMENT OF TRANSPORTATION
HIGHWAYS DIVISION

"AS BUILT" PLANS OF

HAWAII BELT ROAD

FEDERAL AID PROJECT NO. F-019-1(1)
UNIT 2

DISTRICTS OF SOUTH KOHALA & HAMAKUA

ISLAND OF HAWAII

SCALES

PLAN ..... 1 INCH = 100 FT.
PROFILE ..... HOR. 1 INCH = 100 FT.
VER. 1 INCH = 10 FT.
CROSS SECTION ..... HOR. 1 INCH = 10 FT.
VER. 1 INCH = 10 FT.

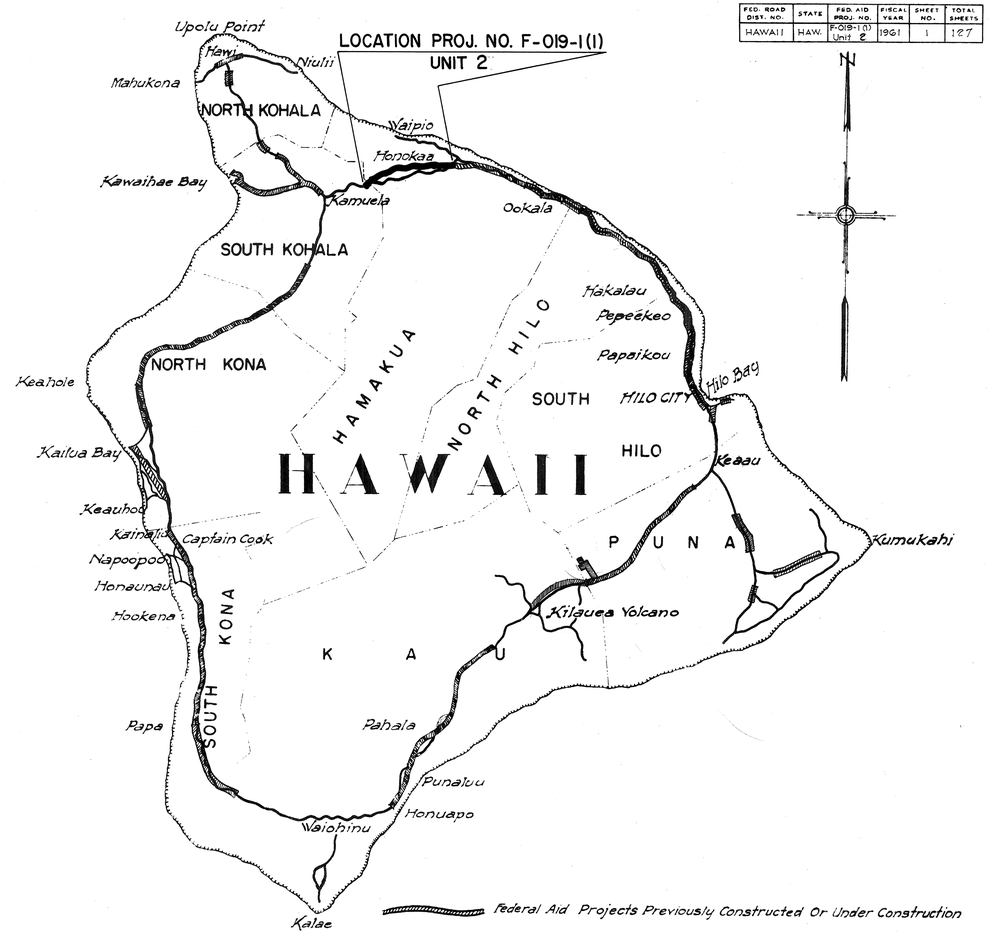

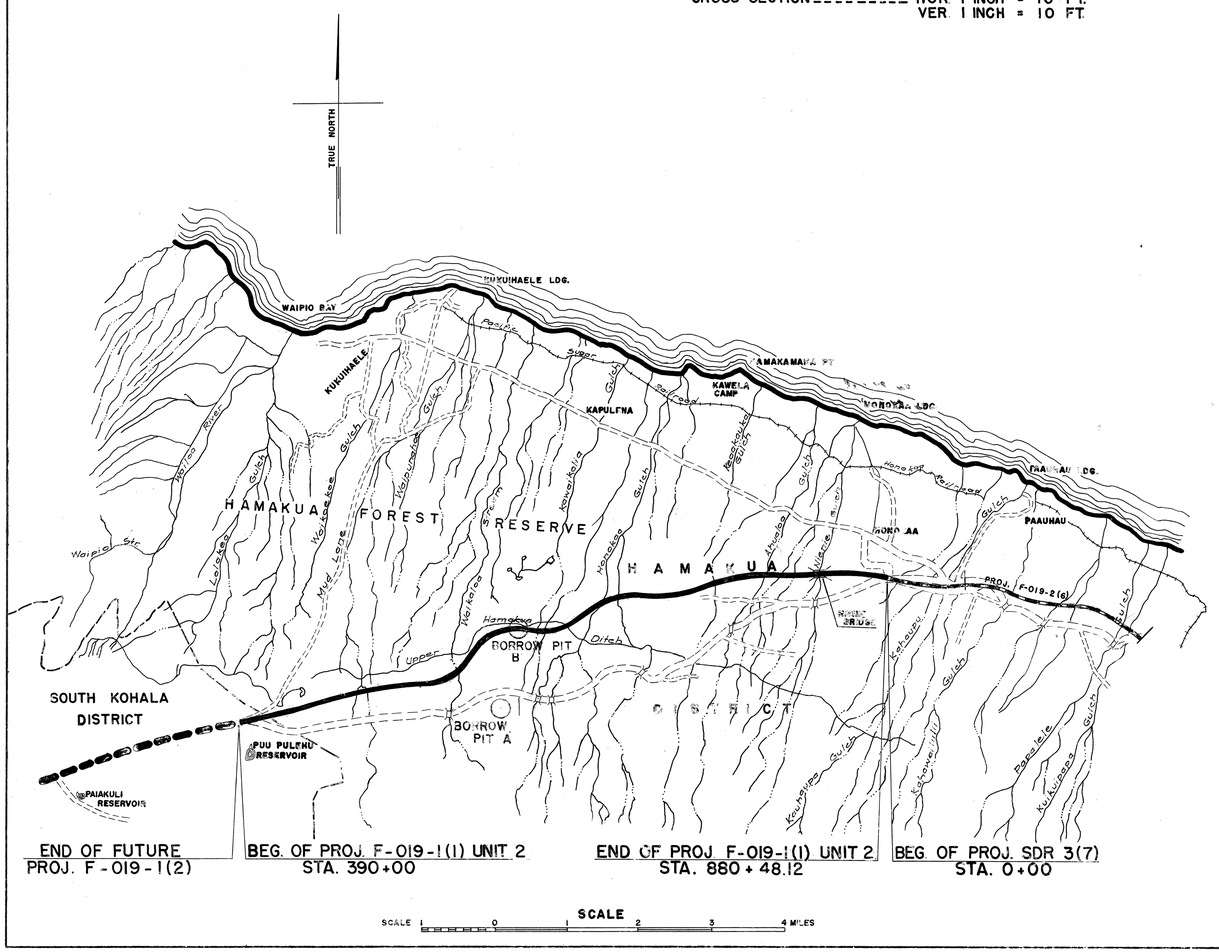

DESIGN CLASSIFICATION

ADT (1961) 900
DESIGN ADT 2,900
DHV 11%
D 60/40
T 14%
V ..... 60 M.P.H.

ROADWAY 9.246
BRIDGES 0.043
GROSS LENGTH OF PROJECT ..... 9.289 MILES

NOTE:
ALL CHANGES MADE DURING CONSTRUCTION HAVE BEEN NOTED IN RED ON THESE TRACINGS AND CHECKED BY:

RESIDENT ENGINEER
Feb 16, 1966
DATE

APPROVED: DATE 8/21/61
DIRECTOR OF TRANSPORTATION

DEPARTMENT OF COMMERCE
BUREAU OF PUBLIC ROADS
APPROVED:
[redacted]
DIVISION ENGINEER DATE

ORIGINAL PLAN | SURVEY PLOTTED BY | DESIGNED BY | DRAWN BY | TRACED BY | QUANTITIES BY | CHECKED BY | NOTE BOOK | DATE

F019 1 0102.1