INDEX TO DRAWINGS	
SHEET	DESCRIPTION
1	TITLE SHEET
2	PED. OVERPASS @ PAAUILO
3	PED. OVERPASS @ PAPAALOA
4	COLUMN & FT'G. SCHEDULE
4-6	TYPICAL DETAILS

STATE OF HAWAII

DEPARTMENT OF TRANSPORTATION

HIGHWAYS DIVISION

"AS BUILT" PLANS OF

PEDESTRIAN OVERPASSES ON HAWAII BELT ROAD

AT PAAUILO – PROJECT NO. G-19-01-63
DISTRICT OF HAMAKUA

AT PAPAALOA – PROJECT NO. H-19-01-63
DISTRICT OF NORTH HILO

ISLAND OF HAWAII

FED. ROAD DIST. NO.	STATE	FED. AID PROJ. NO.	FISCAL YEAR	SHEET NO.	TOTAL SHEETS
HAWAII	HAW.	G-19-01-63 H-19-01-63	1963		

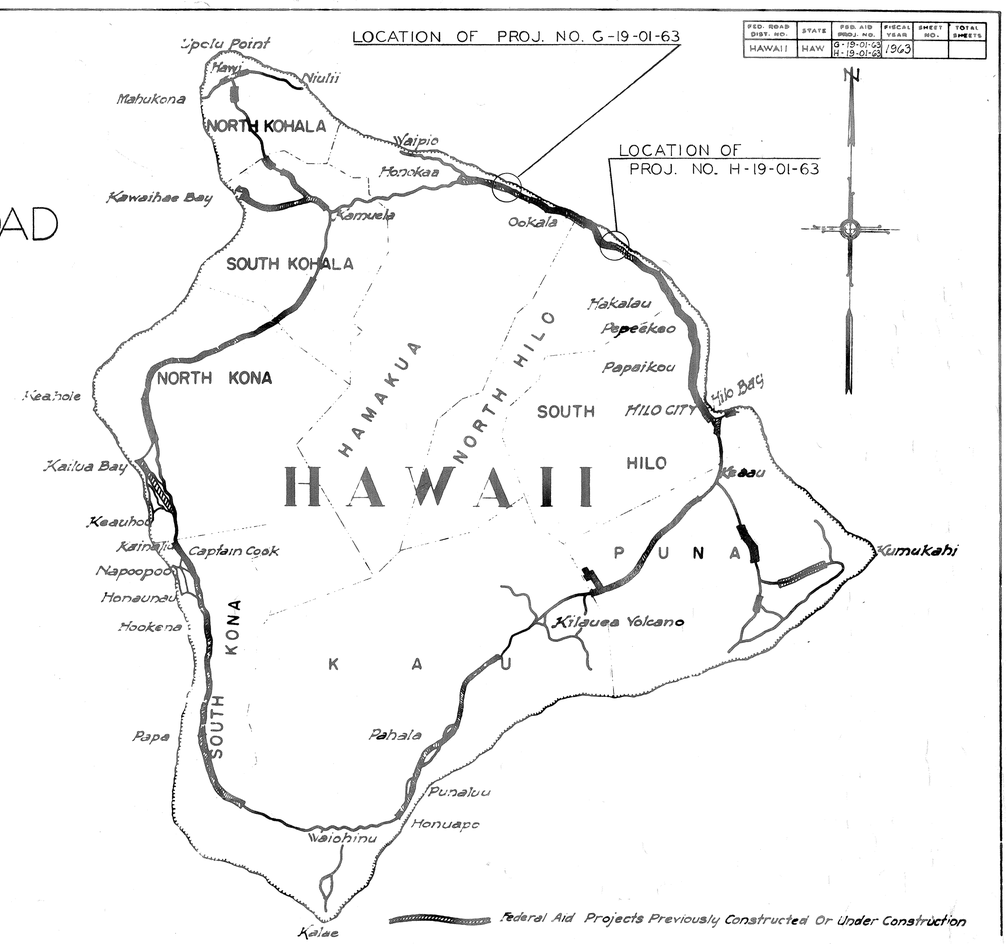

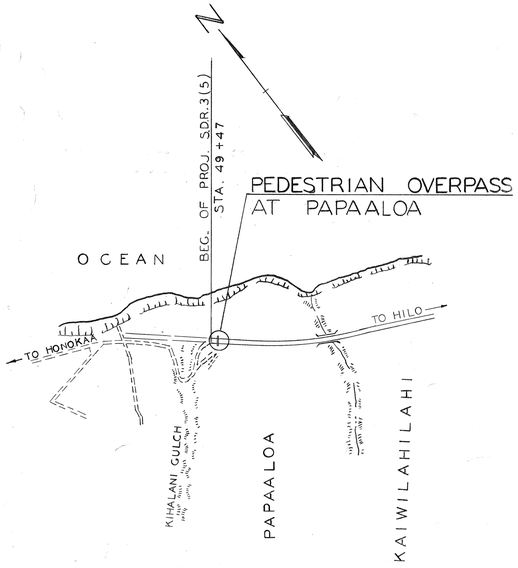

LOCATION PLAN
SCALE: 1" = 1000'

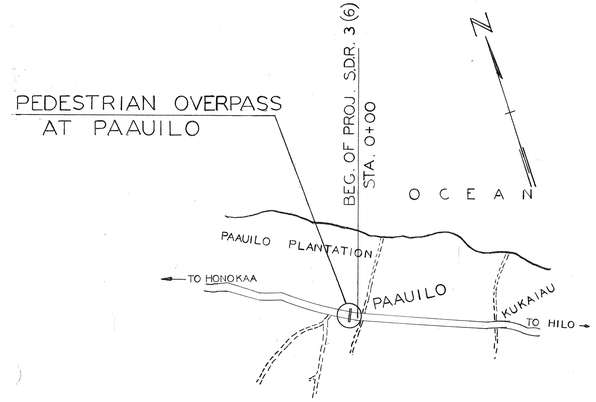

LOCATION PLAN
SCALE: 1" = 1000'

NOTE: ALL CHANGES MADE DURING CONSTRUCTION ARE SHOWN IN RED ON THESE TRACINGS AND CHECKED BY

Ataru Nishiki
PROJECT ENGINEER

July 9, 1964
DATE

APPROVED: DATE 5/24/63

Jujiro Matsuda
DIRECTOR OF TRANSPORTATION

ORIGINAL PLAN	SURVEY PLOTTED BY	DATE
	DESIGNED BY	
	DRAWN BY	
	TRACED BY	
NOTE BOOK	QUANTITIES BY	
No.	QUANTITIES CHECKED BY	
	CHECKED BY	

SHEET No. 1 OF 6 SHEETS

G 0 0 1 9 0 1 6 3 . 1 H 0 0 1 9 0 1 6 3 . 1

1