INDEX TO DRAWINGS	
SHEET	DESCRIPTION

STATE OF HAWAII

DEPARTMENT OF TRANSPORTATION

"AS BUILT" PLANS OF

EXTENSION OF PEDESTRIAN OVERPASS ON
HAWAII BELT ROAD
AT PAPAALOA - PROJECT Nº H-19-01-66
DISTRICT OF NORTH HILO
ISLAND OF HAWAII

FED. ROAD DIST. NO.	STATE	FED. AID PROJ. NO.	FISCAL YEAR	SHEET NO.	TOTAL SHEETS
HAWAII	HAW.				

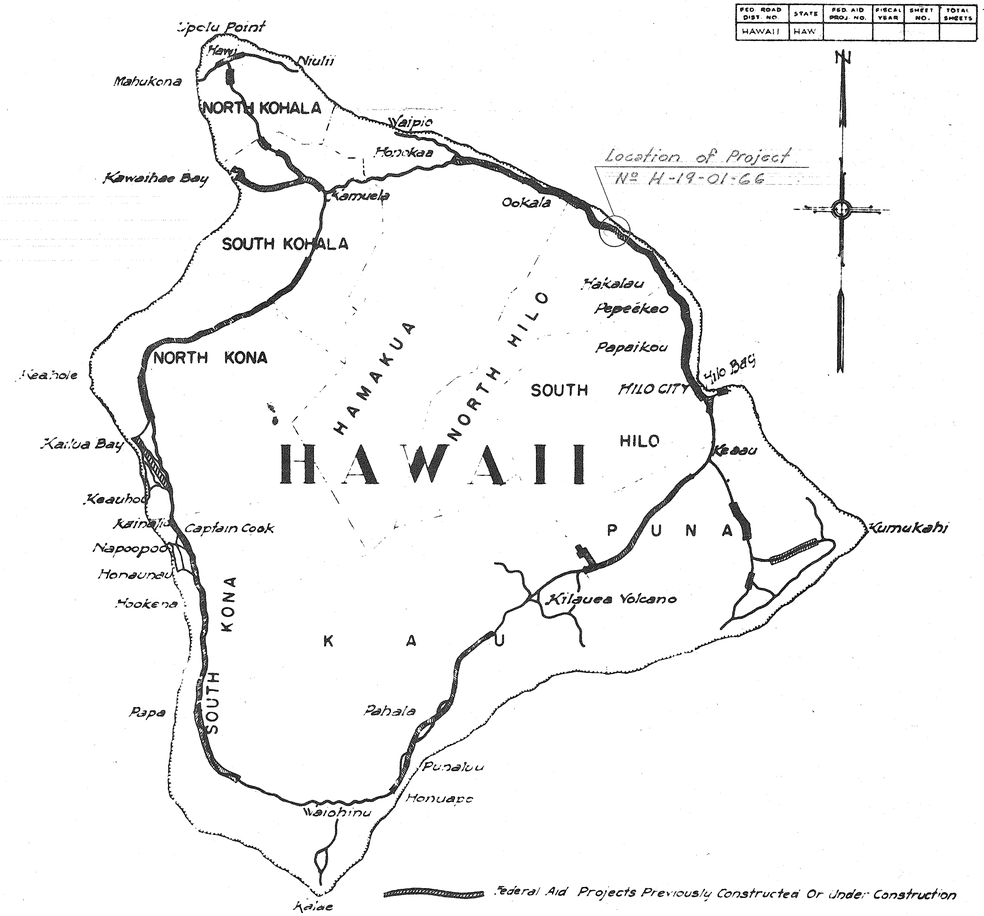

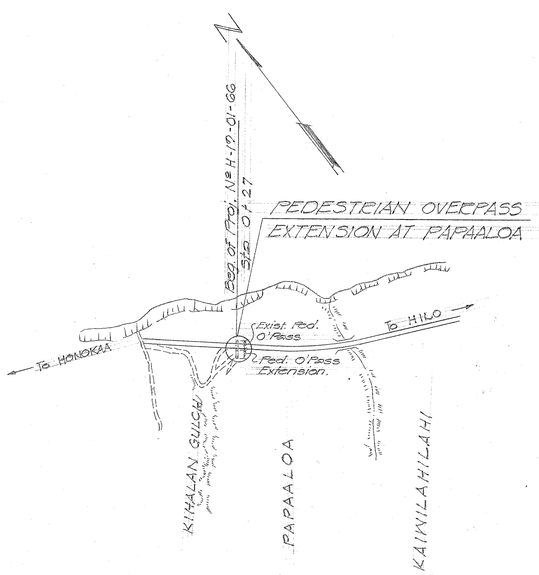

LOCATION PLAN
SCALE: 1" = 1000'

NOTE:

ALL CHANGES MADE DURING CONSTRUCTION HAVE BEEN NOTED IN RED ON THESE TRACINGS AND CHECKED BY:

PROJECT ENGINEER

2/20/68
DATE

APPROVED: DATE 6 May 68

DIRECTOR OF TRANSPORTATION

SHEET No. 1 OF 4 SHEETS