FED. ROAD DIST. NO.	STATE	PROJ. NO.	FISCAL YEAR	SHEET NO.	TOTAL SHEETS
	HAW.	19J-02-70	1969	1	6

INDEX TO DRAWINGS

SHEET	DESCRIPTION
1	TITLE SHEET
2	REPAIRS TO PED. OVERPASS
3-6	ORIGINAL STRUCTURAL DETAILS

STATE OF HAWAII

DEPARTMENT OF TRANSPORTATION

DIVISION OF HIGHWAYS

PLANS OF

REPAIRS TO

PEDESTRIAN OVERPASS ON HAWAII BELT ROAD

AT PAPAIKOU

PROJECT NO. 19 J-02-70

DISTRICT OF SOUTH HILO

ISLAND OF HAWAII

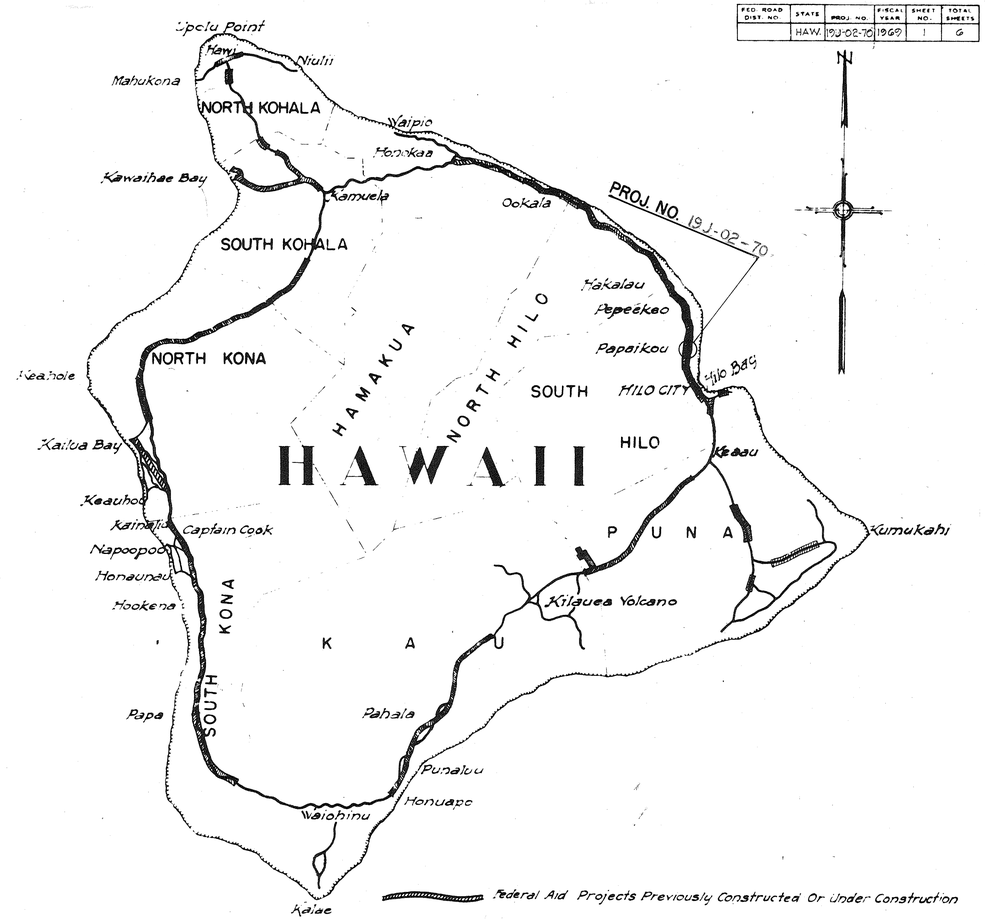

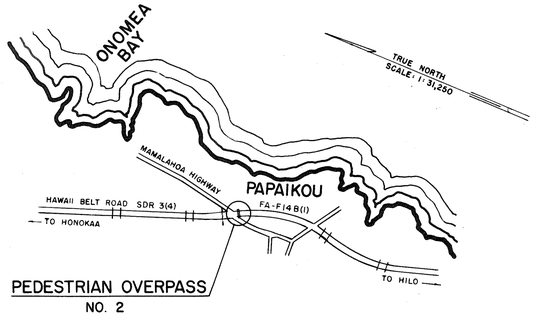

PEDESTRIAN OVERPASS
NO. 2

LOCATION PLAN
SCALE: 1" = 31,250

APPROVED: DATE 11/24/69

E. Alvey Wright
for DIRECTOR OF TRANSPORTATION

ORIGINAL PLAN	SURVEY PLOTTED BY DESIGNED BY D. BEVIER DRAWN BY TRACED BY QUANTITIES CALCULATED BY CHECKED BY	DATE NOV. 1969