

FED. ROAD DIST. NO.	STATE	PROJ. NO.	FISCAL YEAR	SHEET NO.	TOTAL SHEETS
HAWAII	HAW.	19L-01-73	1973	4	5



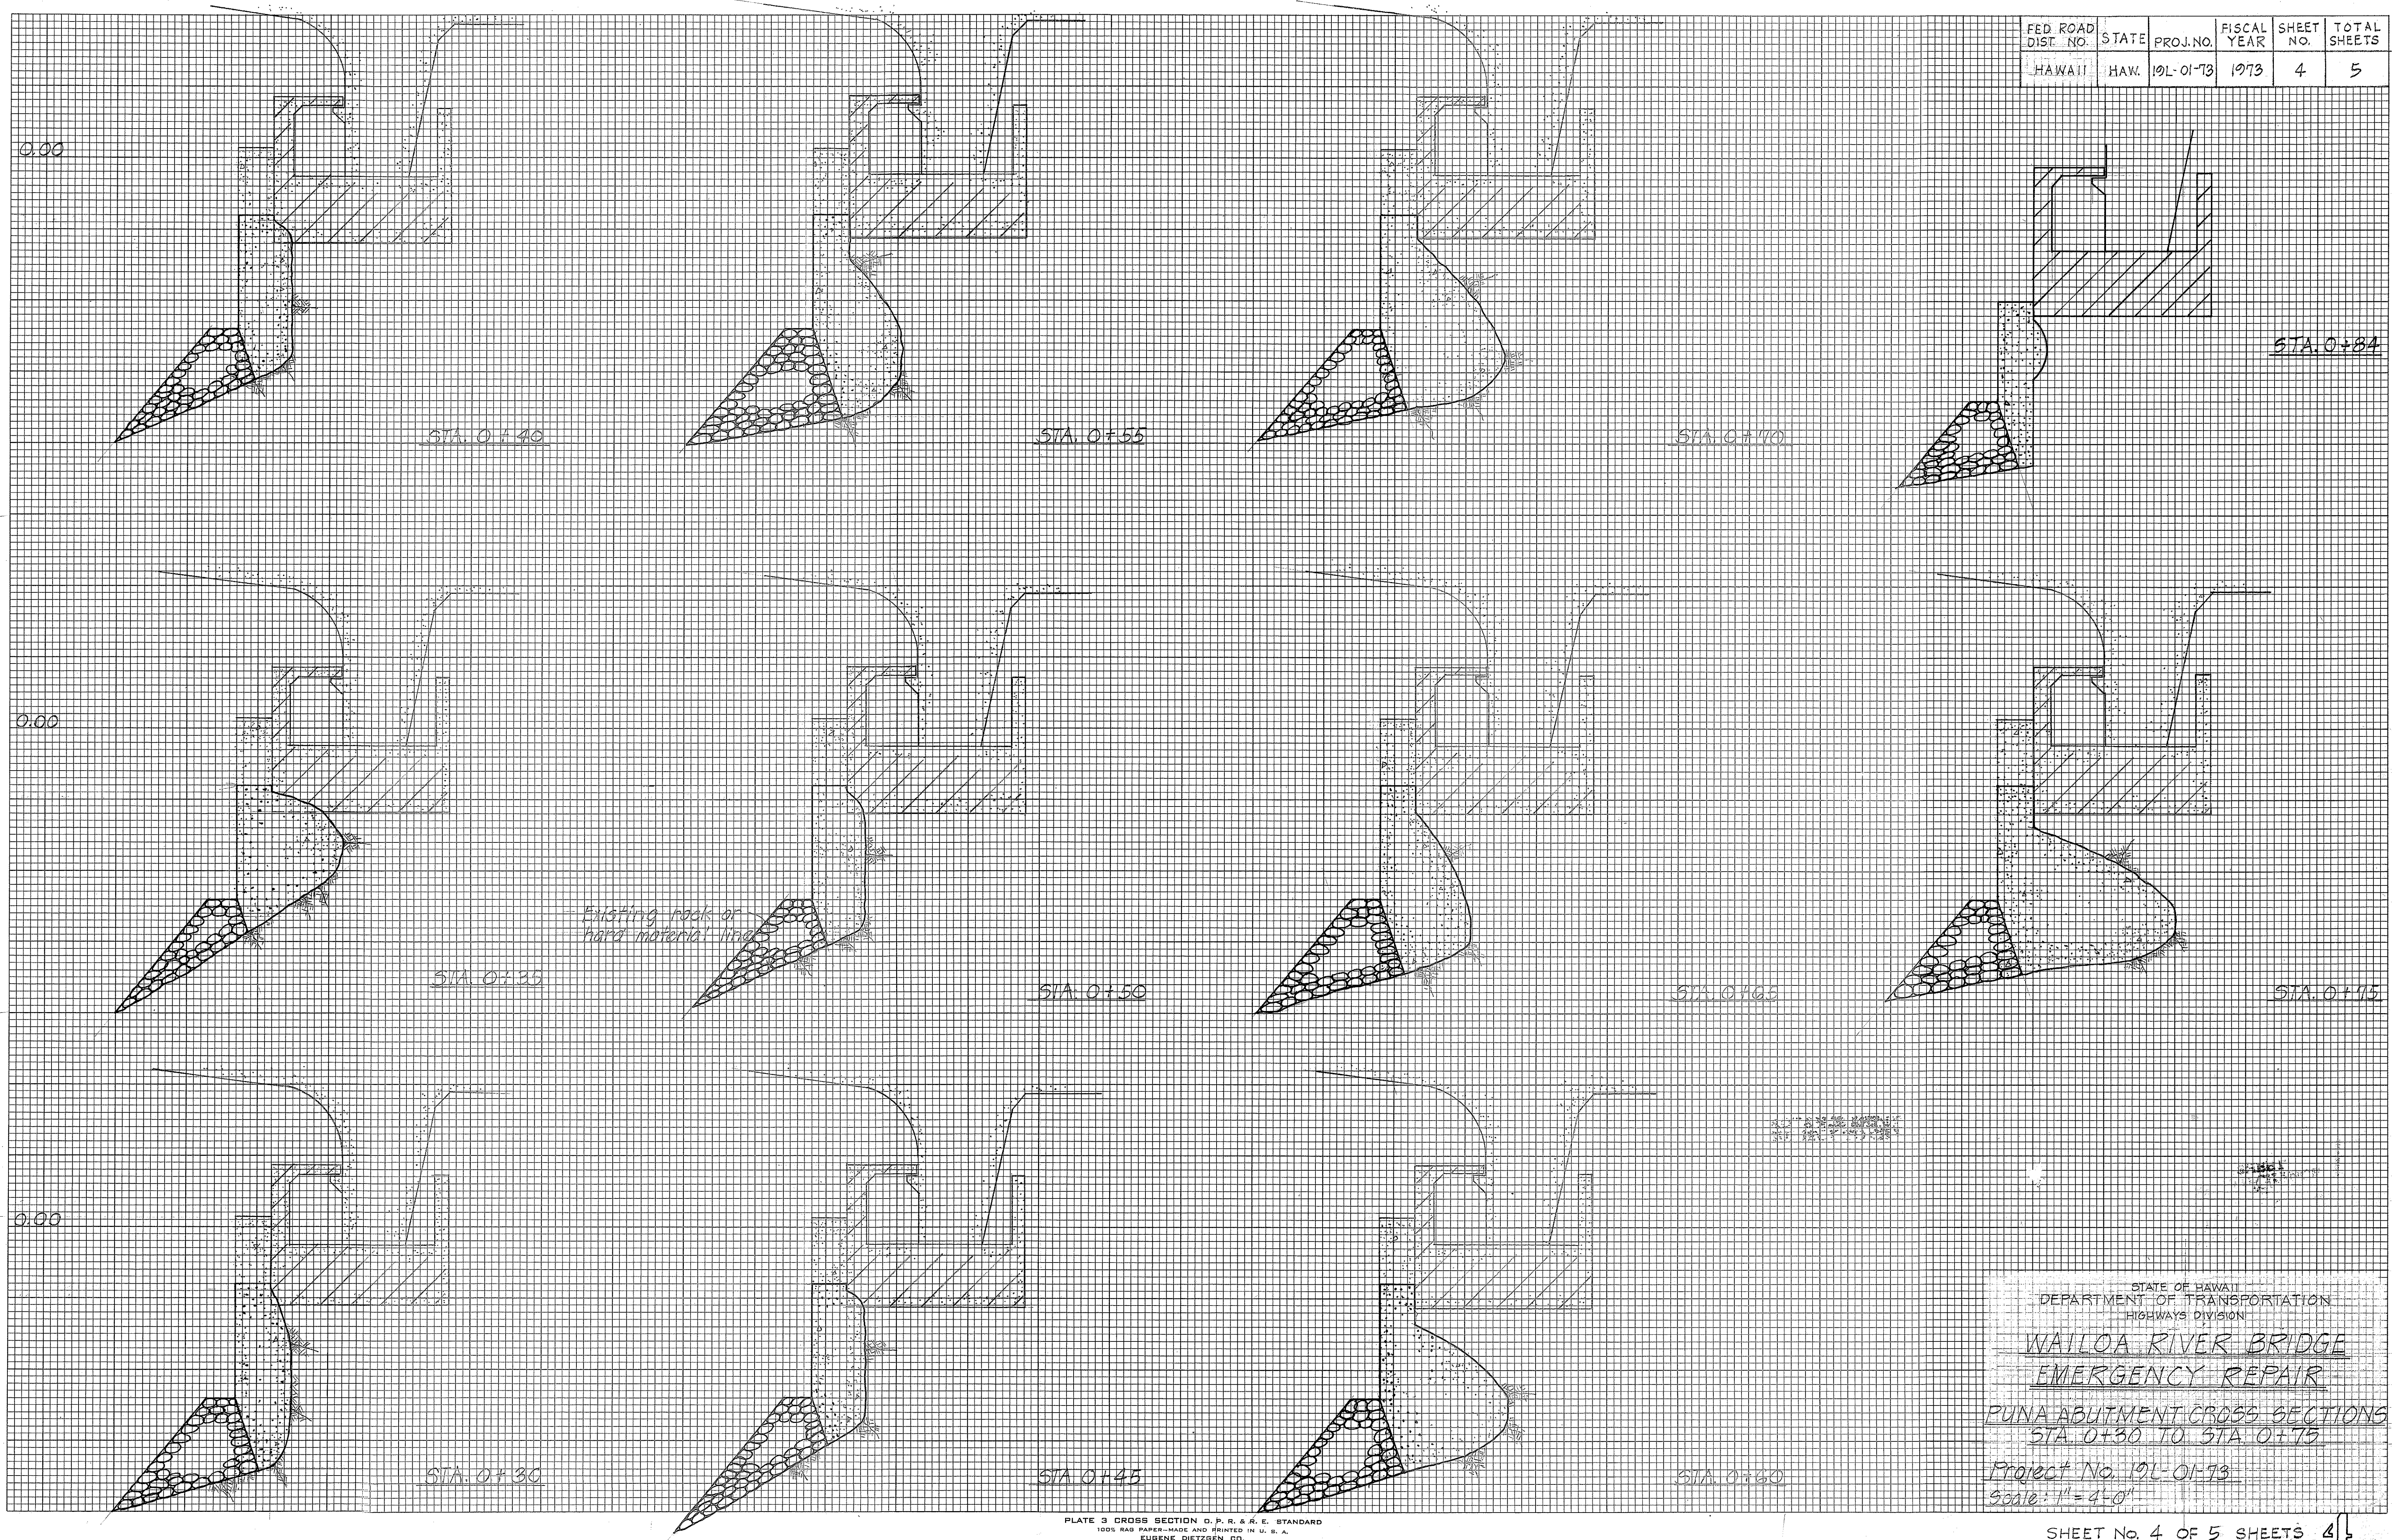


PLATE 3 CROSS SECTION D. P. R. & R. E. STANDARD
100% RAG PAPER—MADE AND PRINTED IN U. S. A.
EUGENE DIETZEN CO.

STATE OF HAWAII
DEPARTMENT OF TRANSPORTATION
HIGHWAYS DIVISION
WAILOA RIVER BRIDGE
EMERGENCY REPAIR
PUNA ABUTMENT CROSS SECTIONS
STA. 0+30 TO STA. 0+75
Project No. 19L-01-73
Scale: 1" = 4'-0"