


STATE	PROJ. NO.	FISCAL YEAR	SHEET NO.	TOTAL SHEETS
HAW.	19BC-01-71	1974	58	64

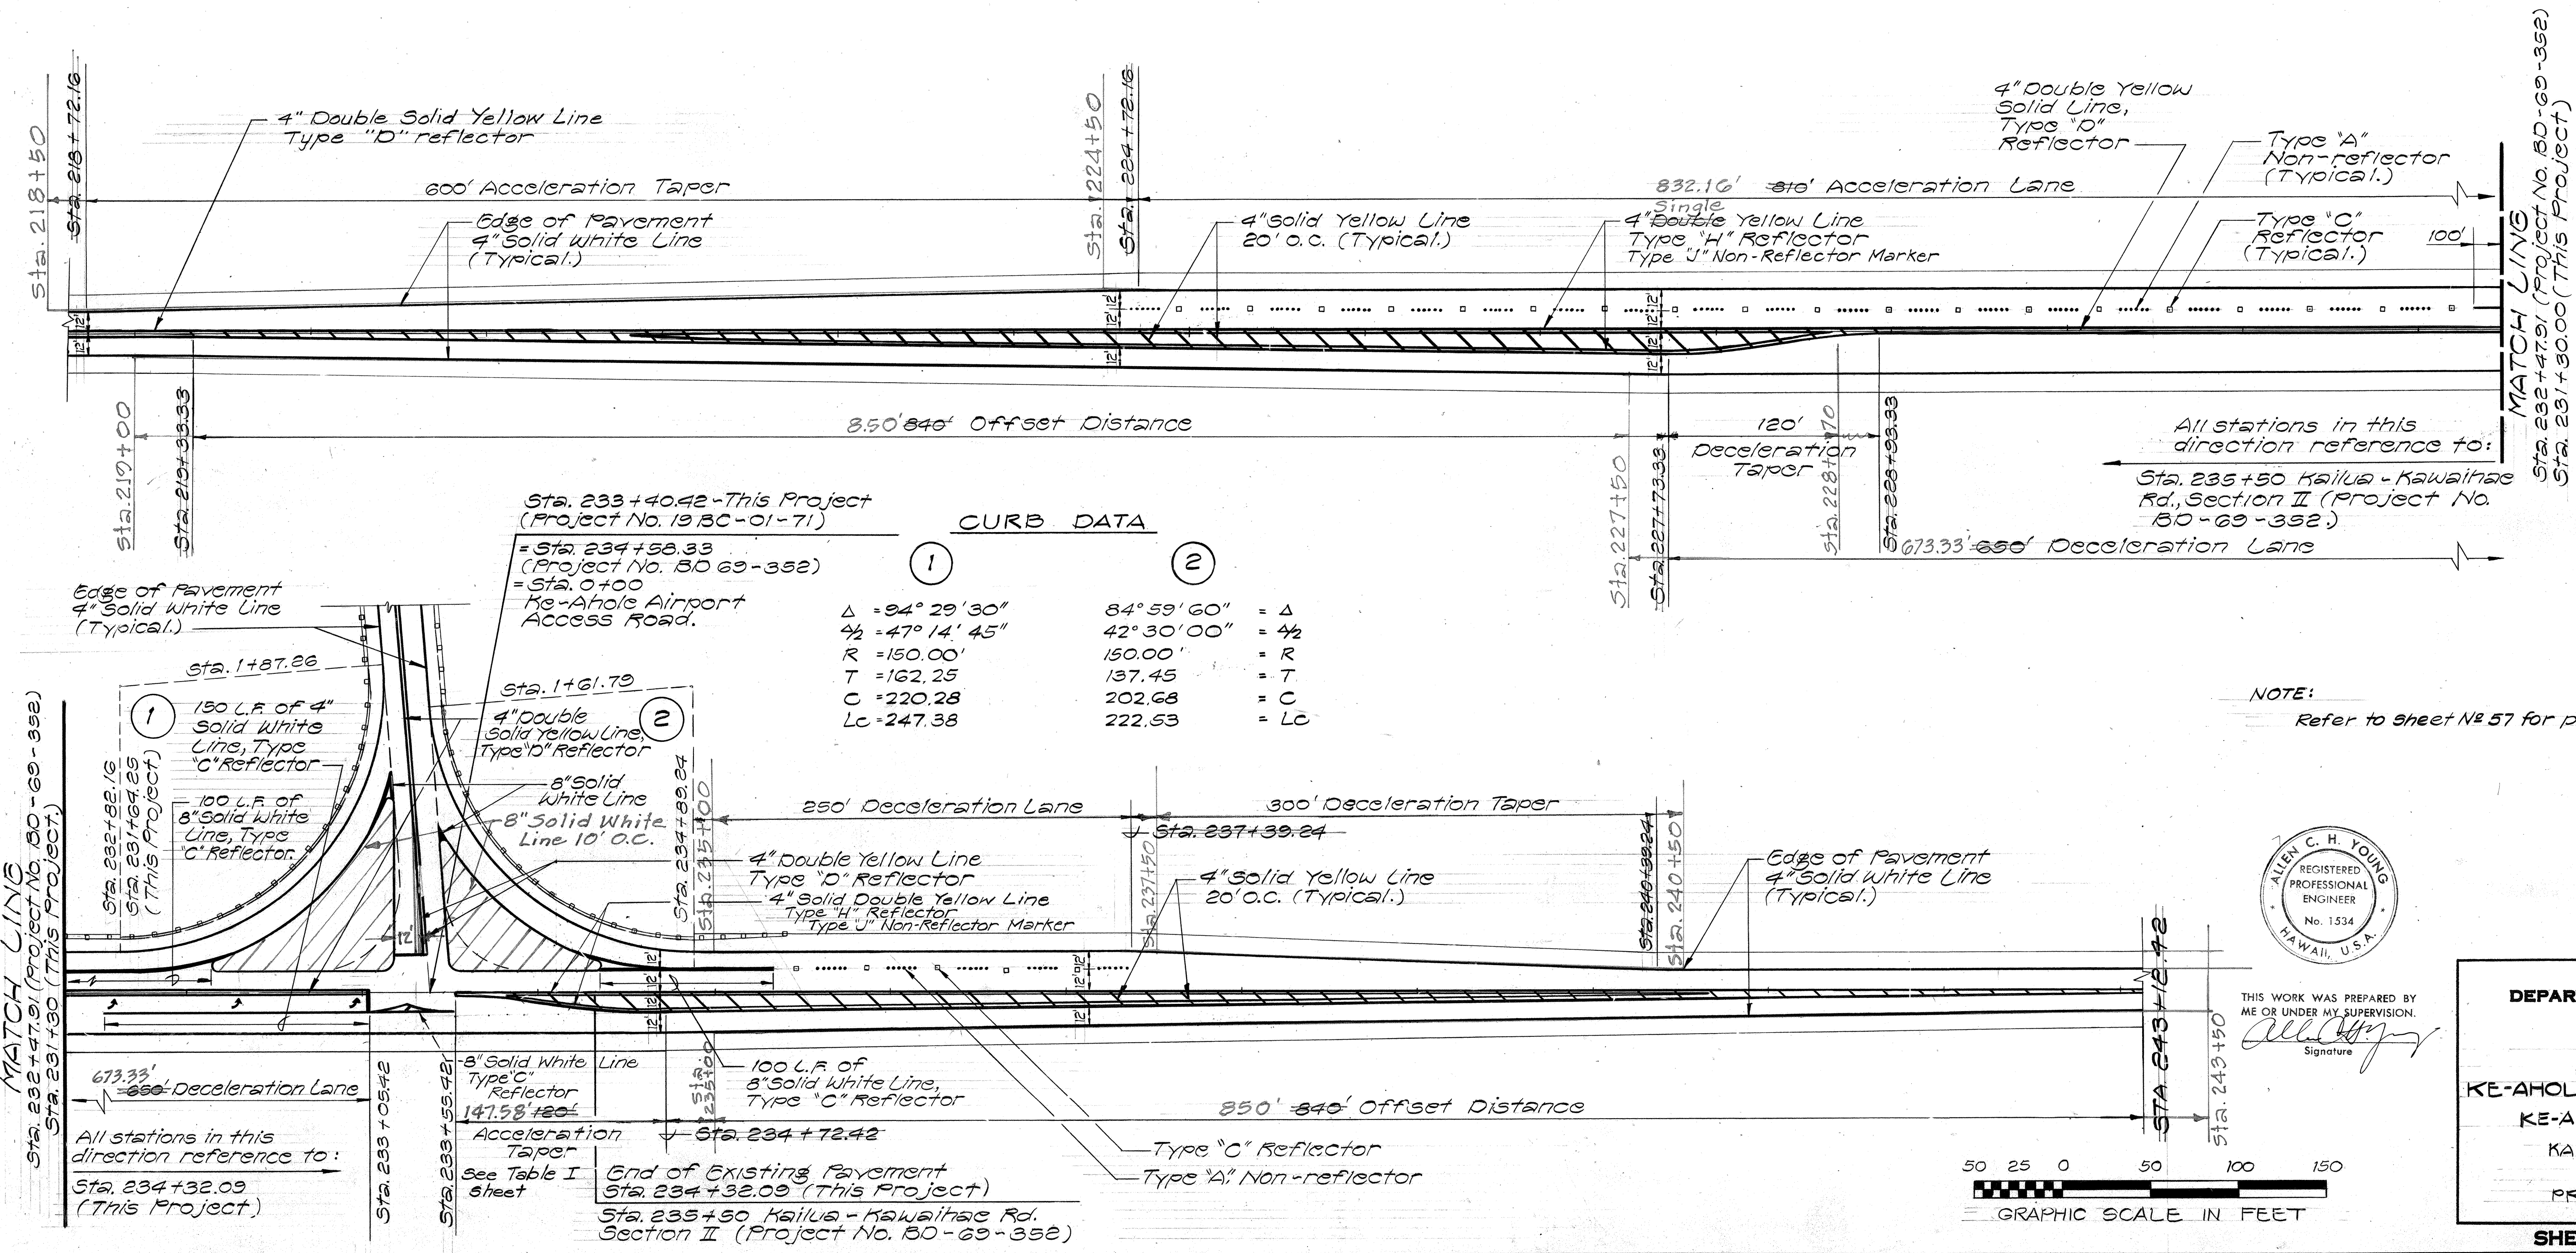


Sta. 233+40.42 - This Project
(Project No. 19BC-01-71)

Sta. 234+58.33
(Project No. 80-69-352)


Sta. 0+00
Ke-Ahole Airport
Access Road.

CURB DATA	
①	②
$\Delta = 94^\circ 29' 30"$	$84^\circ 59' 60" = \Delta$
$\frac{1}{2} = 47^\circ 14' 45"$	$42^\circ 30' 00" = \frac{1}{2}$
$R = 150.00'$	$150.00' = R$
$T = 162.25$	$137.45 = T$
$C = 220.28$	$202.68 = C$
$LC = 247.38$	$222.53 = LC$

NOTE:
Refer to Sheet No. 57 for pavement marker detail.

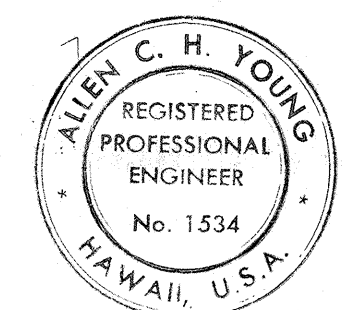

THIS WORK WAS PREPARED BY
ME OR UNDER MY SUPERVISION.
Allen C. H. Young
Signature

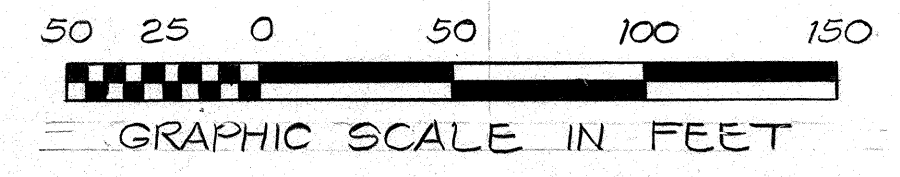

STATE OF HAWAII
DEPARTMENT OF TRANSPORTATION
HIGHWAYS DIVISION

STRIPING PLAN
KE-AHOLE AIRPORT ACCESS ROAD
KE-AHOLE TO ANAEHOOMALU
KAILUA-KAWAIHAE ROAD

PROJ. NO. 19 BC-01-71

SHEET No. 1 OF 2 SHEETS

DATE	
DESIGNED BY	
DRAWN BY	
CHECKED BY	
NOTED BY	
ORIGINAL PLAN	
NOTE BOOK	

MATCH LINE
Sta. 232+47.91 (Project No. 80-69-352)
Sta. 231+30 (This Project)

ORIGINAL PLAN	SURVEY PLOTTED BY _____	DATE _____
	DRAWN BY _____	" _____
	TRACED BY _____	" _____
NOTE BOOK	DESIGNED BY _____	" _____
	QUANTITIES BY _____	" _____
No. _____	CHECKED BY _____	" _____

