FED. ROAD DIST. NO.	STATE	FED. AID PROJ. NO.	FISCAL YEAR	SHEET NO.	TOTAL SHEETS
HAWAII	HAW.	BR-019-2(56)	2005	1	11

INDEX TO DRAWINGS

SHEET NO.	DWG. NO.	DESCRIPTION
1	–	TITLE SHEET
2	C-1	WATER POLLUTION AND EROSION CONTROL NOTES
3	C-2	WATER POLLUTION AND EROSION CONTROL NOTES
4	S-1	ABBREVIATIONS, AND QUANTITIES
5	S-2	STRUCTURAL NOTES, CONSTRUCTION SEQUENCE
6	S-3	BRIDGE LAYOUT PLAN AND BRIDGE SECTION
① 7	S-4	PARTIAL FOUNDATION AND LAYOUT PLAN, PIER ELEVATION AND PIER SECTION
8	S-5	SOIL ANCHOR FOOTING ELEVATION, COLUMN SECTIONS, CURTAIN WALL DETAIL
9	S-6	COLUMN AND BEAM SECTIONS
10	S-7	BEAM DETAILS, SOIL ANCHOR DETAIL
11	S-9	CREEP BLOCK DETAILS, BACKFILL DETAILS

Sheet No. ① 7S-1 is supplementary sheet to this project.
TOTAL SHEET COUNT after "AS-BUILT" posting is 12 sheets.

STATE OF HAWAII

DEPARTMENT OF TRANSPORTATION

HIGHWAYS DIVISION
HONOLULU, HAWAII

"AS-BUILT"

PLANS FOR

HAWAII BELT ROAD

SEISMIC RETROFIT OF VARIOUS BRIDGES
VICINITY OF HILO, PHASE 2
FEDERAL AID PROJECT NO. BR-019-2(56)

DISTRICT OF SOUTH HILO
ISLAND OF HAWAII

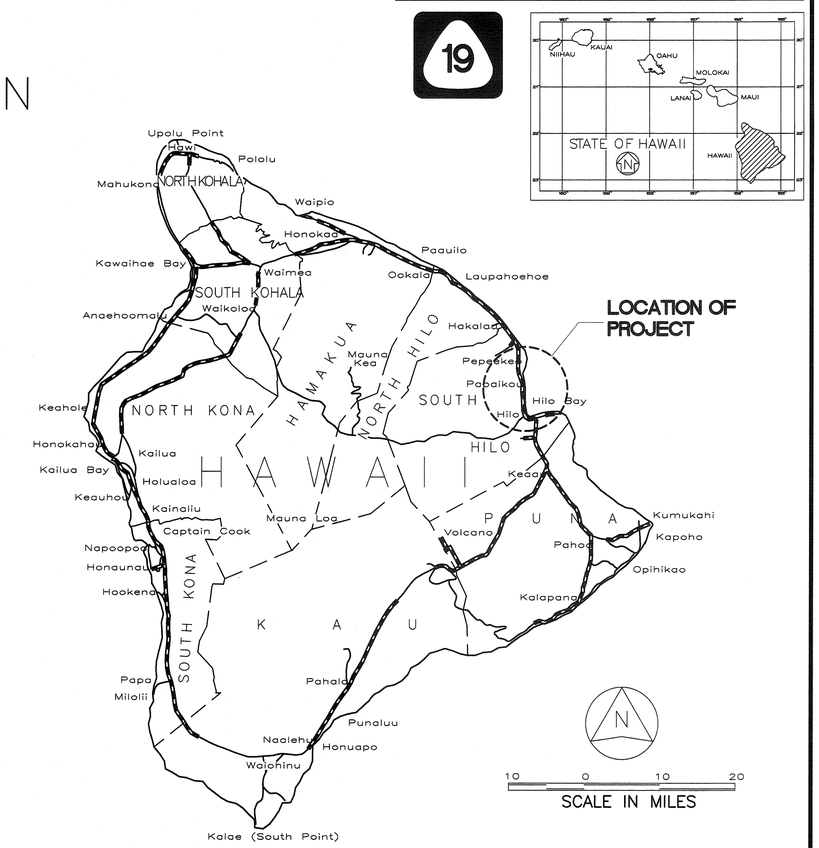

FEDERAL AID PROJECTS PREVIOUSLY CONSTRUCTED OR UNDER CONSTRUCTION

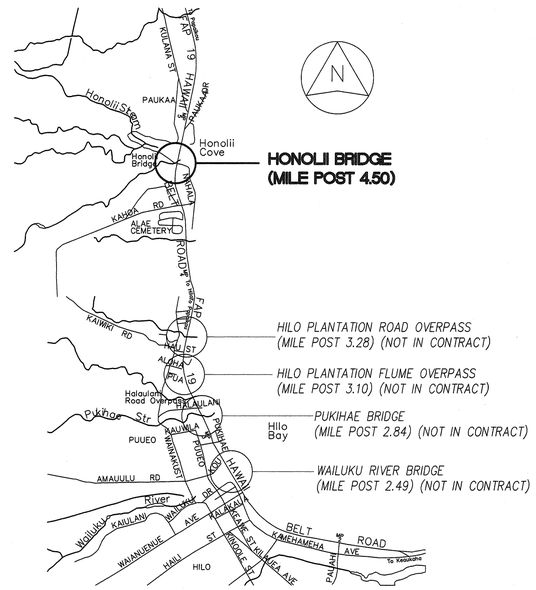

LAYOUT PLAN
NOT TO SCALE

CHANGES MADE DURING CONSTRUCTION HAVE BEEN INCORPORATED ON THESE PLANS EXCEPT CHANGES IN THE OFFICIAL THEORETICAL QUANTITIES. FOR ACTUAL QUANTITIES REFER TO PROJECT LEDGER AND/OR CONSTRUCTION BOOK.

for RESIDENT ENGINEER — 2-28-12 DATE

DEPARTMENT OF TRANSPORTATION
STATE OF HAWAII
APPROVED:
for DIR. OF TRANSPORTATION — 2-21-06 DATE

NISHIMURA, KATAYAMA, & OKI INC.
DESIGNED BY

HWY-DS
P. S. & E. BY

692-7545
PHONE

NOV. 2005
DATE

ORIGINAL PLAN
SURVEY PLOTTED BY
TRACED BY
DESIGNED BY
QUANTITIES BY
CHECKED BY
DATE
NOTE BOOK
No.