FED. ROAD DIST. NO.	STATE	FED. AID PROJ. NO.	FISCAL YEAR	SHEET NO.	TOTAL SHEETS
HAWAI'I	HAW.	19H-02-06M	2006	1	8

INDEX TO DRAWINGS

SHEET NO.	DESCRIPTION
1	TITLE SHEET
2	STANDARD PLANS SUMMARY
3	TYPICAL SECTION LAUPAHOEHOE GULCH AREA
4	TREE AND SHRUB TRIMMINIG AND REMOVAL DETAILS
5 – 6	ROADWAY PLAN LAUPAHOEHOE GULCH AREA
7 – 8	WATER POLLUTION & EROSION CONTROL NOTES

STATE OF HAWAI'I

DEPARTMENT OF TRANSPORTATION

HIGHWAYS DIVISION

HONOLULU, HAWAI'I

"AS-BUILT"

PLANS FOR

HAWAI'I BELT ROAD, ROUTE 19 TREE AND SHRUB TRIMMING

LAUPAHOEHOE GULCH

PROJECT NO. 19H-02-06M

DISTRICT OF NORTH HILO

ISLAND OF HAWAI'I

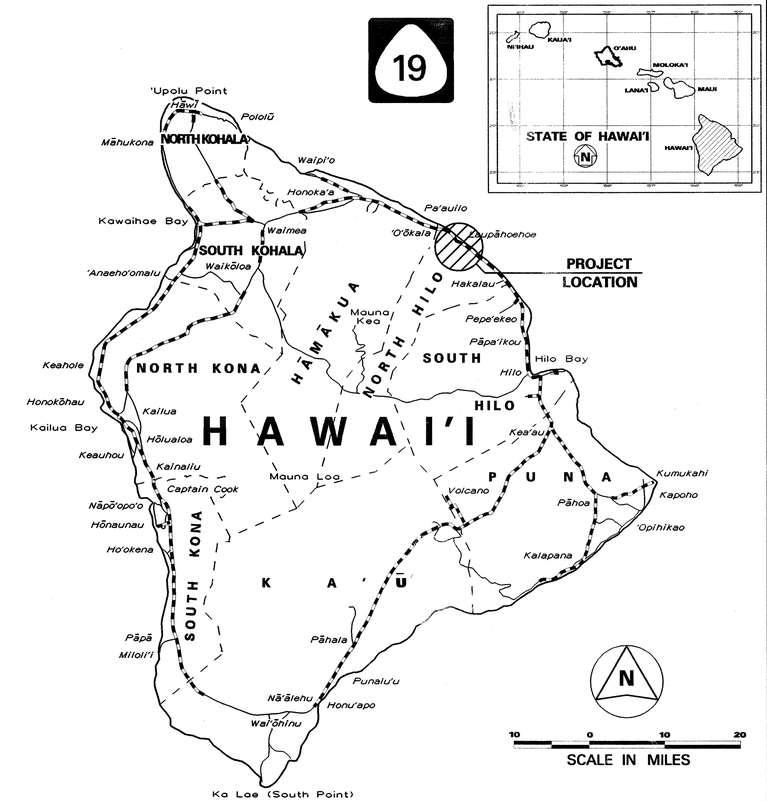

FEDERAL AID PROJECTS PREVIOUSLY CONSTRUCTED OR UNDER CONSTRUCTION

MILE POST 27.00 TO MILE POST 26.00 , ROUTE 19

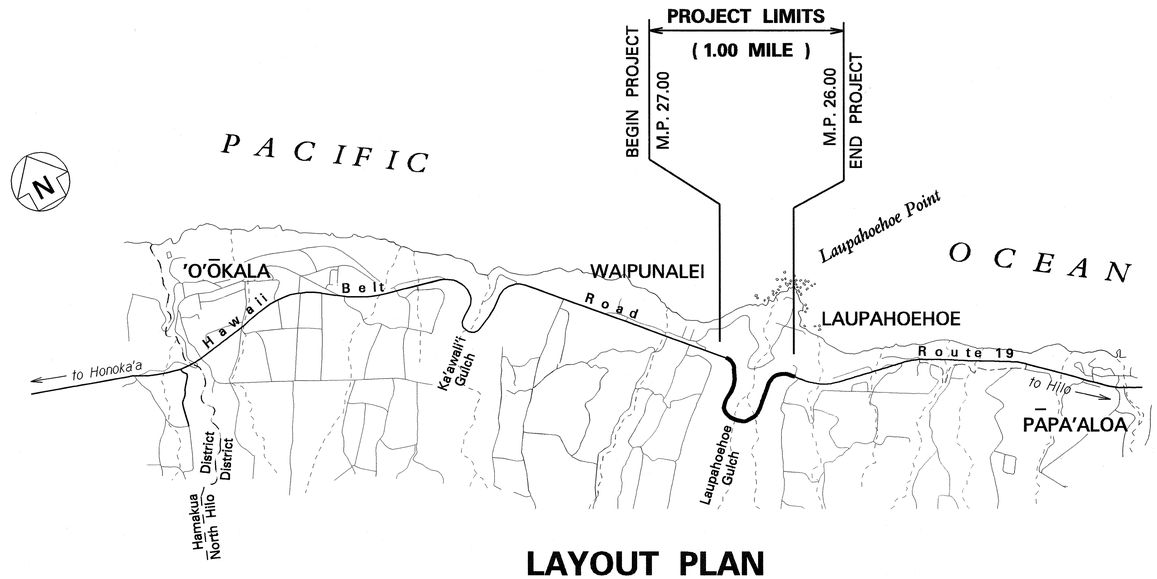

LAYOUT PLAN

2 0 2 4 6

SCALE IN THOUSAND FEET

CHANGES MADE DURING CONSTRUCTION HAVE BEEN INCORPORATED ON THESE PLANS EXCEPT CHANGES IN THE ORIGINAL THEORETICAL QUANTITIES. FOR ACTUAL QUANTITIES, REFER TO PROJECT LEDGER AND/OR COMPUTATION BOOK.

RESIDENT ENGINEER — DATE 4/16/08

HAWAII DISTRICT DESIGNED BY

HWY-HE MANAGED BY

933-8866 PHONE

April, 2006 DATE