FED. ROAD DIST. NO.	STATE	FED. AID PROJ. NO.	FISCAL YEAR	SHEET NO.	TOTAL SHEETS
HAWAII	HAW.	ER-15(3)	2010	14	80

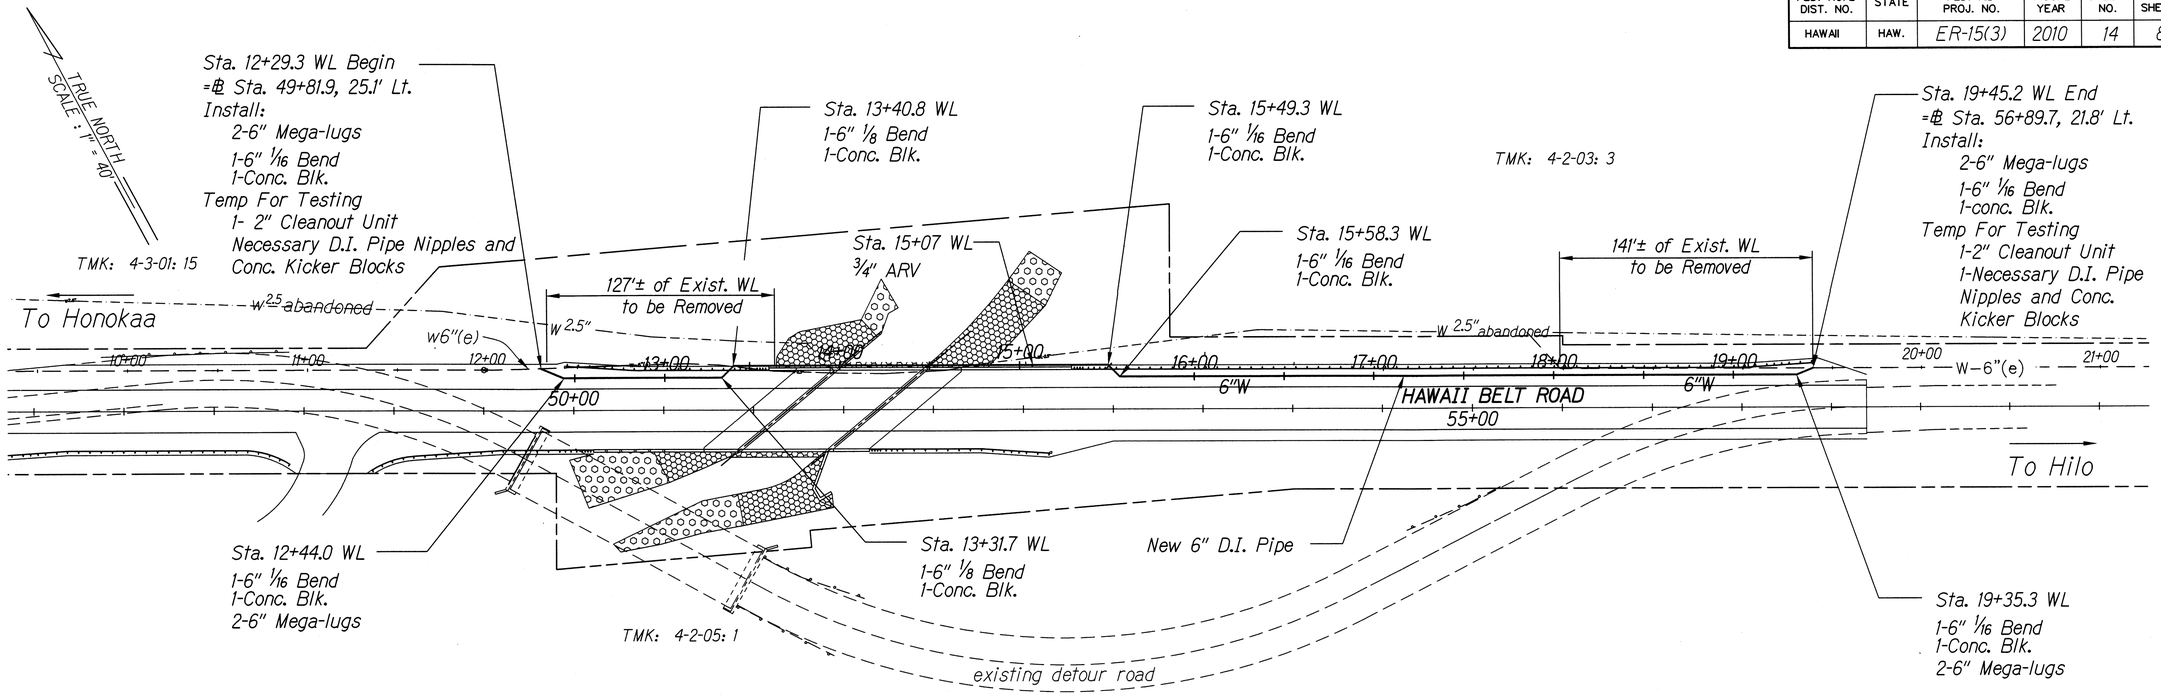

PLAN

SCALE: 1"=40'

SCALE

VERTICAL SCALE: 1"=8' 8' 0 8' 16'

HORIZONTAL SCALE: 1"=40' 40' 0 40' 80'

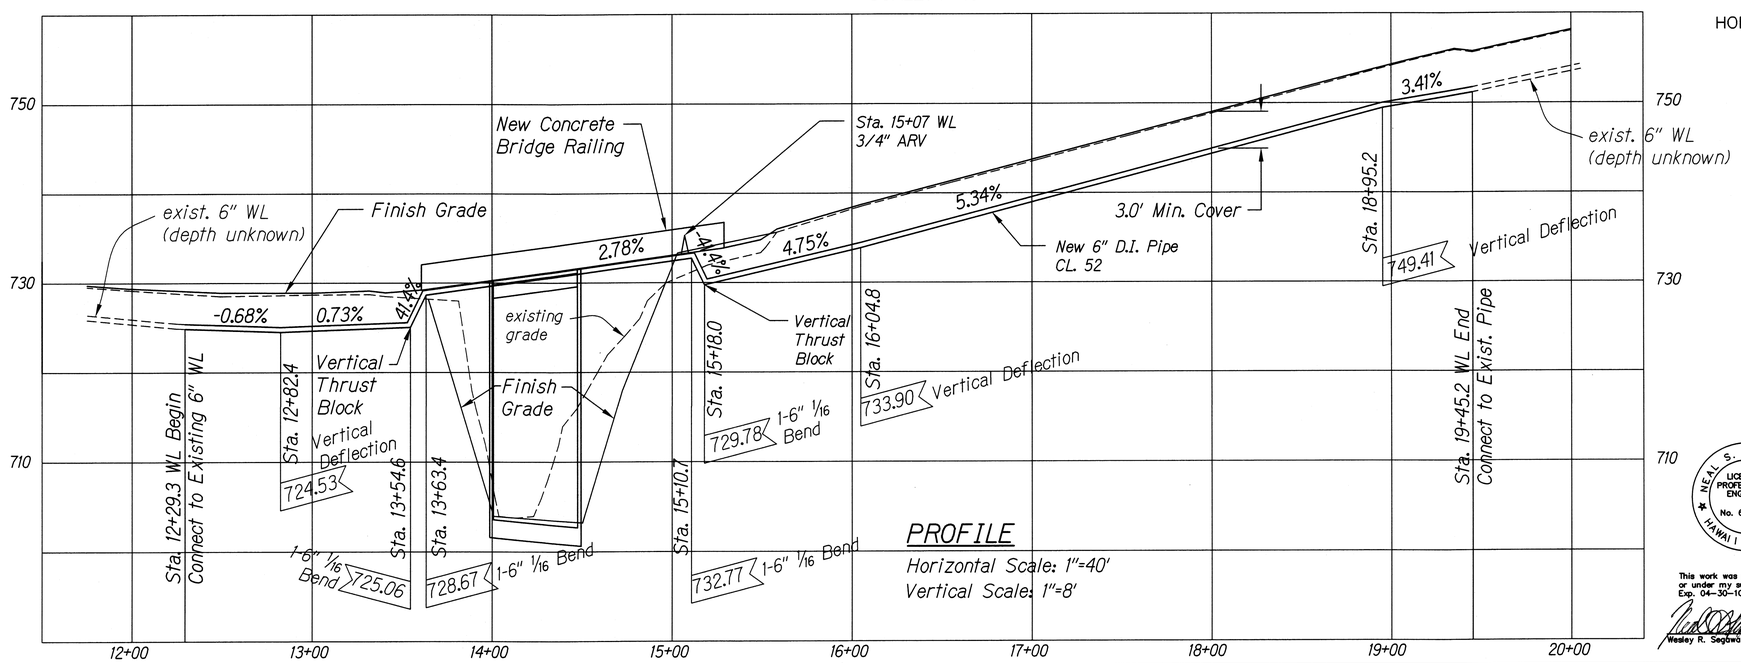

PROFILE

Horizontal Scale: 1"=40'

Vertical Scale: 1"=8'

ORIGINAL PLAN	SURVEY PLOTTED BY	DATE
	DRAWN BY	
NOTE BOOK	TRACED BY	
	DESIGNED BY	
	QUANTITIES BY	
No.	CHECKED BY	

NEAL S. FUKUMOTO
LICENSED PROFESSIONAL ENGINEER
No. 6186-C
HAWAII U.S.A.

This work was prepared by me or under my supervision.
Exp. 04-30-10

Wesley R. Segawa & Associates, Inc.

STATE OF HAWAII
DEPARTMENT OF TRANSPORTATION
HIGHWAYS DIVISION

WATERLINE PLAN AND PROFILE

HAWAII BELT ROAD
KAWAILII STREAM BRIDGE REPLACEMENT
Federal Aid Project No. ER-15(3)

Scale: NTS Date: October 2009

SHEET No. 1 OF 1 SHEETS