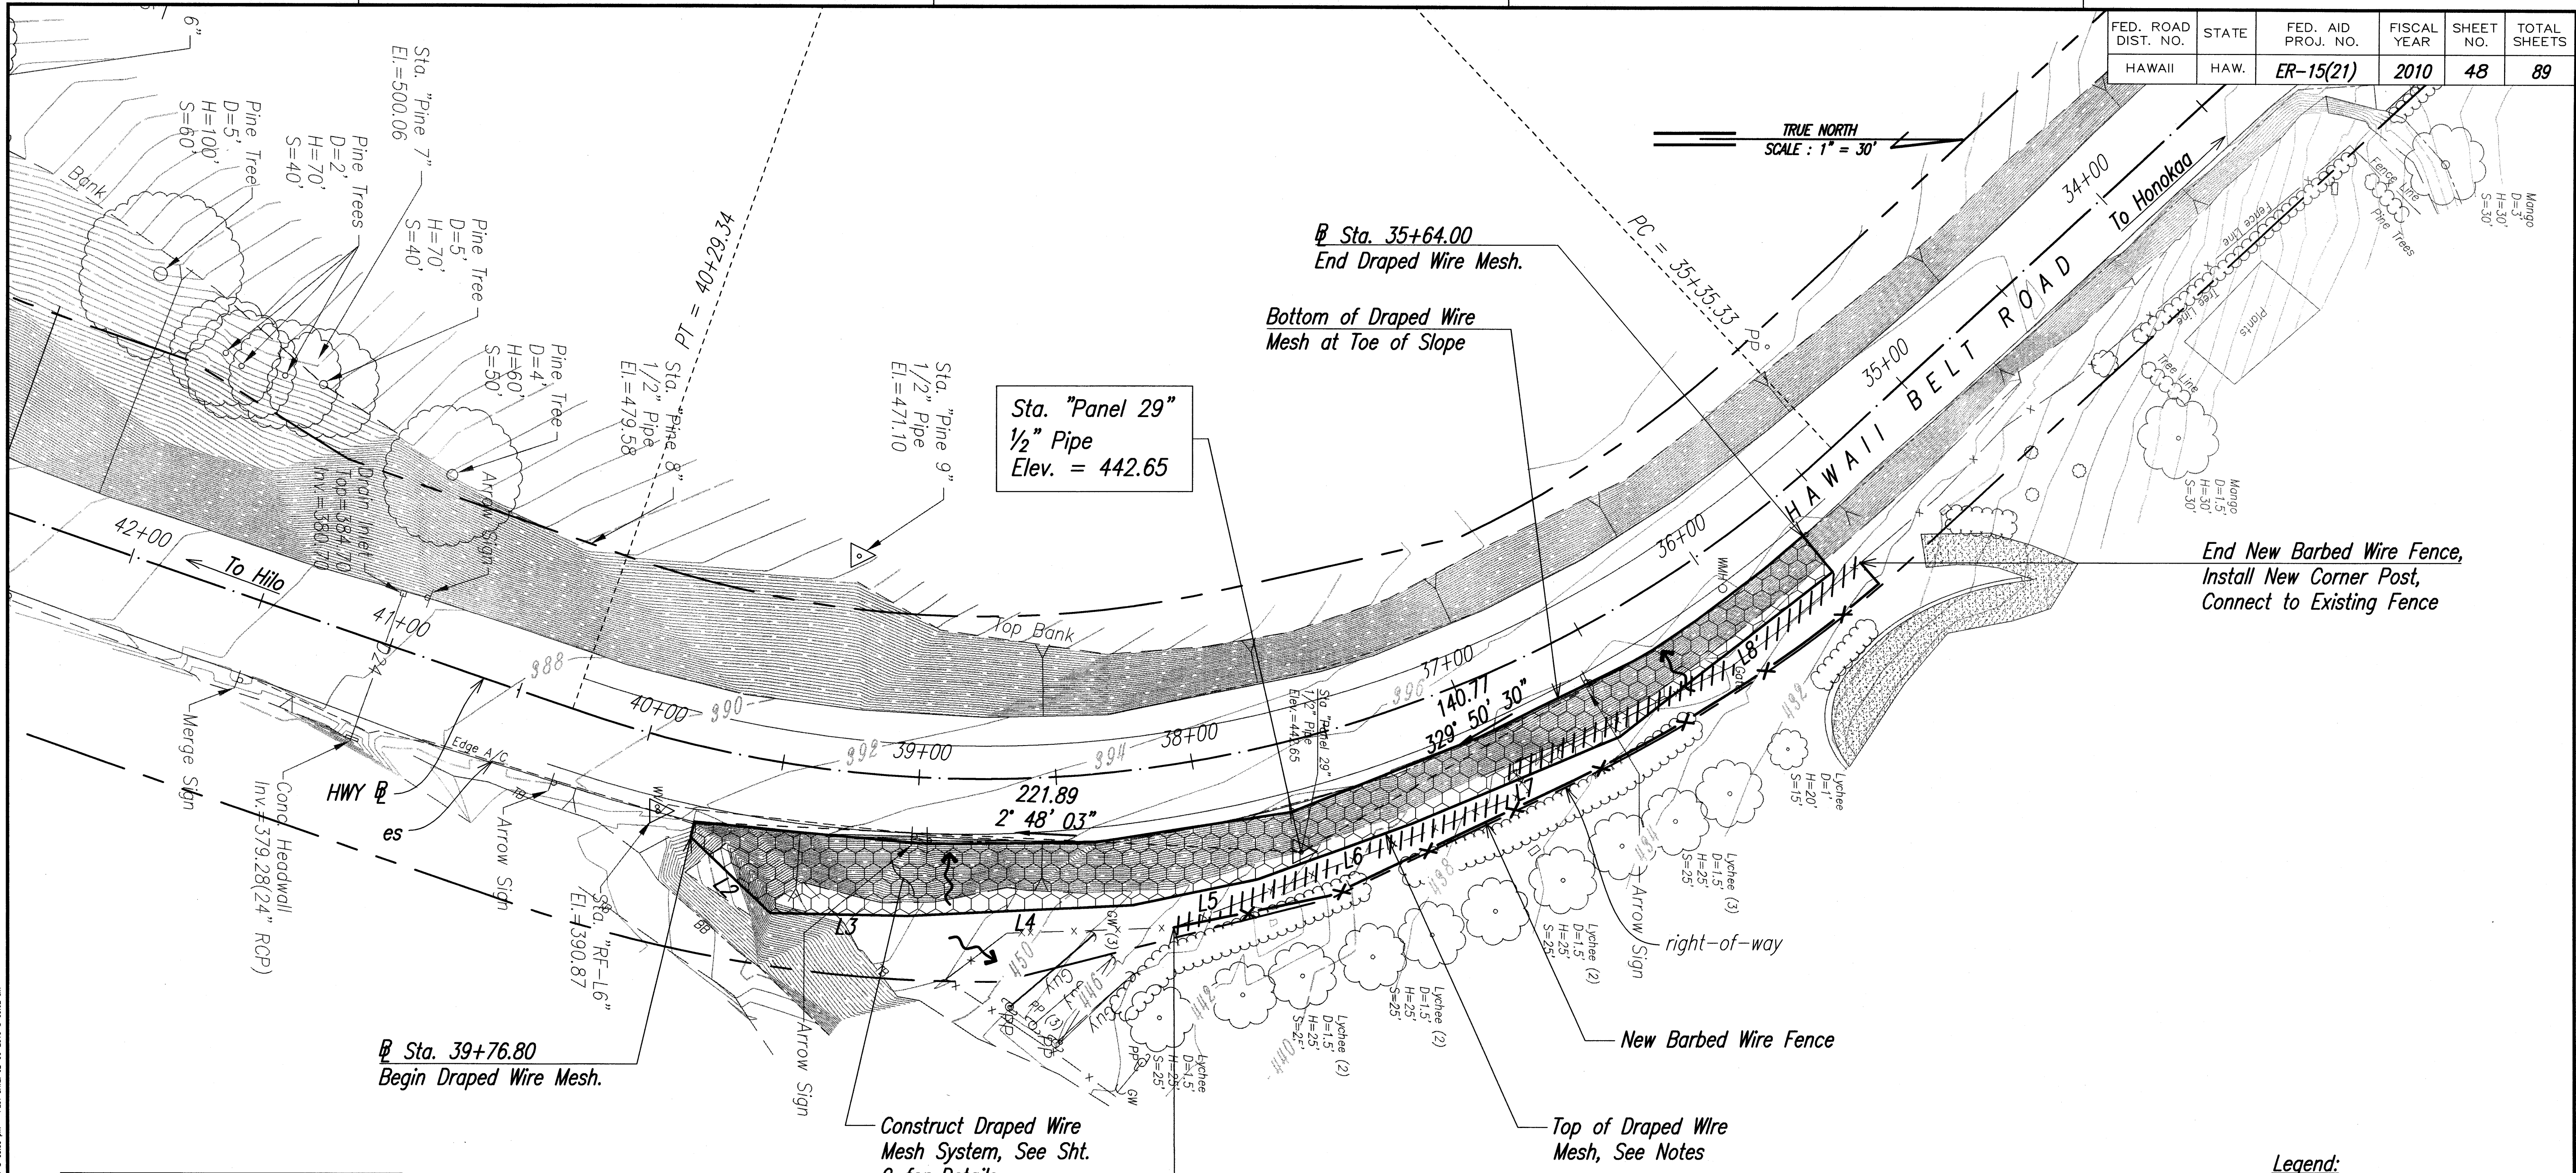


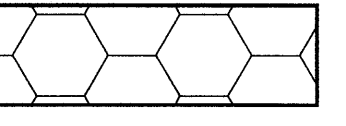


Wire Mesh Controls		
Line No.	Length	Azimuth
L2	40.25'	224°00'45.52"
L3	50.25'	181°04'14.58"
L4	82.44'	177°14'57.05"
L5	46.55'	168°00'33.36"
L6	59.99'	159°53'59.86"
L7	82.50'	157°05'50.82"
L8	99.01'	141°50'54.27"

- Notes:
- Wire mesh limits are shown in plan view. Contractor shall account for slope irregularities.
 - Top rope anchors (not shown) shall be installed 10' minimum from the top edge (crest) of slope.
 - Clear the vegetation, level the slope surface, perform general rock scaling prior to installing draped wire mesh.

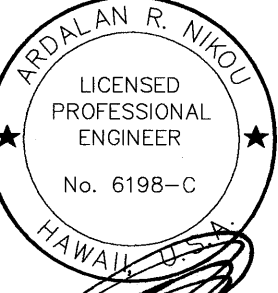
MP 26.75 SITE PLAN
Scale: 1"=30'

Legend:

 Draped Wire Mesh System

 Wire Fence

AECOM


EXPIRATION DATE OF THE LICENSE: 4/30/2010
THIS WORK WAS PREPARED BY ME OR UNDER MY SUPERVISION.

STATE OF HAWAII
DEPARTMENT OF TRANSPORTATION
HIGHWAYS DIVISION

MP 26.75 SITE PLAN

**EMERGENCY EARTHQUAKE ROCKFALL REPAIRS
AT VARIOUS LOCATIONS**

F.A. Project No. ER-15(21)

Scale: As Noted Date: December, 2009

SHEET No. 1 OF 2 SHEETS

DATE	_____
SYNOPSIS PLOTTED BY	_____
ORIGINAL PLAN	_____
DESIGNED BY	_____
TRACED BY	_____
NOTED BY	_____
CHECKED BY	_____
NO.	_____

