FED. ROAD DIST. NO.	STATE	PROJ. NO.	FISCAL YEAR	SHEET NO.	TOTAL SHEETS
HAWAII	HAW.	19BC-01-17	2017	1	30

19

INDEX TO DRAWINGS

SHEET NO.	DESCRIPTION
1	TITLE SHEET
2	STANDARD PLANS SUMMARY
3	GENERAL NOTES
4 – 6	WATER POLLUTION AND EROSION CONTROL NOTES
7 – 27	ROADWAY PLANS
28	RUMBLE STRIP SCHEDULE
(1) 29	DOUBLE 10 INCH CENTERLINE MILLED RUMBLE STRIP DETAIL
30	HIGH SPEED UNDIVIDED HIGHWAY WORK ZONE SIGNING PLAN, NOTES AND DETAILS

Sheet No. (1) ADD 29S-1 is a Supplementary sheet to this project. Total sheet count after "AS-BUILT" posting 31 sheets.

STATE OF HAWAII

DEPARTMENT OF TRANSPORTATION

HIGHWAYS DIVISION

HONOLULU, HAWAII

"AS-BUILT"

PLANS FOR

QUEEN KA'AHUMANU HIGHWAY RUMBLE STRIPS IMPROVEMENTS

MAHAI'ULA TO KAWAIHAE

PROJECT NO. 19BC-01-17

DISTRICT OF SOUTH KOHALA

ISLAND OF HAWAII

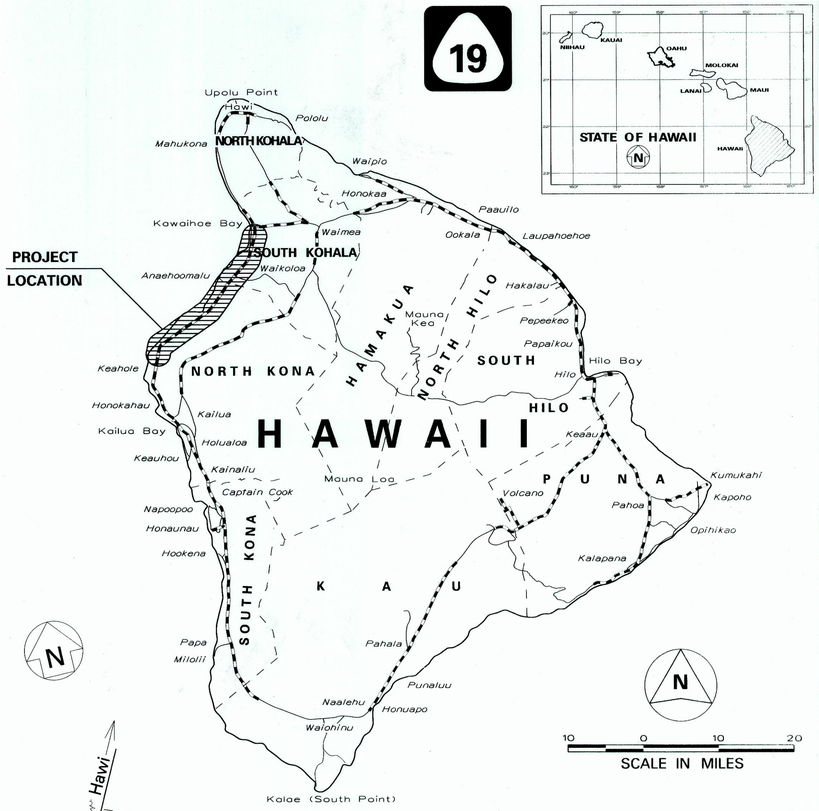

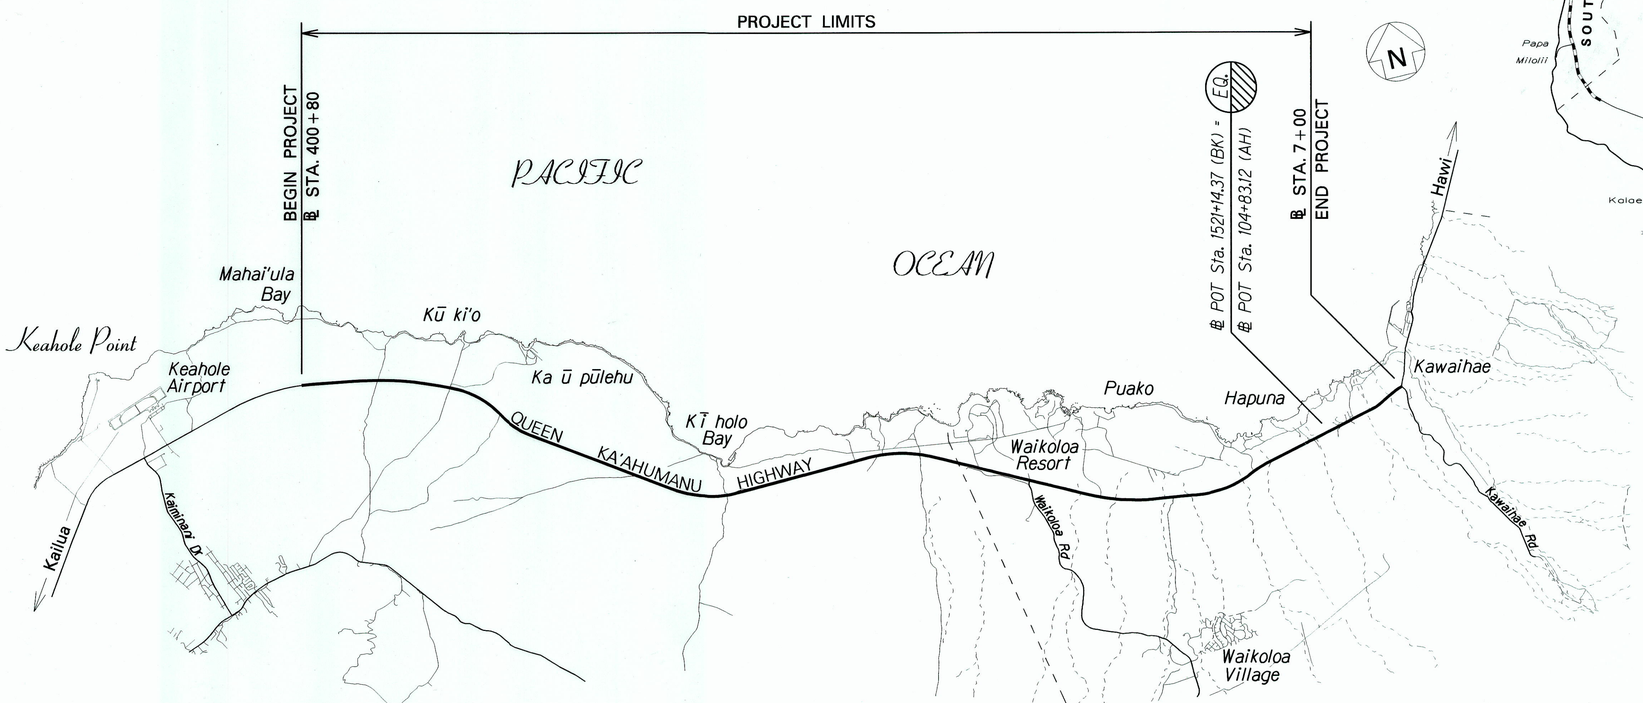

LAYOUT PLAN

LENGTH OF PROJECT..... 22.9 MILES

CHANGES MADE DURING CONSTRUCTION HAVE BEEN INCORPORATED ON THESE PLANS EXCEPT CHANGES IN THE ORIGINAL THEORETICAL QUANTITIES. FOR ACTUAL QUANTITIES, REFER TO PROJECT LEDGER AND/OR COMPUTATION BOOK.

RESIDENT ENGINEER — DATE 1/15/19

DEPARTMENT OF TRANSPORTATION
STATE OF HAWAII

APPROVED:

DIR. OF TRANSPORTATION — DATE 12-23-16

Dec., 2016	DATE
933-8866	PHONE
HWY-HE	MANAGED BY
HAWAII DISTRICT	DESIGNED BY