FED. ROAD DIST. NO.	STATE	PROJ. NO.	FISCAL YEAR	SHEET NO.	TOTAL SHEETS
HAWAII	HAW.	19L-05-79	1979	1	4

INDEX TO DRAWINGS

SHEET NO.	DESCRIPTION
1	TITLE SHEET
2	LOCATION & DRYWELL DETAILS
3	CROSS SECTIONS
4	STANDARD DETAILS

STATE OF HAWAII

DEPARTMENT OF TRANSPORTATION

HIGHWAYS DIVISION

"AS BUILT"

PLANS FOR
CONSTRUCTION OF

KAMEHAMEHA AVENUE
DRAINAGE IMPROVEMENTS

PROJECT NO. 19L-05-79

DISTRICT OF SOUTH HILO
ISLAND OF HAWAII

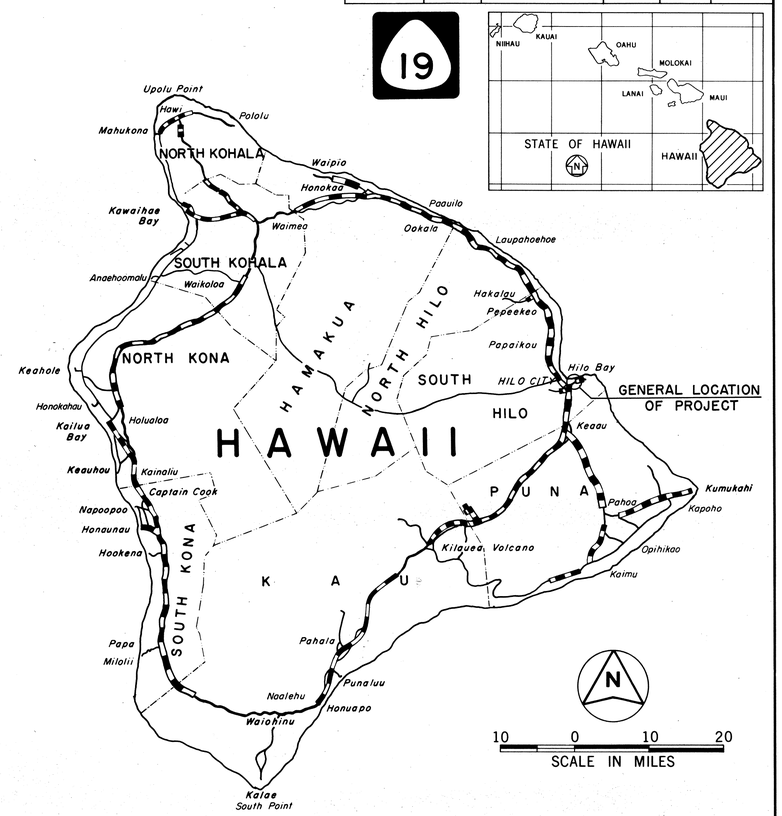

GENERAL LOCATION OF PROJECT

FEDERAL AID PROJECTS PREVIOUSLY CONSTRUCTED OR UNDER CONSTRUCTION

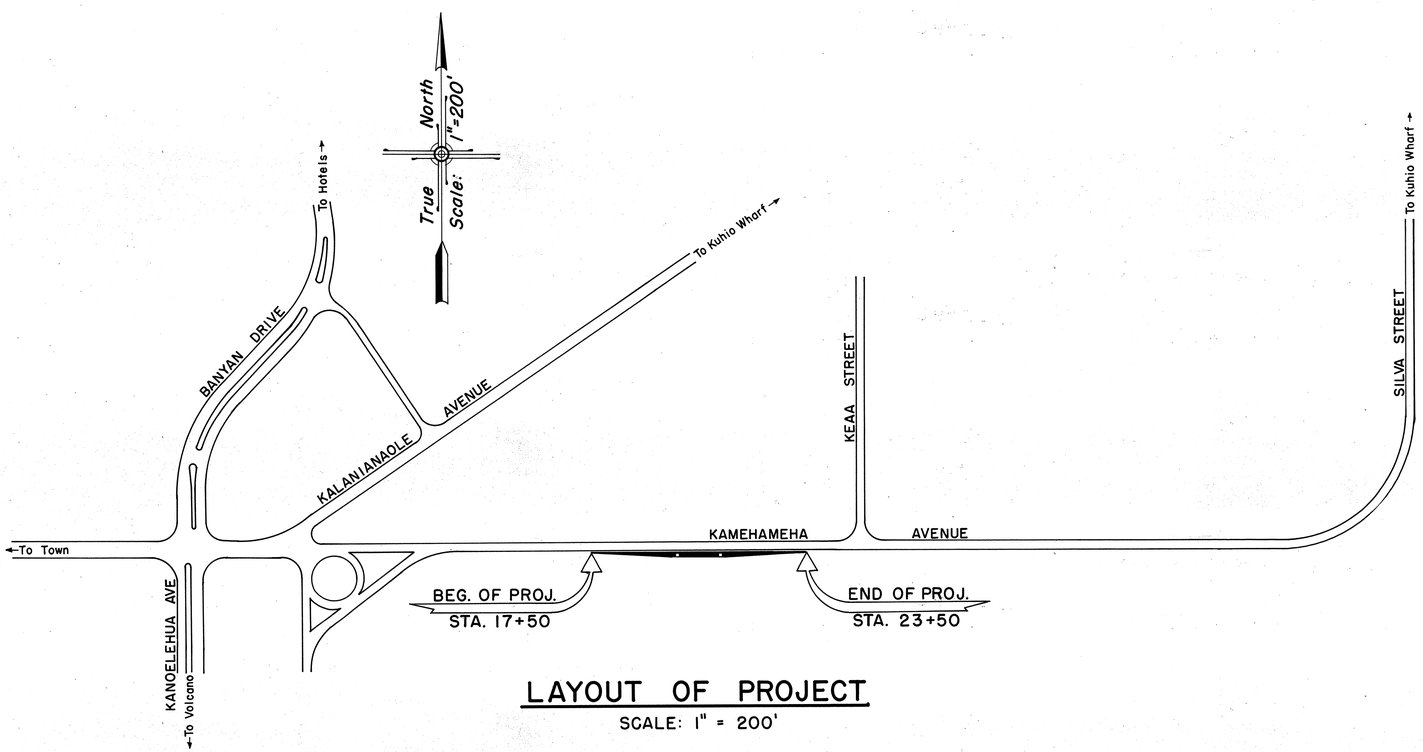

LAYOUT OF PROJECT

SCALE: 1" = 200'

ALL CHANGES MADE DURING CONSTRUCTION HAVE BEEN INCORPORATED ON THESE PLANS EXCEPT CHANGES IN THE ORIGINAL THEORETICAL QUANTITIES

Dennis Inouye Yamaguchi 6-5-80
PROJECT INSPECTOR DATE

HAWAII DISTRICT
DESIGNED BY A. YAMAGUCHI
P. S. & E. BY 548-7537
PHONE 9/14/79
DATE

DEPARTMENT OF TRANSPORTATION
STATE OF HAWAII
APPROVED:
James R. Carras 9/14/79
DIR. OF TRANSPORTATION DATE