FED. ROAD DIST. NO.	STATE	PROJ. NO.	FISCAL YEAR	SHEET NO.	TOTAL SHEETS
HAWAII	HAW.	19J-02-82	1982	1	3

INDEX TO DRAWINGS

SHEET NO.	DESCRIPTION
1	TITLE SHEET
2	LAYOUT PLAN & SCALE PAD DETAIL
3	STANDARD DETAIL

STATE OF HAWAII

DEPARTMENT OF TRANSPORTATION

HIGHWAYS DIVISION

"AS BUILT"

PLANS FOR
CONSTRUCTION OF

HAWAII BELT ROAD

VEHICLE SIZE AND WEIGHT ENFORCEMENT STATION AT PEPEEKEO

Milepost 9.60, Outbound

PROJECT NO. 19J-02-82

DISTRICT OF SOUTH HILO
ISLAND OF HAWAII

Contractor: Site Engineering, Inc.
Contrat No: 14730

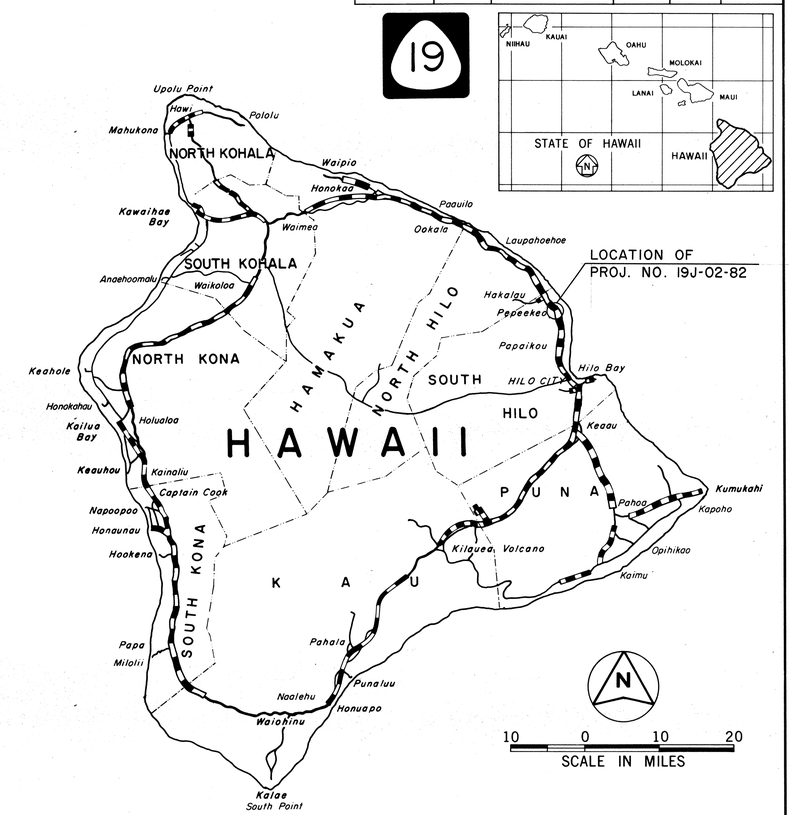

FEDERAL AID PROJECTS PREVIOUSLY CONSTRUCTED OR UNDER CONSTRUCTION

ALL CHANGES MADE DURING CONSTRUCTION HAVE BEEN INCORPORATED ON THESE PLANS IN RED EXCEPT CHANGES IN THE ORIGINAL THEORETICAL QUANTITIES. FOR ACTUAL QUANTITIES, REFER TO PROJECT LEDGER AND/OR COMPUTATION BOOK.

George Kirdani — RESIDENT ENGINEER — 5-13-83 DATE

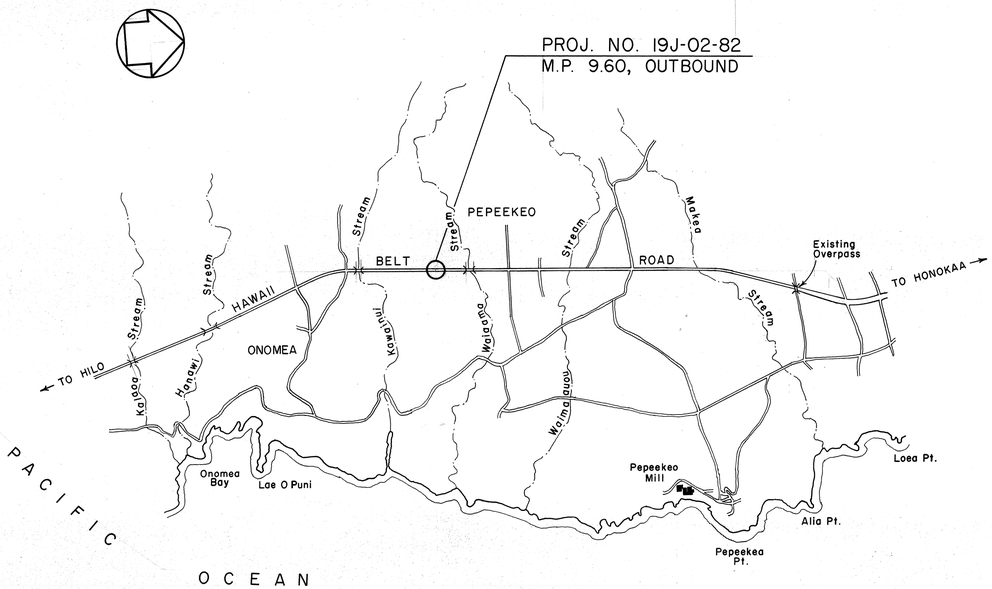

LAYOUT OF PROJECT

Unit "C"	DESIGNED BY
Robert Siarot	P. S. & E. BY
548-7537	PHONE
May, 1982	DATE

DEPARTMENT OF TRANSPORTATION
STATE OF HAWAII

APPROVED:

James R. Carras — DIR. OF TRANSPORTATION — 6/3/82 DATE