


FED. ROAD DIST. NO.	STATE	PROJ. NO.	FISCAL YEAR	SHEET NO.	TOTAL SHEETS
HAWAII	HAW.	19J-03-85M	1985	3	9

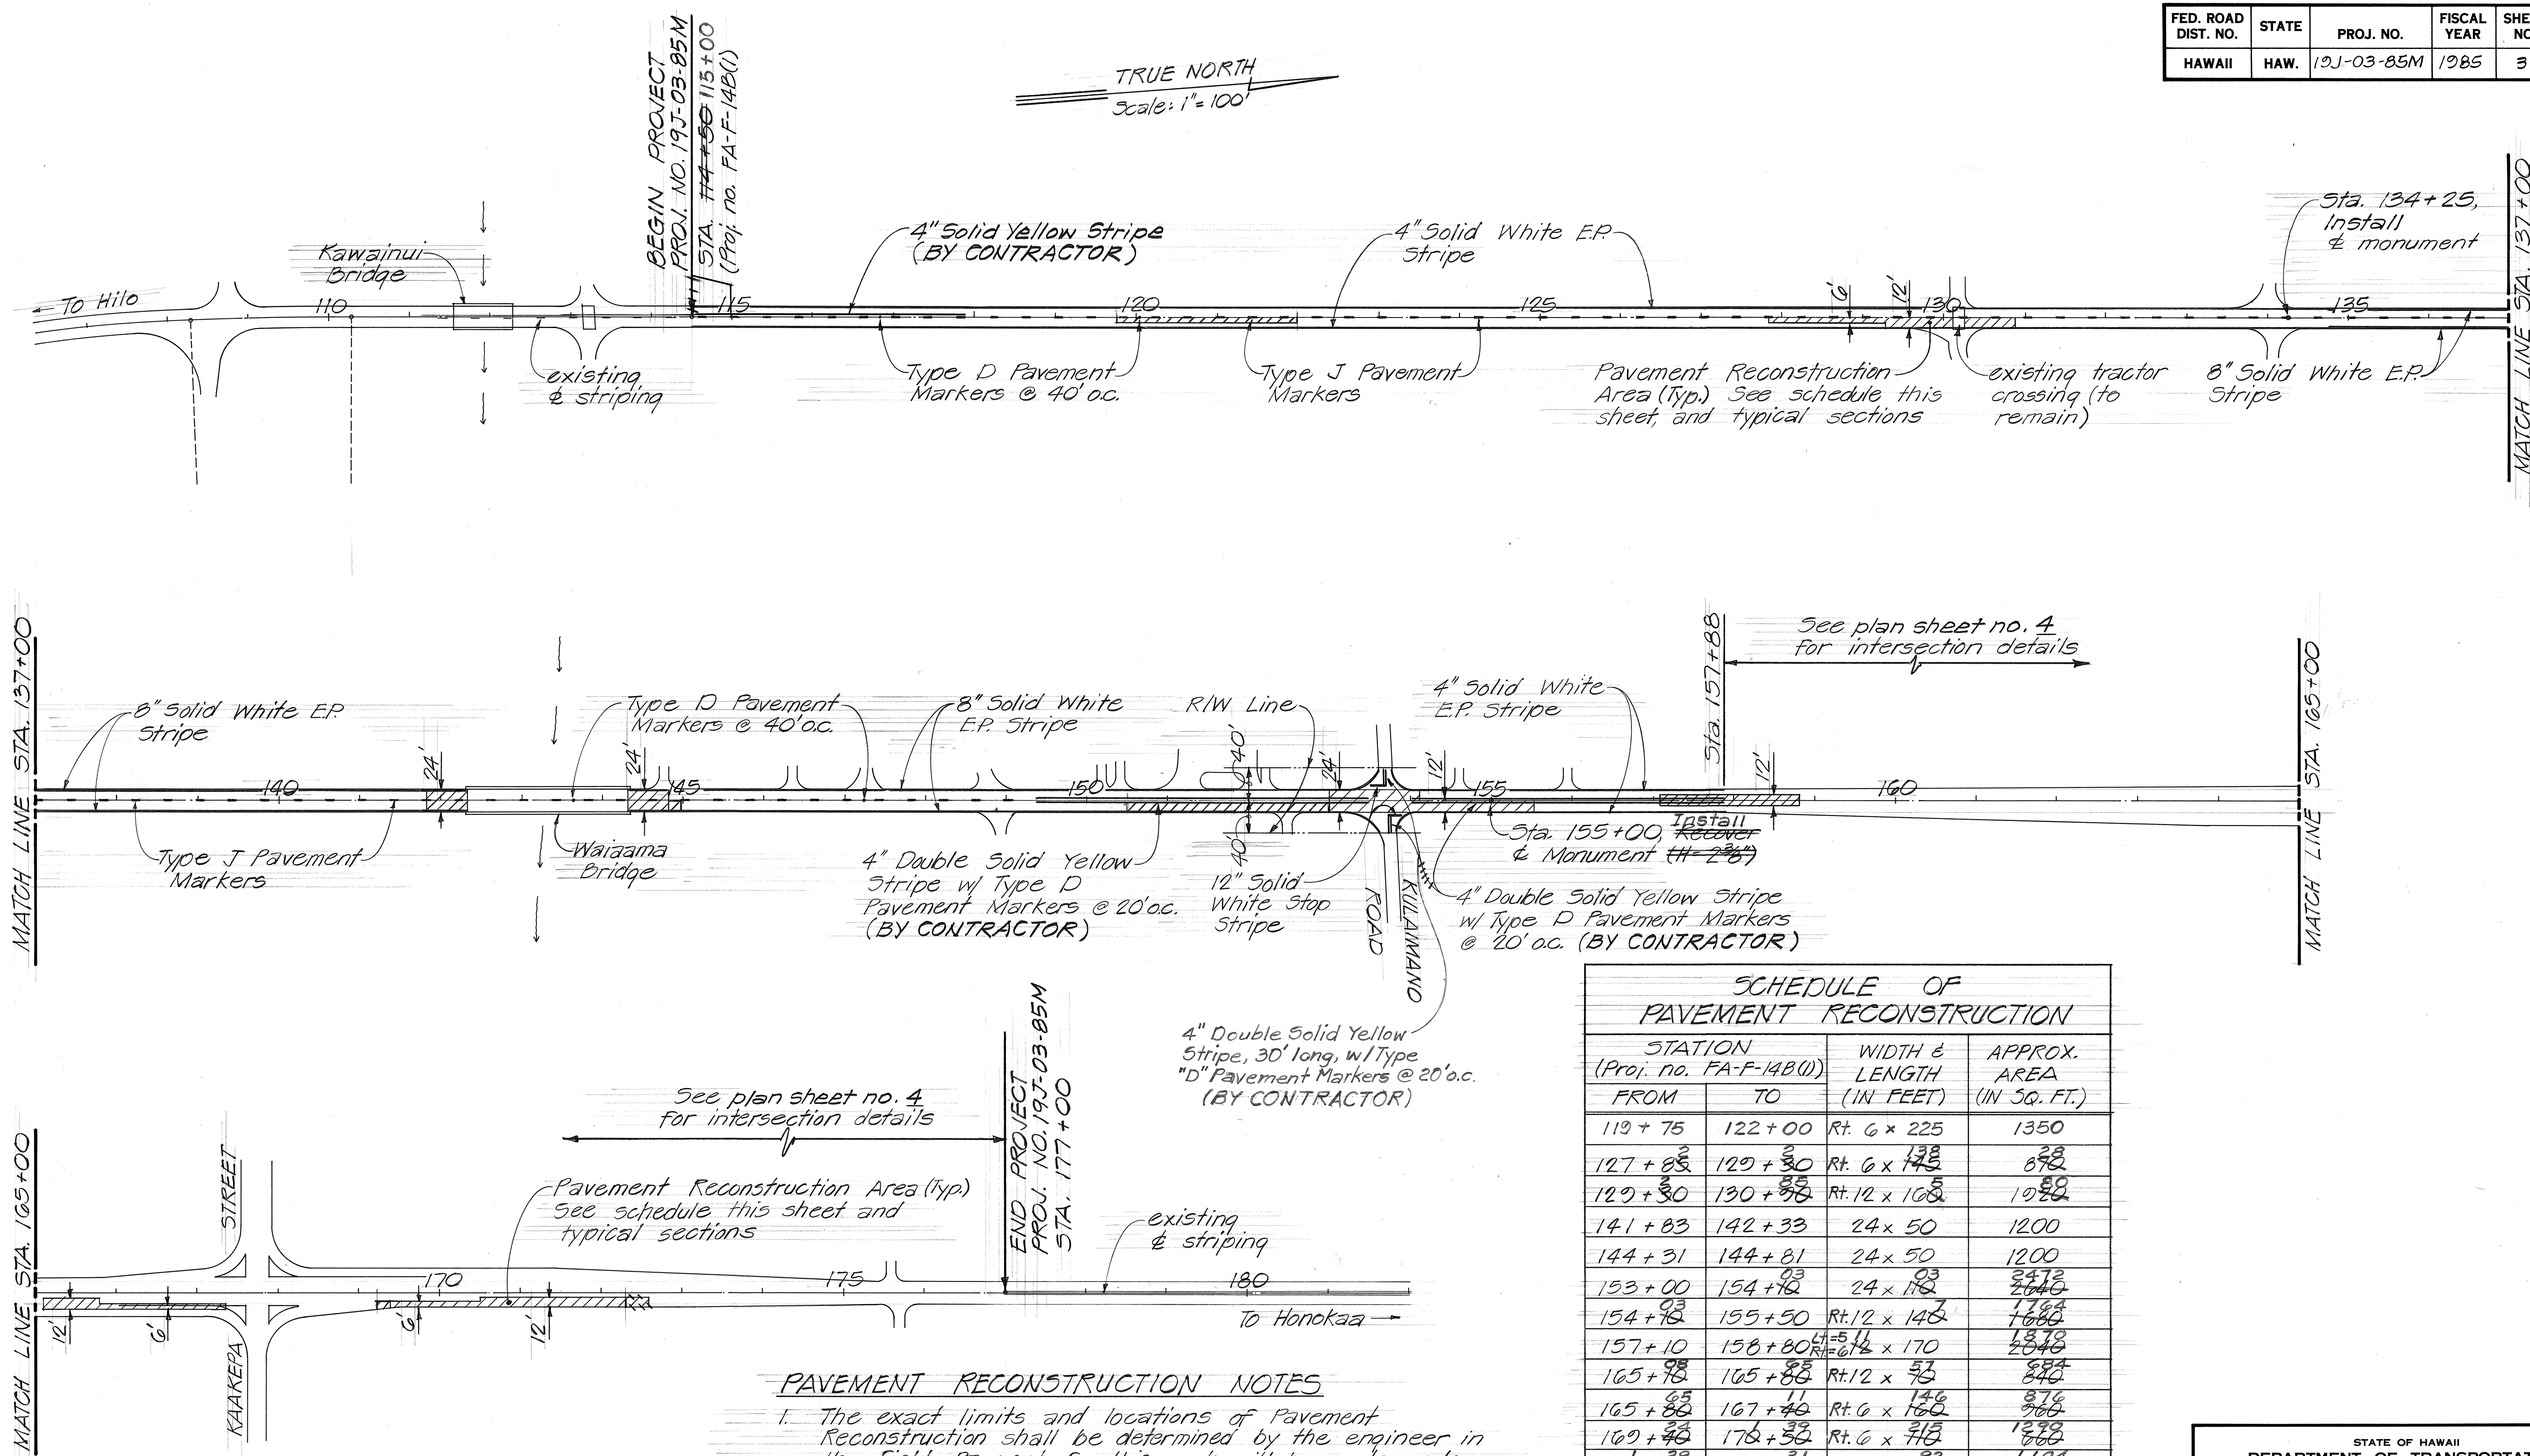

TRUE NORTH
Scale: 1" = 100'

PAVEMENT RECONSTRUCTION NOTES

1. The exact limits and locations of Pavement Reconstruction shall be determined by the engineer in the field. Payment for this work will be made under Item nos. 301.0100 - 'Plant Mix Asphalt Concrete, Base Course', and 651.0100 - 'Excavation for Reconstruction of Weakened Pavement Areas.'
2. Existing asphalt concrete pavement to be removed for pavement reconstruction shall be saw cut prior to removal.

SCHEDULE OF PAVEMENT RECONSTRUCTION			
STATION (Proj. no. FA-F-148(1))		WIDTH & LENGTH (IN FEET)	APPROX. AREA (IN SQ. FT.)
FROM	TO		
119+75	122+00	Rt. 6 x 225	1350
127+85	129+30	Rt. 6 x 145	878
129+30	130+35	Rt. 12 x 105	1260
141+83	142+33	24 x 50	1200
144+31	144+81	24 x 50	1200
153+00	154+10	24 x 110	2640
154+10	155+50	Rt. 12 x 140	1680
157+10	158+80	Rt. 12 x 170	2040
165+10	165+80	Rt. 12 x 70	840
165+80	167+40	Rt. 6 x 160	960
169+40	170+30	Rt. 6 x 90	540
170+30	172+30	Rt. 12 x 200	2400
144+81	144+97	Rt. 12 x 16	192
150+50	153+00	Rt. 12 x 250	3000
TOTAL AREA			19,810

STATE OF HAWAII
DEPARTMENT OF TRANSPORTATION
HIGHWAYS DIVISION

**STRIPING & PAV'T. MARKERS,
AND PAV'T. RECONSTRUCTION**


HAWAII BELT ROAD RESURFACING
Kawainui Bridge to Kula Road Subd
Proj. no. 19J-03-85M

Scale: 1"=100' Date: May 1985

SHEET NO. 1 OF 2 SHEETS

SURVEY PLOTTED BY	DATE
DRAWN BY	
CHECKED BY	
NOTED BY	
QUANTITIES BY	
CHECKED BY	

FED. ROAD DIST. NO.	STATE	PROJ. NO.	FISCAL YEAR	SHEET NO.	TOTAL SHEETS
HAWAII	HAW.	10J-03-85M	1985	4	9

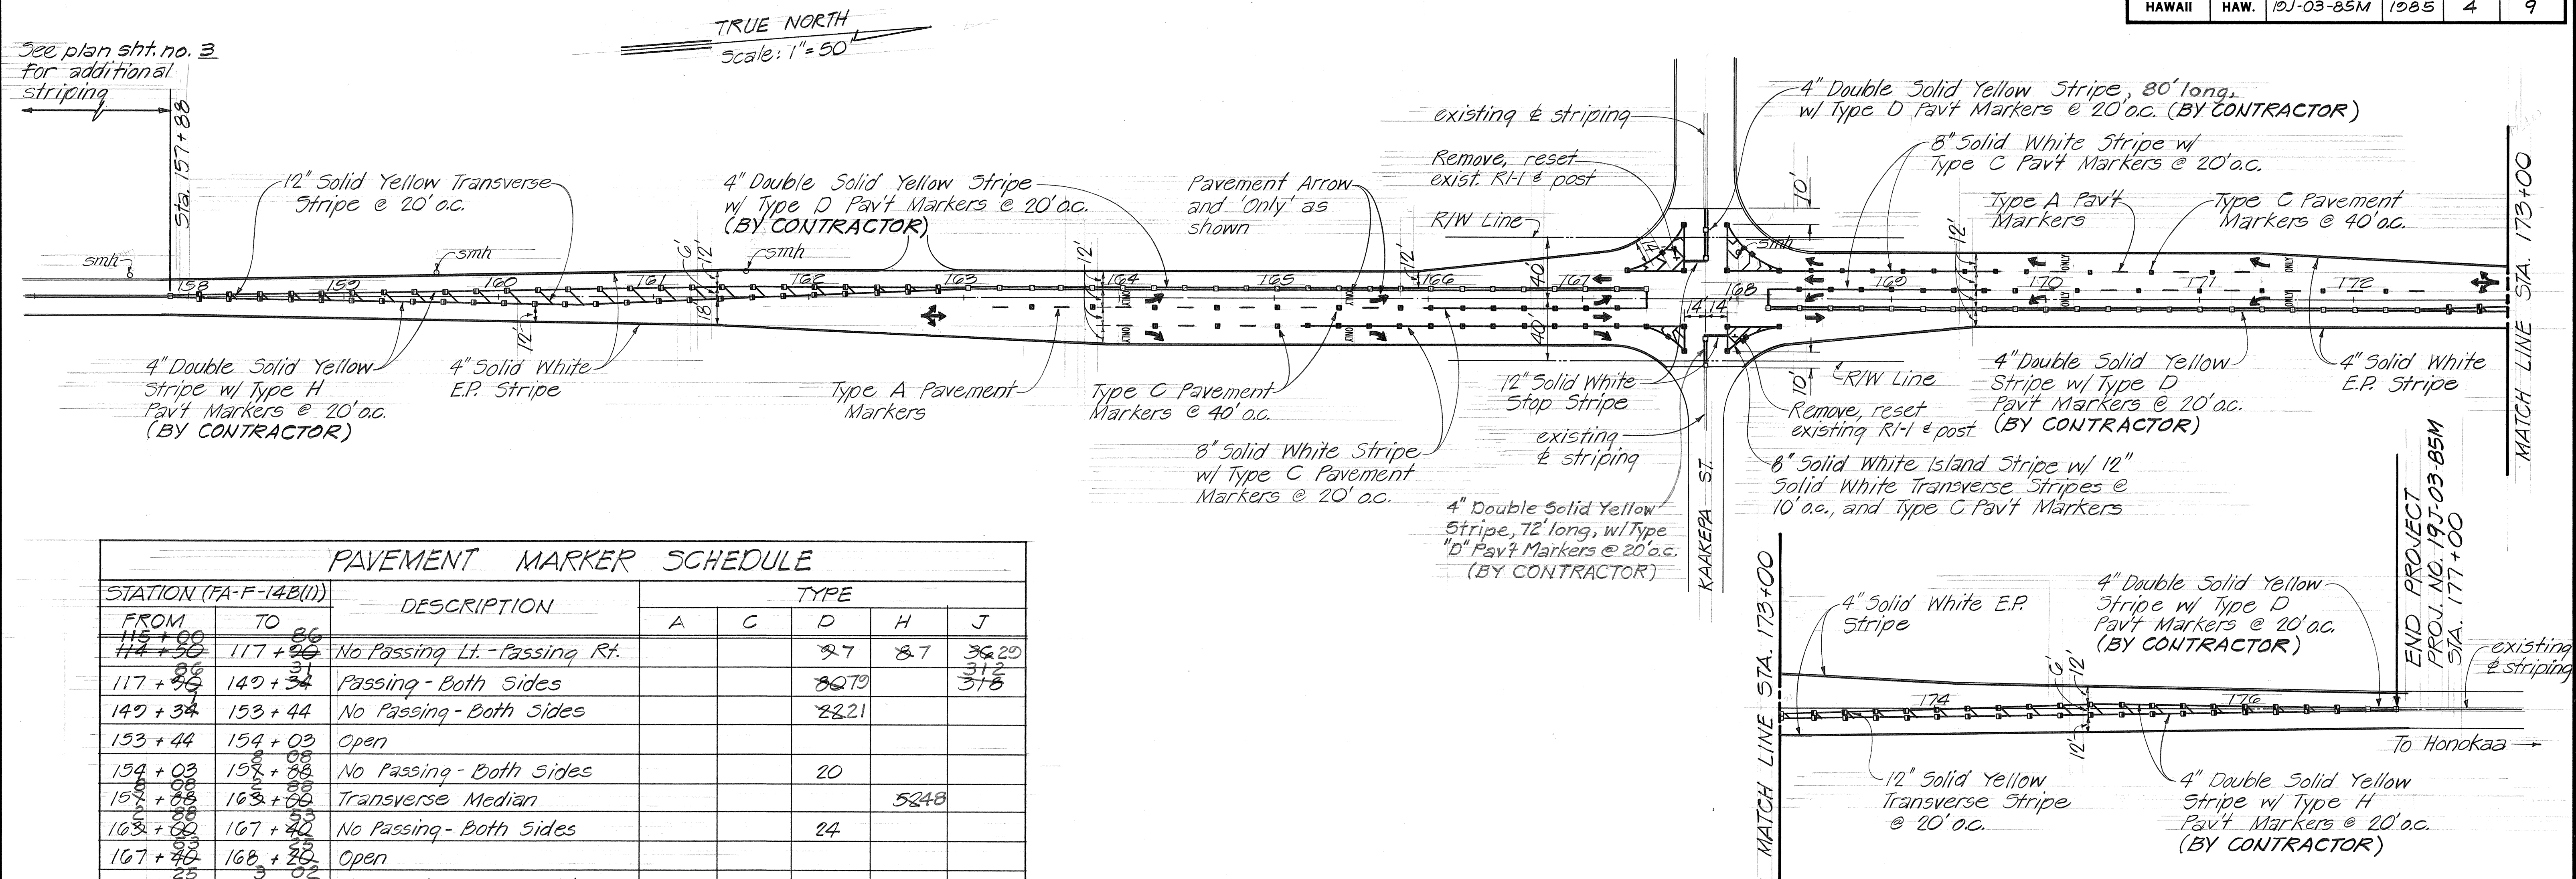[illegible]

VALVE BOX/MANHOLE RECOVERY SCHEDULE		
STATION	OFFSET	TYPE
153 + 57	27' L.	Water valve box
153 + 59	25' L.	Water valve box
153 + 77	10.5' L.	Sewer manhole
153 + 83	31.5' L.	Water valve box
168 + 01	29' L.	Sewer manhole
159 + 60	L	" "
161 + 58	L	" "

- ## PAVEMENT MARKING GENERAL NOTES
1. The Contractor shall install all pavement markers.
 2. The Contractor shall install 4" yellow centerline striping and double 4" yellow centerline striping denoted by "(BY CONTRACTOR)" as shown on the plans and as directed by the Engineer.
 3. The State Forces shall install 4" and 8" white edge of pavement striping, 8" white channelizing lane lines, 12" yellow transverse striping, 12" white transverse striping, 12" white striping for stop bar, pavement arrows and pavement words.
 4. Pavement areas where striping is to be done by State Forces shall be broomed off by the Contractor.

ORIGINAL PLAN	SURVEY PLOTTED BY _____ DATE _____
NOTE BOOK	DRAWN BY _____
	TRACED BY _____
	DESIGNED BY _____
	QUANTITIES BY _____
No. _____	CHECKED BY _____

STATE OF HAWAII
DEPARTMENT OF TRANSPORTATION
HIGHWAYS DIVISION

STRIPING AND
PAVEMENT MARKERS

HAWAII BELT ROAD RESURFACING
Kawainoini Bridge to Kulaimano Subd
Proj. no. 19J-03-85M

Scale: 1" = 50' Date: May 1985

SHEET NO. 2 OF 2 SHEETS