FED. ROAD DIST. NO.	STATE	PROJ. NO.	FISCAL YEAR	SHEET NO.	TOTAL SHEETS
HAWAII	HAW.	19G-01-85	1986	3	25

Sta. 38 + 98.97, Lt.
Construct smooth and easy riding connection to existing side road. See sheet no. 4 for details

Sta. 39 + 82 Lt.
Extend existing 5'-0" x 5'-0" concrete box culvert. See sheet nos. 6 & 7 for details.

Sta. 41 + 89 Lt.
Construct smooth and easy riding connection to existing side road (edge shoulder to R/W)

Estimated Quantities

A.C. Mix III	6 Ton
A.C. Mix V	5 Ton
Aggregate Base	7 C.Y.
Aggregate Subbase	25 C.Y.
Excavation	39 C.Y.

Sta. 39 + 70 Lt. to Sta. 41 + 27.5 Lt.
Install 163 L.F. New Metal Guard Rail w/ Steel Posts

Sta. 43 + 55 Lt.
Extend existing 36" RCP culvert. See sheet no. 5 for details

Sta. 42 + 50 Lt. to Sta. 46 + 75 Lt.
Remove and reset 425 L.F. exist. metal guard rail w/ steel posts. See Typical Sections for details.

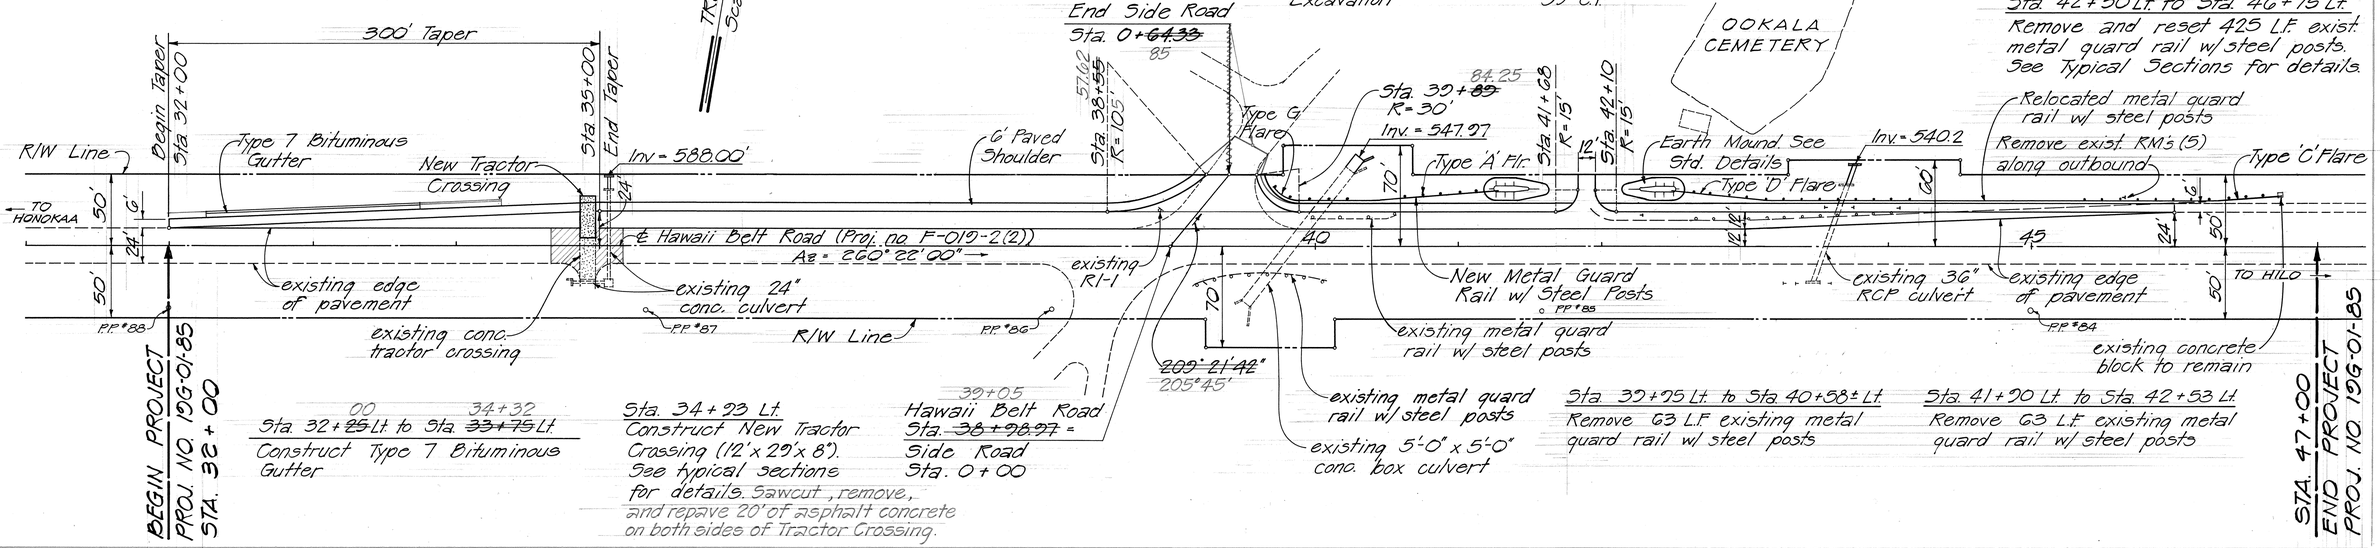

Sta. 32 + ~~25~~ 00 Lt. to Sta. ~~33 + 75~~ 34 + 32 Lt.
Construct Type 7 Bituminous Gutter

Sta. 34 + 23 Lt.
Construct New Tractor Crossing (12' x 29' x 8"). See typical sections for details. Sawcut, remove, and repave 20' of asphalt concrete on both sides of Tractor Crossing.

Hawaii Belt Road Sta. ~~38 + 98.97~~ 39 + 05 = Side Road Sta. 0 + 00

Sta. 39 + 75 Lt. to Sta. 40 + 58± Lt.
Remove 63 L.F. existing metal guard rail w/ steel posts

Sta. 41 + 90 Lt. to Sta. 42 + 53 Lt.
Remove 63 L.F. existing metal guard rail w/ steel posts

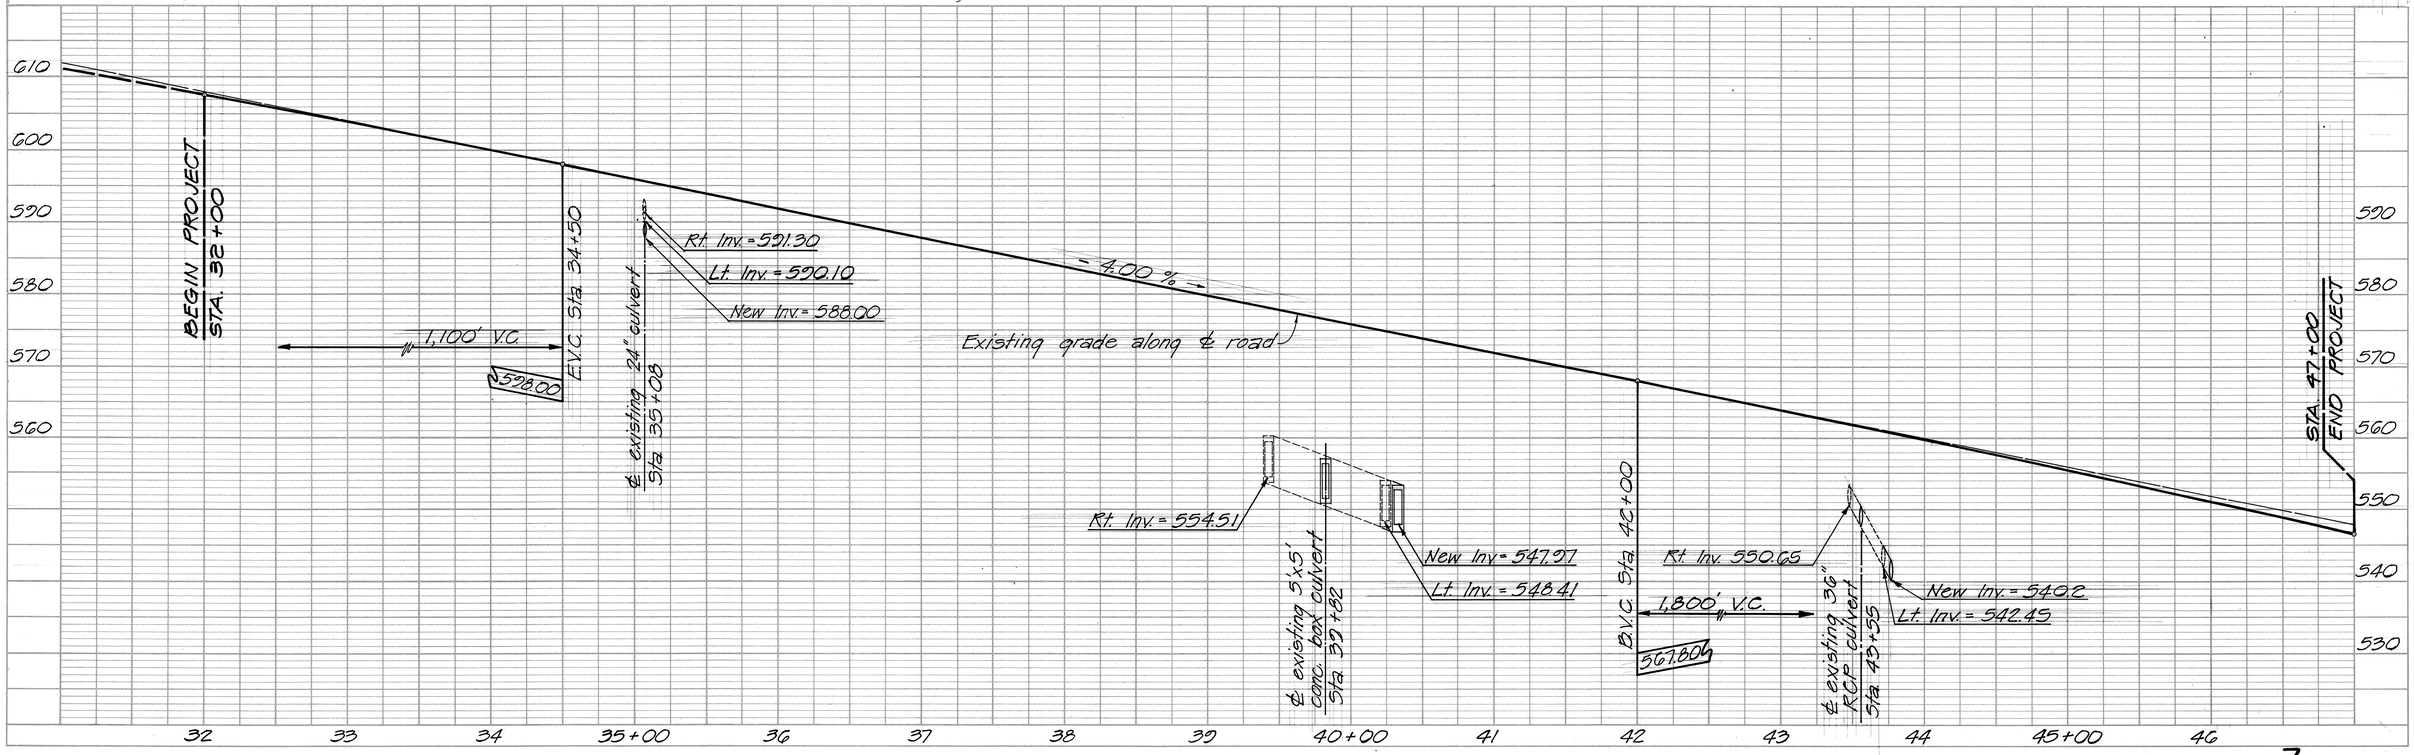

PLAN — SURVEYED, PLOTTED, ALIGNMENT CHECKED, RT. OF WAY CHECKED, NOTE BOOK NO., BY, DATE

PROFILE — SURVEYED, PLOTTED, GRADES CHECKED, B.M.'S NOTED, STRUCTURE NOTATIONS CH'KD., NOTE BOOK NO., BY, DATE

PLATE 1—PLAN PROFILE B. P. R. STANDARD
THE FREDERICK POST CO., CHICAGO