FED. ROAD DIST. NO.	STATE	PROJ. NO.	FISCAL YEAR	SHEET NO.	TOTAL SHEETS
HAWAII	HAW.	19G-01-85	1986	1	25

INDEX TO DRAWINGS

SHEET NO.	DESCRIPTION
1	TITLE SHEET
2	TYPICAL SECTIONS
3	PLAN & PROFILE
4	SIDEROAD DETAILS, GEN. NOTES
5-7	DRAINAGE DETAILS
8	TRAFFIC SIGNS, STRIPING, AND PAVEMENT MARKERS
9-11	CROSS SECTIONS
12-25	STANDARD DETAILS

STATE OF HAWAII

DEPARTMENT OF TRANSPORTATION

HIGHWAYS DIVISION

"AS-BUILT"

PLANS FOR

HAWAII BELT ROAD

EXTEND TRUCK CLIMBING LANE

Vicinity of Ookala Cemetery

PROJECT NO. 19G-01-85

DISTRICT OF NORTH HILO
ISLAND OF HAWAII

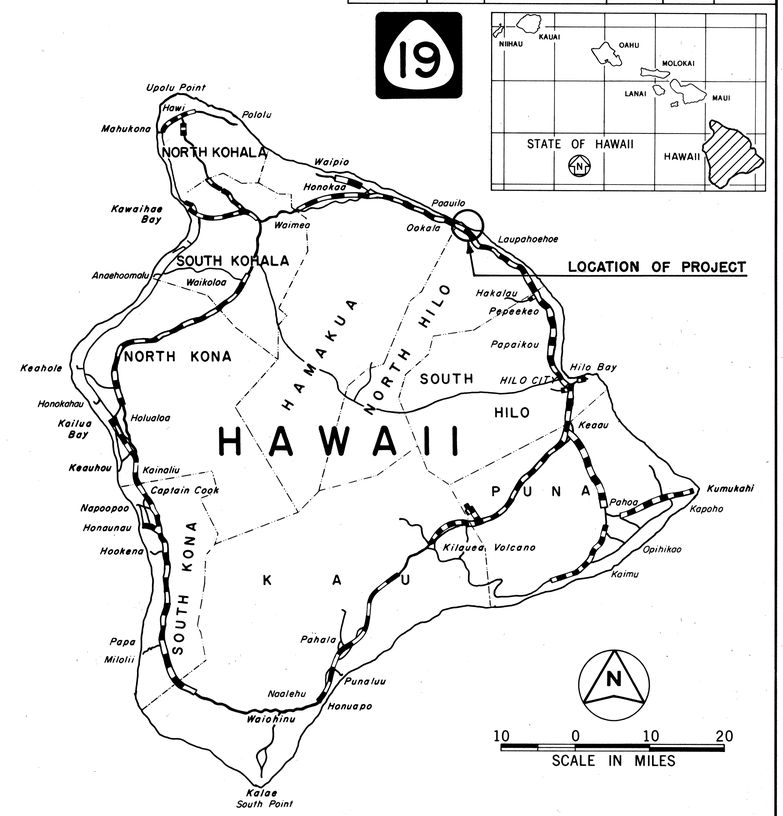

FEDERAL AID PROJECTS PREVIOUSLY CONSTRUCTED OR UNDER CONSTRUCTION

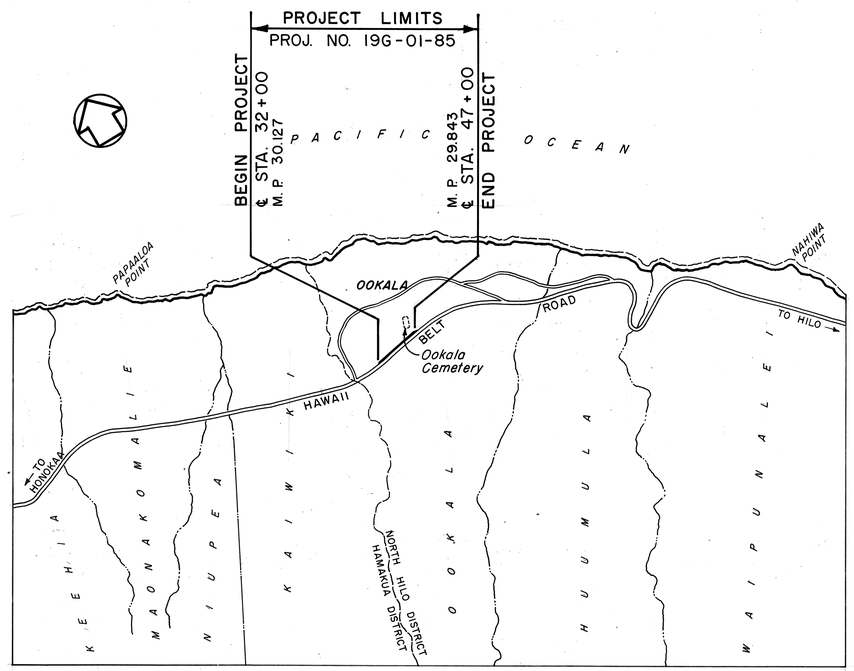

GENERAL LAYOUT PLAN

2 1 0 2 4 6
SCALE IN THOUSAND FEET

CHANGES MADE DURING CONSTRUCTION HAVE BEEN INCORPORATED ON THESE PLANS EXCEPT CHANGES IN THE ORIGINAL THEORETICAL QUANTITIES. FOR ACTUAL QUANTITIES, REFER TO PROJECT LEDGER AND/OR COMPUTATION BOOK.

Stanley Tamura — 3-17-88
RESIDENT ENGINEER — DATE

GROSS & NET LENGTH OF PROJECT . . . . . 0.284 Mi.

DEPARTMENT OF TRANSPORTATION
STATE OF HAWAII

APPROVED:

Cheryl D. Soon — 12/1/85
DIR. OF TRANSPORTATION — DATE

HAWAII DISTRICT — DESIGNED BY
R. SIAROT — P. S. & E. BY
548-7537 — PHONE
SEPT. 1985 — DATE