FED. ROAD DIST. NO.	STATE	PROJ. NO.	FISCAL YEAR	SHEET NO.	TOTAL SHEETS
HAWAII	HAW.	19J-01-86	1986	1	17

INDEX TO DRAWINGS

SHEET NO.	DESCRIPTION
1	TITLE SHEET
2-4	LAYOUT OF PROJECT, TYPICAL SECTIONS, DETAILS & NOTES
5,6	GUARDRAIL SCHEDULE
7-9	ROADWAY PLANS
10-17	TYPICAL & STANDARD DETAILS

STATE OF HAWAII

DEPARTMENT OF TRANSPORTATION

HIGHWAYS DIVISION

"AS-BUILT"

PLANS FOR

HAWAII BELT ROAD - ROUTE 19

GUARDRAIL IMPROVEMENTS

HONOLII TO HAKALAU

PROJECT NO. 19J-01-86

DISTRICT OF SOUTH HILO

ISLAND OF HAWAII

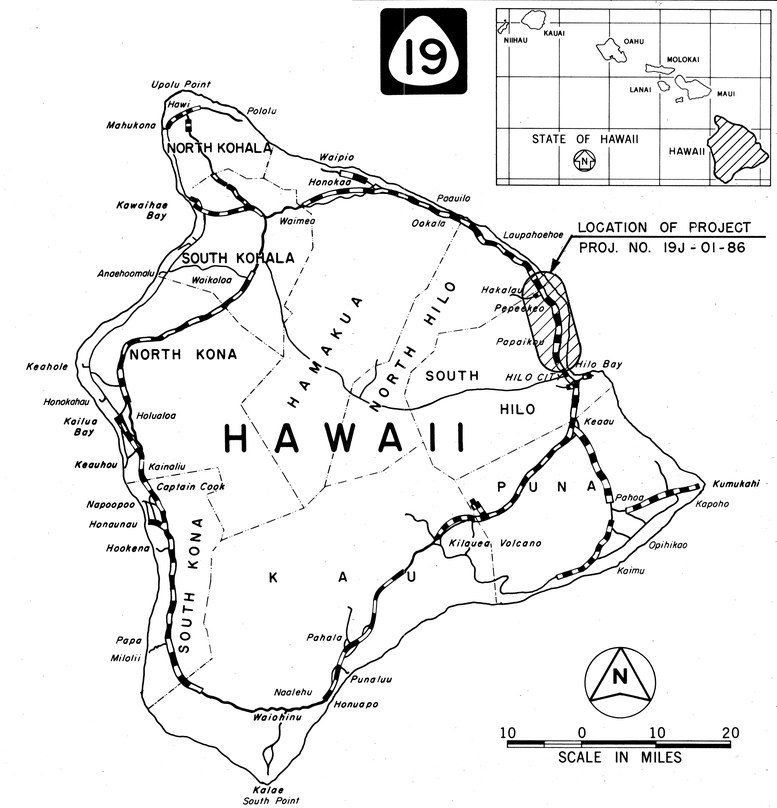

FEDERAL AID PROJECTS PREVIOUSLY CONSTRUCTED OR UNDER CONSTRUCTION

CHANGES MADE DURING CONSTRUCTION HAVE BEEN INCORPORATED ON THESE PLANS EXCEPT CHANGES IN THE ORIGINAL THEORETICAL QUANTITIES. FOR ACTUAL QUANTITIES, REFER TO PROJECT LEDGER AND/OR COMPUTATION BOOK.

Dennis K. Shigesako — May 19, 1987

RESIDENT ENGINEER — DATE

DEPARTMENT OF TRANSPORTATION
STATE OF HAWAII

APPROVED:

Cheryl D. Soon — 5/16/86

DIR. OF TRANSPORTATION — DATE

Hawaii District — DESIGNED BY

Roy T. Nagasako — P. S. & E. BY

548-2456 — PHONE

MAY, 1986 — DATE