FED. ROAD DIST. NO.	STATE	PROJ. NO.	FISCAL YEAR	SHEET NO.	TOTAL SHEETS
HAWAII	HAW.	19A-01-87M	1987	1	7

INDEX TO DRAWINGS

SHEET NO.	DESCRIPTION
1	TITLE SHEET
2	STANDARD PLANS SUMMARY
3	TYPICAL SECTIONS AND DETAILS
(1) 4 – 6	ROADWAY PLANS AND SCHEDULES
7	CONSTRUCTION SIGN PLAN

(1) 6 S-1 IS SUPPLEMENT SHEET TO THE CONTRACT PLANS. TOTAL = 8

STATE OF HAWAII

DEPARTMENT OF TRANSPORTATION

HIGHWAYS DIVISION

"AS BUILT"

PLANS FOR

QUEEN KAAHUMANU HIGHWAY

SHOULDER IMPROVEMENTS

PALANI ROAD TOWARDS KEAHOLE AIRPORT

PROJ. NO. 19A-01-87M

DISTRICT OF NORTH KONA

ISLAND OF HAWAII

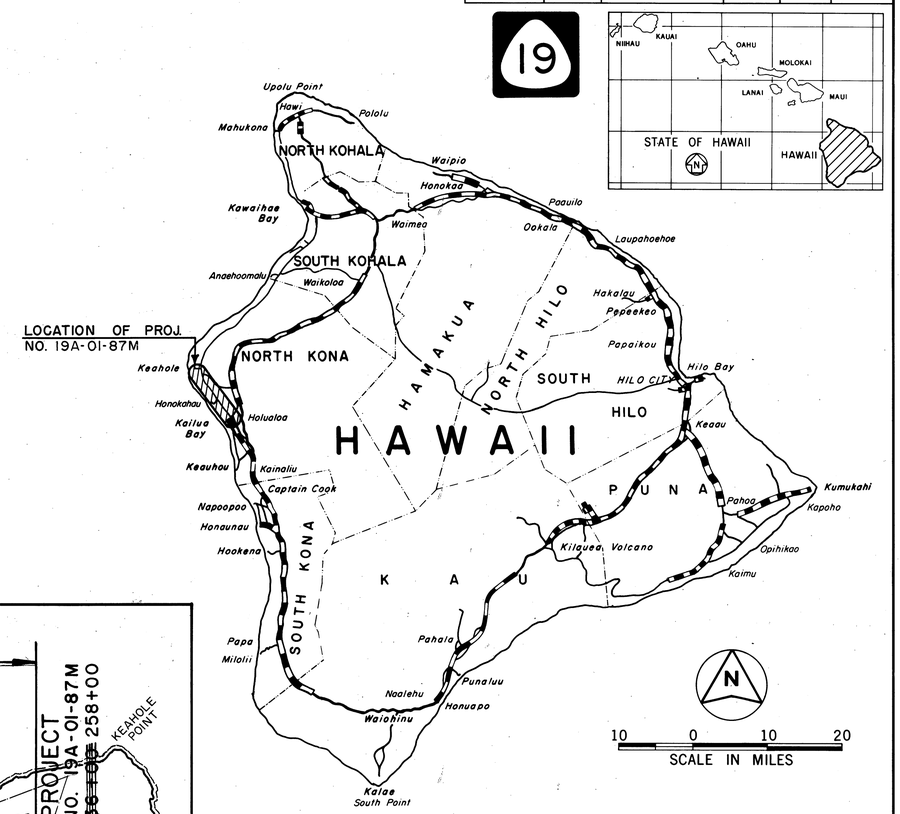

FEDERAL AID PROJECTS PREVIOUSLY CONSTRUCTED OR UNDER CONSTRUCTION

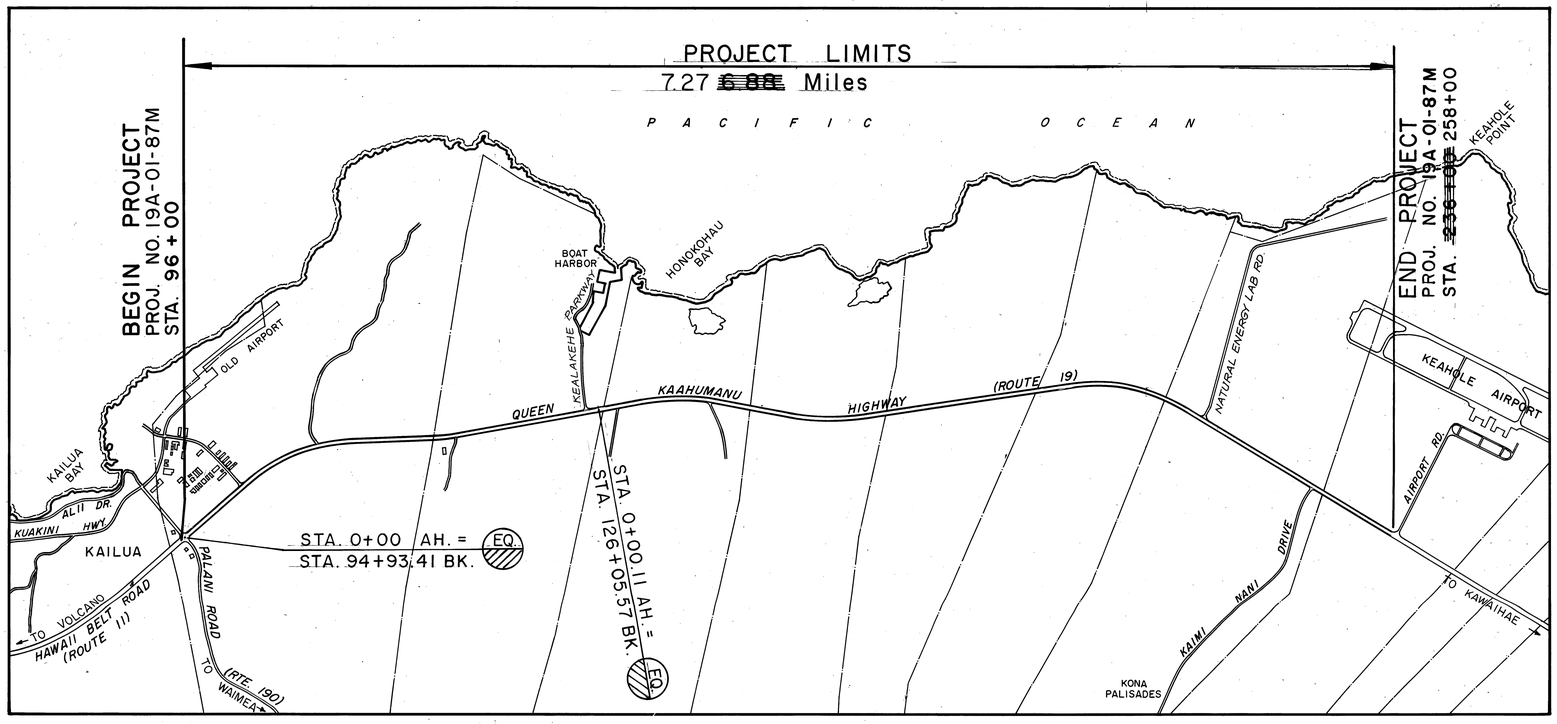

LAYOUT PLAN

2 1 0 2 4 6
SCALE IN THOUSAND FEET

CHANGES MADE DURING CONSTRUCTION HAVE BEEN INCORPORATED ON THESE PLANS EXCEPT CHANGES IN THE ORIGINAL THEORETICAL QUANTITIES. FOR ACTUAL QUANTITIES, REFER TO PROJECT LEDGER AND/OR COMPUTATION BOOK.

Roy Shioji — 2/22/89
RESIDENT ENGINEER — DATE

DEPARTMENT OF TRANSPORTATION
STATE OF HAWAII

APPROVED:

for A. Harano — 6/4/87
DIR. OF TRANSPORTATION — DATE

HAWAII DISTRICT — APRIL, 1987
DESIGNED BY — DATE

R. TAKAESU — 548-4125
P. S. & E. BY — PHONE