FED. ROAD DIST. NO.	STATE	PROJ. NO.	FISCAL YEAR	SHEET NO.	TOTAL SHEETS
HAWAII	HAW.	19G-02-88M	1988	1	13

INDEX TO DRAWINGS

SHEET NO.	DESCRIPTION
1	TITLE SHEET
2	STANDARD PLANS SUMMARY
3	TYPICAL SECTION & BRIDGE APPROACH DETAILS
4-7	RESURFACING & RECONSTRUCTION PLANS
8-11	STRIPING & PAVEMENT MARKER PLANS
12	PAVEMENT RECONSTRUCTION SCHEDULE & DETAILS
13	PAVEMENT MARKER & CENTERLINE MONUMENT SCHEDULES

STATE OF HAWAII

DEPARTMENT OF TRANSPORTATION

HIGHWAYS DIVISION

"AS-BUILT"

PLANS FOR

HAWAII BELT ROAD RESURFACING

KAHAWAILIILII TO PAAUILO

PROJECT NO. 19G-02-88M

DISTRICT OF HAMAKUA
ISLAND OF HAWAII

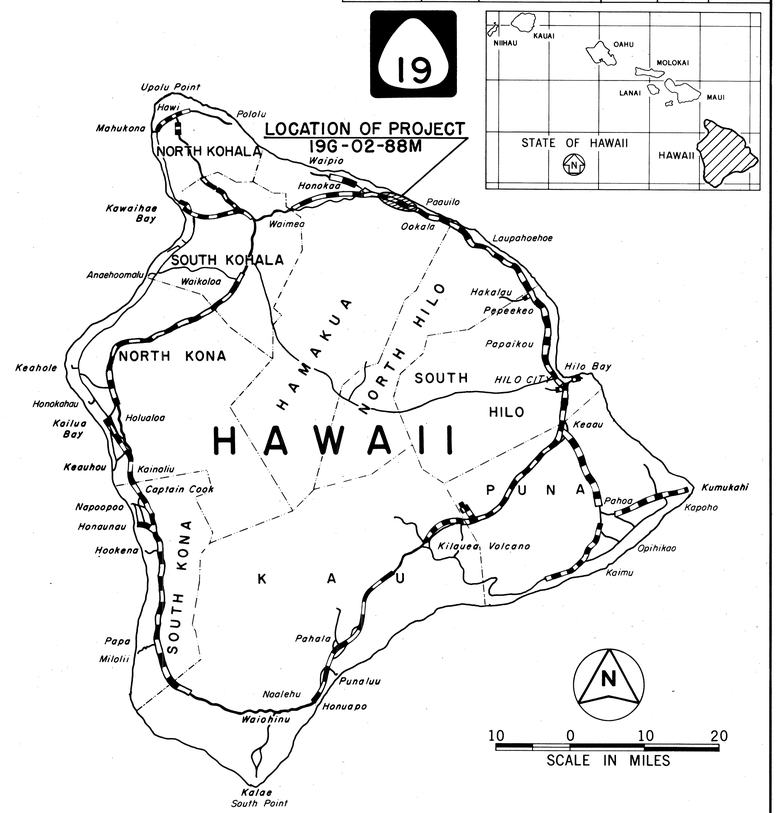

FEDERAL AID PROJECTS PREVIOUSLY CONSTRUCTED OR UNDER CONSTRUCTION

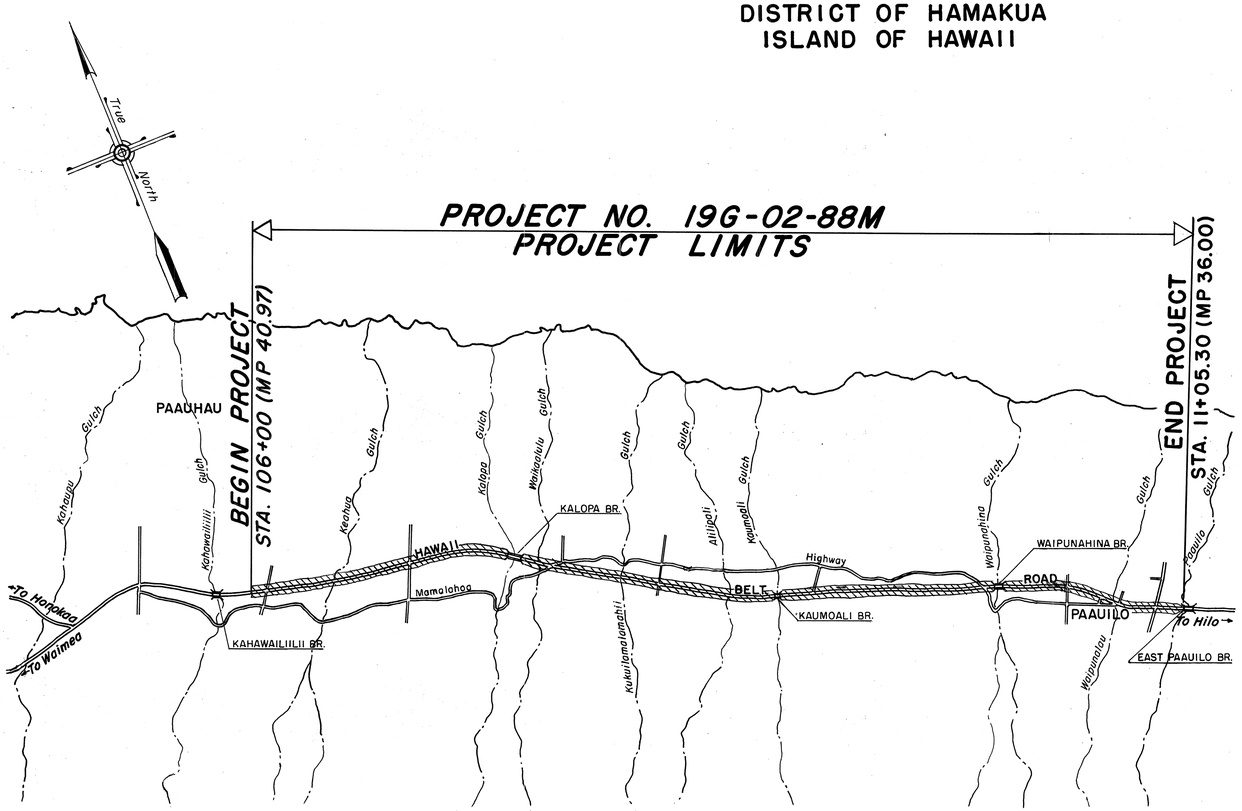

GENERAL LAYOUT PLAN

SCALE: 1" = 2000'

CHANGES MADE DURING CONSTRUCTION HAVE BEEN INCORPORATED ON THESE PLANS EXCEPT CHANGES IN THE ORIGINAL THEORETICAL QUANTITIES. FOR ACTUAL QUANTITIES, REFER TO PROJECT LEDGER AND/OR COMPUTATION BOOK.

Robert Y. W. Lee, Jr. — RESIDENT ENGINEER

11-23-88 — DATE

HAWAII DISTRICT	ROY NAGASAKO	548-2456	SEPT., 1987
DESIGNED BY	P. S. & E. BY	PHONE	DATE

DEPARTMENT OF TRANSPORTATION
STATE OF HAWAII

APPROVED:

Edward H. Sato — DIR. OF TRANSPORTATION

10/19/87 — DATE

DD-A-5-B