FED. ROAD DIST. NO.	STATE	PROJ. NO.	FISCAL YEAR	SHEET NO.	TOTAL SHEETS
HAWAII	HAW.	19HJ-01-89M	1989	1	6

INDEX TO DRAWINGS

SHEET NO.	DESCRIPTION
1	TITLE SHEET
2	STANDARD PLANS SUMMARY
3	HONOLII BRIDGE PLANS
4	KOLEKOLE BRIDGE PLANS
5	HAKALAU BRIDGE PLANS
6	MISCELLANEOUS DETAILS & NOTES

STATE OF HAWAII

DEPARTMENT OF TRANSPORTATION

HIGHWAYS DIVISION

HONOLULU, HAWAII

AS BUILT

PLANS FOR

HAWAII BELT ROAD - VARIOUS BRIDGES

REPAIR EXPANSION JOINTS AND RESURFACE DECKS

PROJECT NO. 19HJ-01-89M

DISTRICT OF SOUTH HILO

ISLAND OF HAWAII

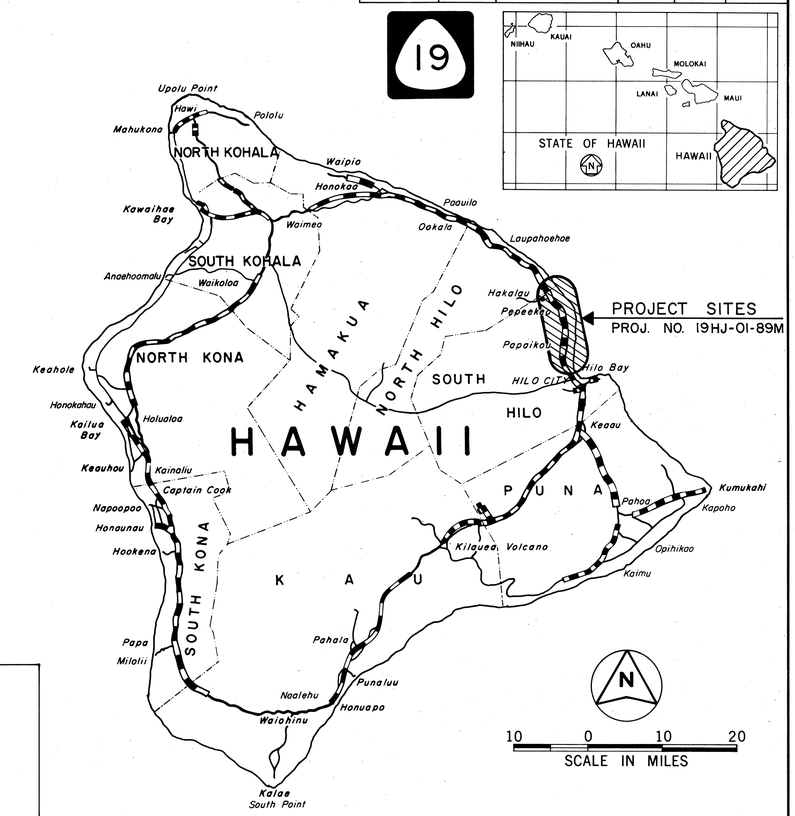

FEDERAL AID PROJECTS PREVIOUSLY CONSTRUCTED OR UNDER CONSTRUCTION

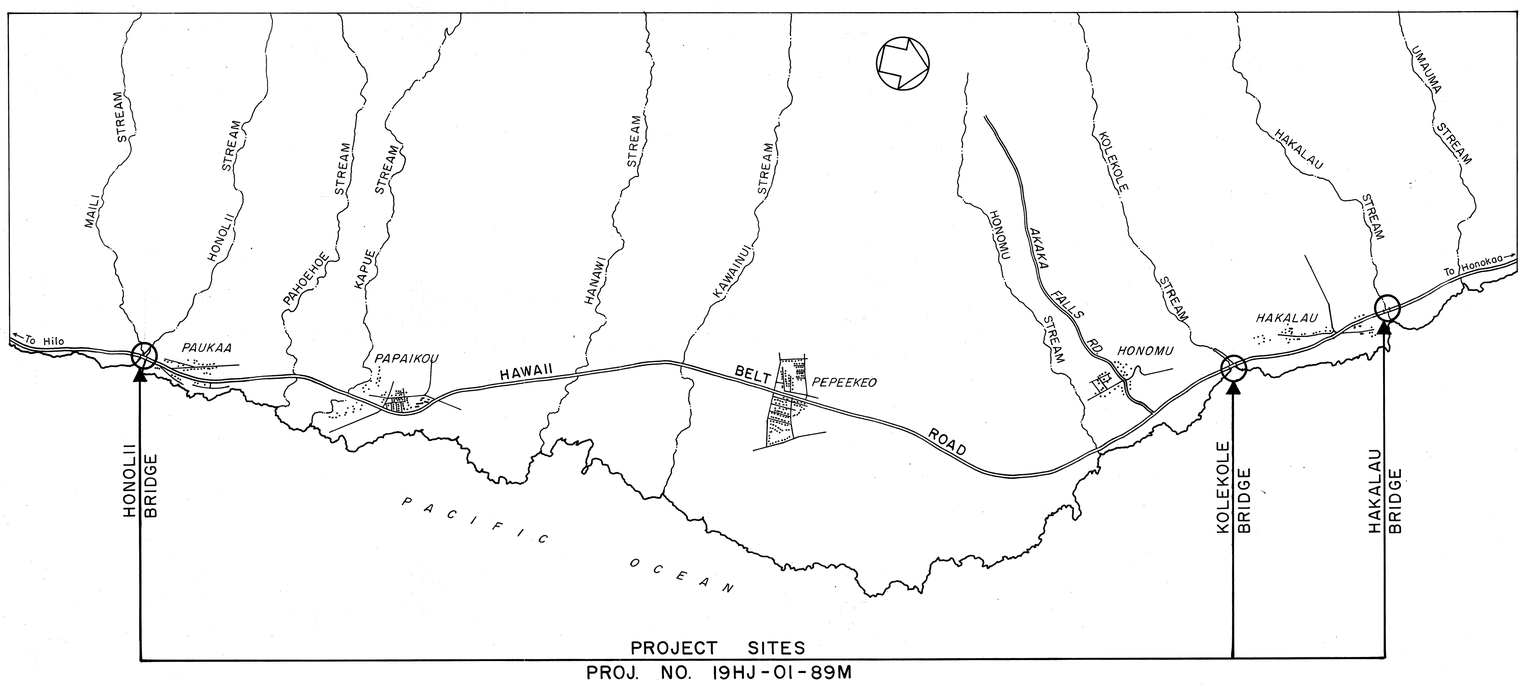

PROJECT SITES

PROJ. NO. 19HJ-01-89M

LAYOUT OF PROJECT

0.5 0 1 2

SCALE IN MILES

CHANGES MADE DURING CONSTRUCTION HAVE BEEN INCORPORATE ON THESE PLANS EXCEPT CHANGES IN THE ORIGINAL THEORETICAL QUANTITIES.

E. Shaw — 9 April 1991

RESIDENT ENGINEER — DATE

DEPARTMENT OF TRANSPORTATION
STATE OF HAWAII

APPROVED:

Edward Sakuda — 5/19/89

DIR. OF TRANSPORTATION — DATE

HAWAII DISTRICT — DESIGNED BY

R. TAKAESU "A" — P. S. & E. BY

4125 — PHONE

MAY, 1989 — DATE

DD-A-4-6