FED. ROAD DIST. NO.	STATE	PROJ. NO.	FISCAL YEAR	SHEET NO.	TOTAL SHEETS
HAWAII	HAW.	19G-01-90M	1990	1	6

INDEX TO DRAWINGS

SHEET NO.	DESCRIPTION
1	TITLE SHEET
2	STANDARD PLAN SUMMARY
3	TYPICAL SECTIONS
4-5	ROADWAY, STRIPING AND CONSTRUCTION SIGN PLAN
6	MISCELLANEOUS SCHEDULES

STATE OF HAWAII

DEPARTMENT OF TRANSPORTATION

HIGHWAYS DIVISION

HONOLULU, HAWAII

"AS BUILT"

PLANS FOR

HAWAII BELT ROAD RESURFACING
EAST PAAUILO BRIDGE TO MOHUNA BRIDGE
PROJECT NO. 19G-01-90M

DISTRICT OF HAMAKUA

ISLAND OF HAWAII

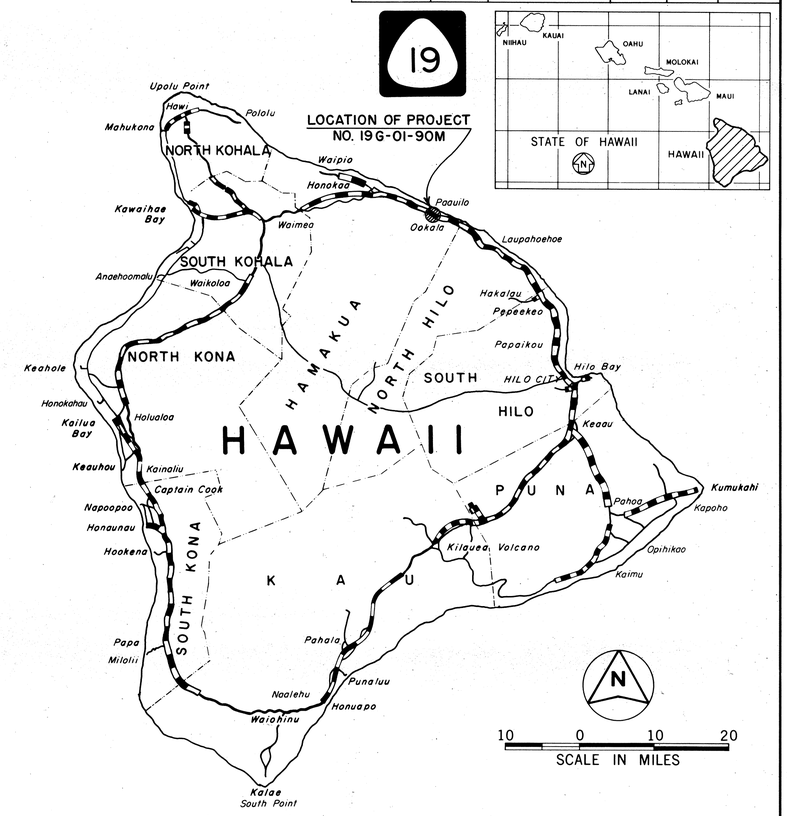

FEDERAL AID PROJECTS PREVIOUSLY CONSTRUCTED OR UNDER CONSTRUCTION

MILE POST 33.~~62~~ (.01) TO MILE POST 35.~~89~~ (.95)

CHANGES MADE DURING CONSTRUCTION HAVE BEEN INCORPORATED ON THESE PLANS EXCEPT CHANGES IN THE ORIGINAL THEORETICAL QUANTITIES. FOR ACTUAL QUANTITIES, REFER TO PROJECT LEDGER AND/OR COMPUTATION BOOK.

E. Obara — RESIDENT ENGINEER — 03-28-91 DATE

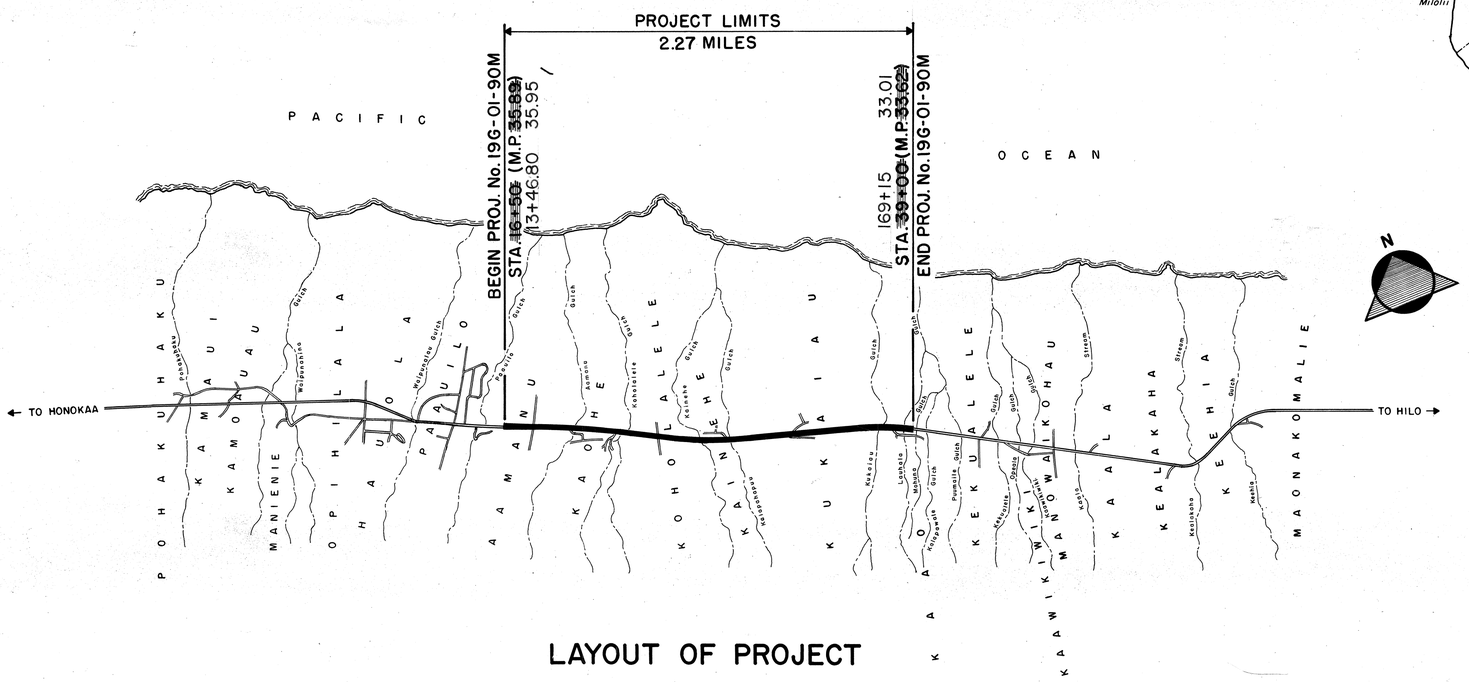

HAWAII DISTRICT DESIGNED BY	A. NISHIMURA P. S. & E. BY	548-7490 PHONE	JAN. 1990 DATE

DEPARTMENT OF TRANSPORTATION
STATE OF HAWAII

APPROVED:

DIR. OF TRANSPORTATION — 2/6/90 DATE

D0-4-4