


FED. ROAD DIST. NO.	STATE	FED. AID PROJ. NO.	FISCAL YEAR	SHEET NO.	TOTAL SHEETS

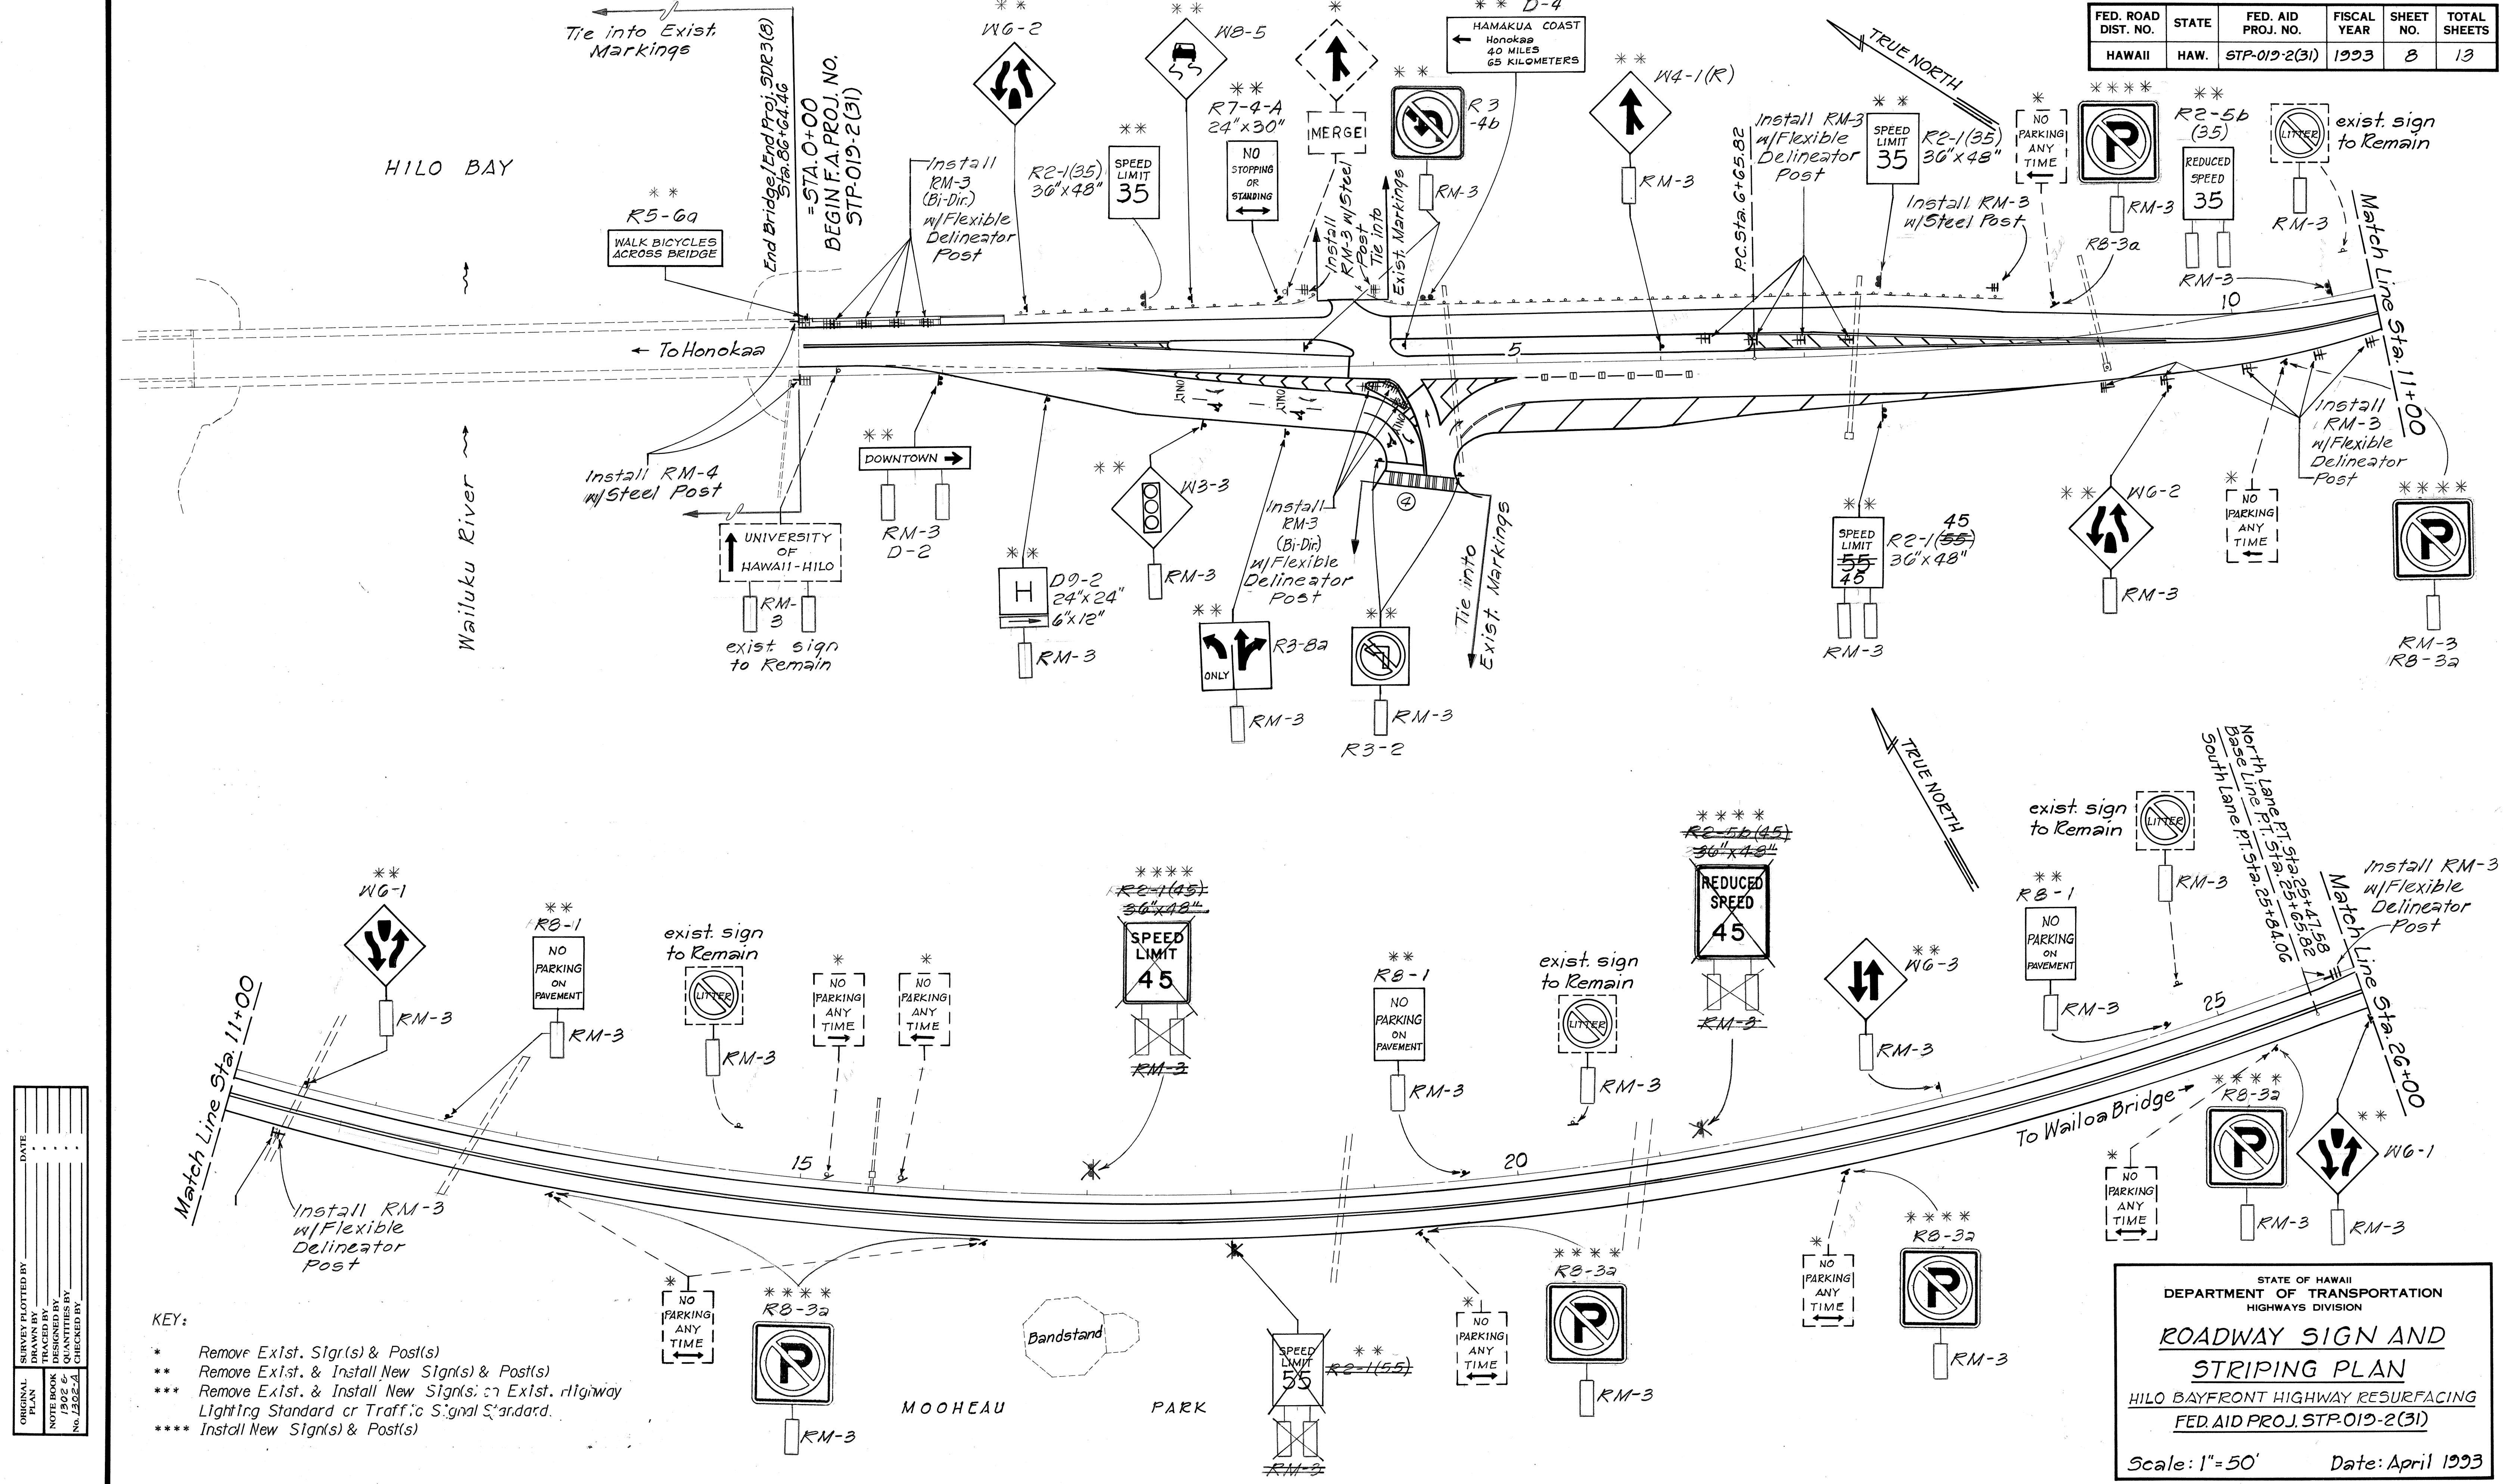

ORIGINAL PLAN	DATE
SURVEY PLOTTED BY	
DRAWN BY	
DESIGNED BY	
CHECKED BY	
NOTED BY	
NO. 1302-A	

- KEY:
- * Remove Exist. Sign(s) & Post(s)
 - ** Remove Exist. & Install New Sign(s) & Post(s)
 - *** Remove Exist. & Install New Sign(s) on Exist. Highway Lighting Standard or Traffic Signal Standard.
 - **** Install New Sign(s) & Post(s)


STATE OF HAWAII
DEPARTMENT OF TRANSPORTATION
HIGHWAYS DIVISION

ROADWAY SIGN AND
STRIPING PLAN
HILO BAYFRONT HIGHWAY RESURFACING

Scale: 1"=50'
Date: April 1993

SHEET No. 1 OF 2 SHEETS

FED. ROAD DIST. NO.	STATE	FED. AID PROJ. NO.	FISCAL YEAR	SHEET NO.	TOTAL SHEETS
HAWAII	HAW.	STP-019-2(31)	1993	9	13

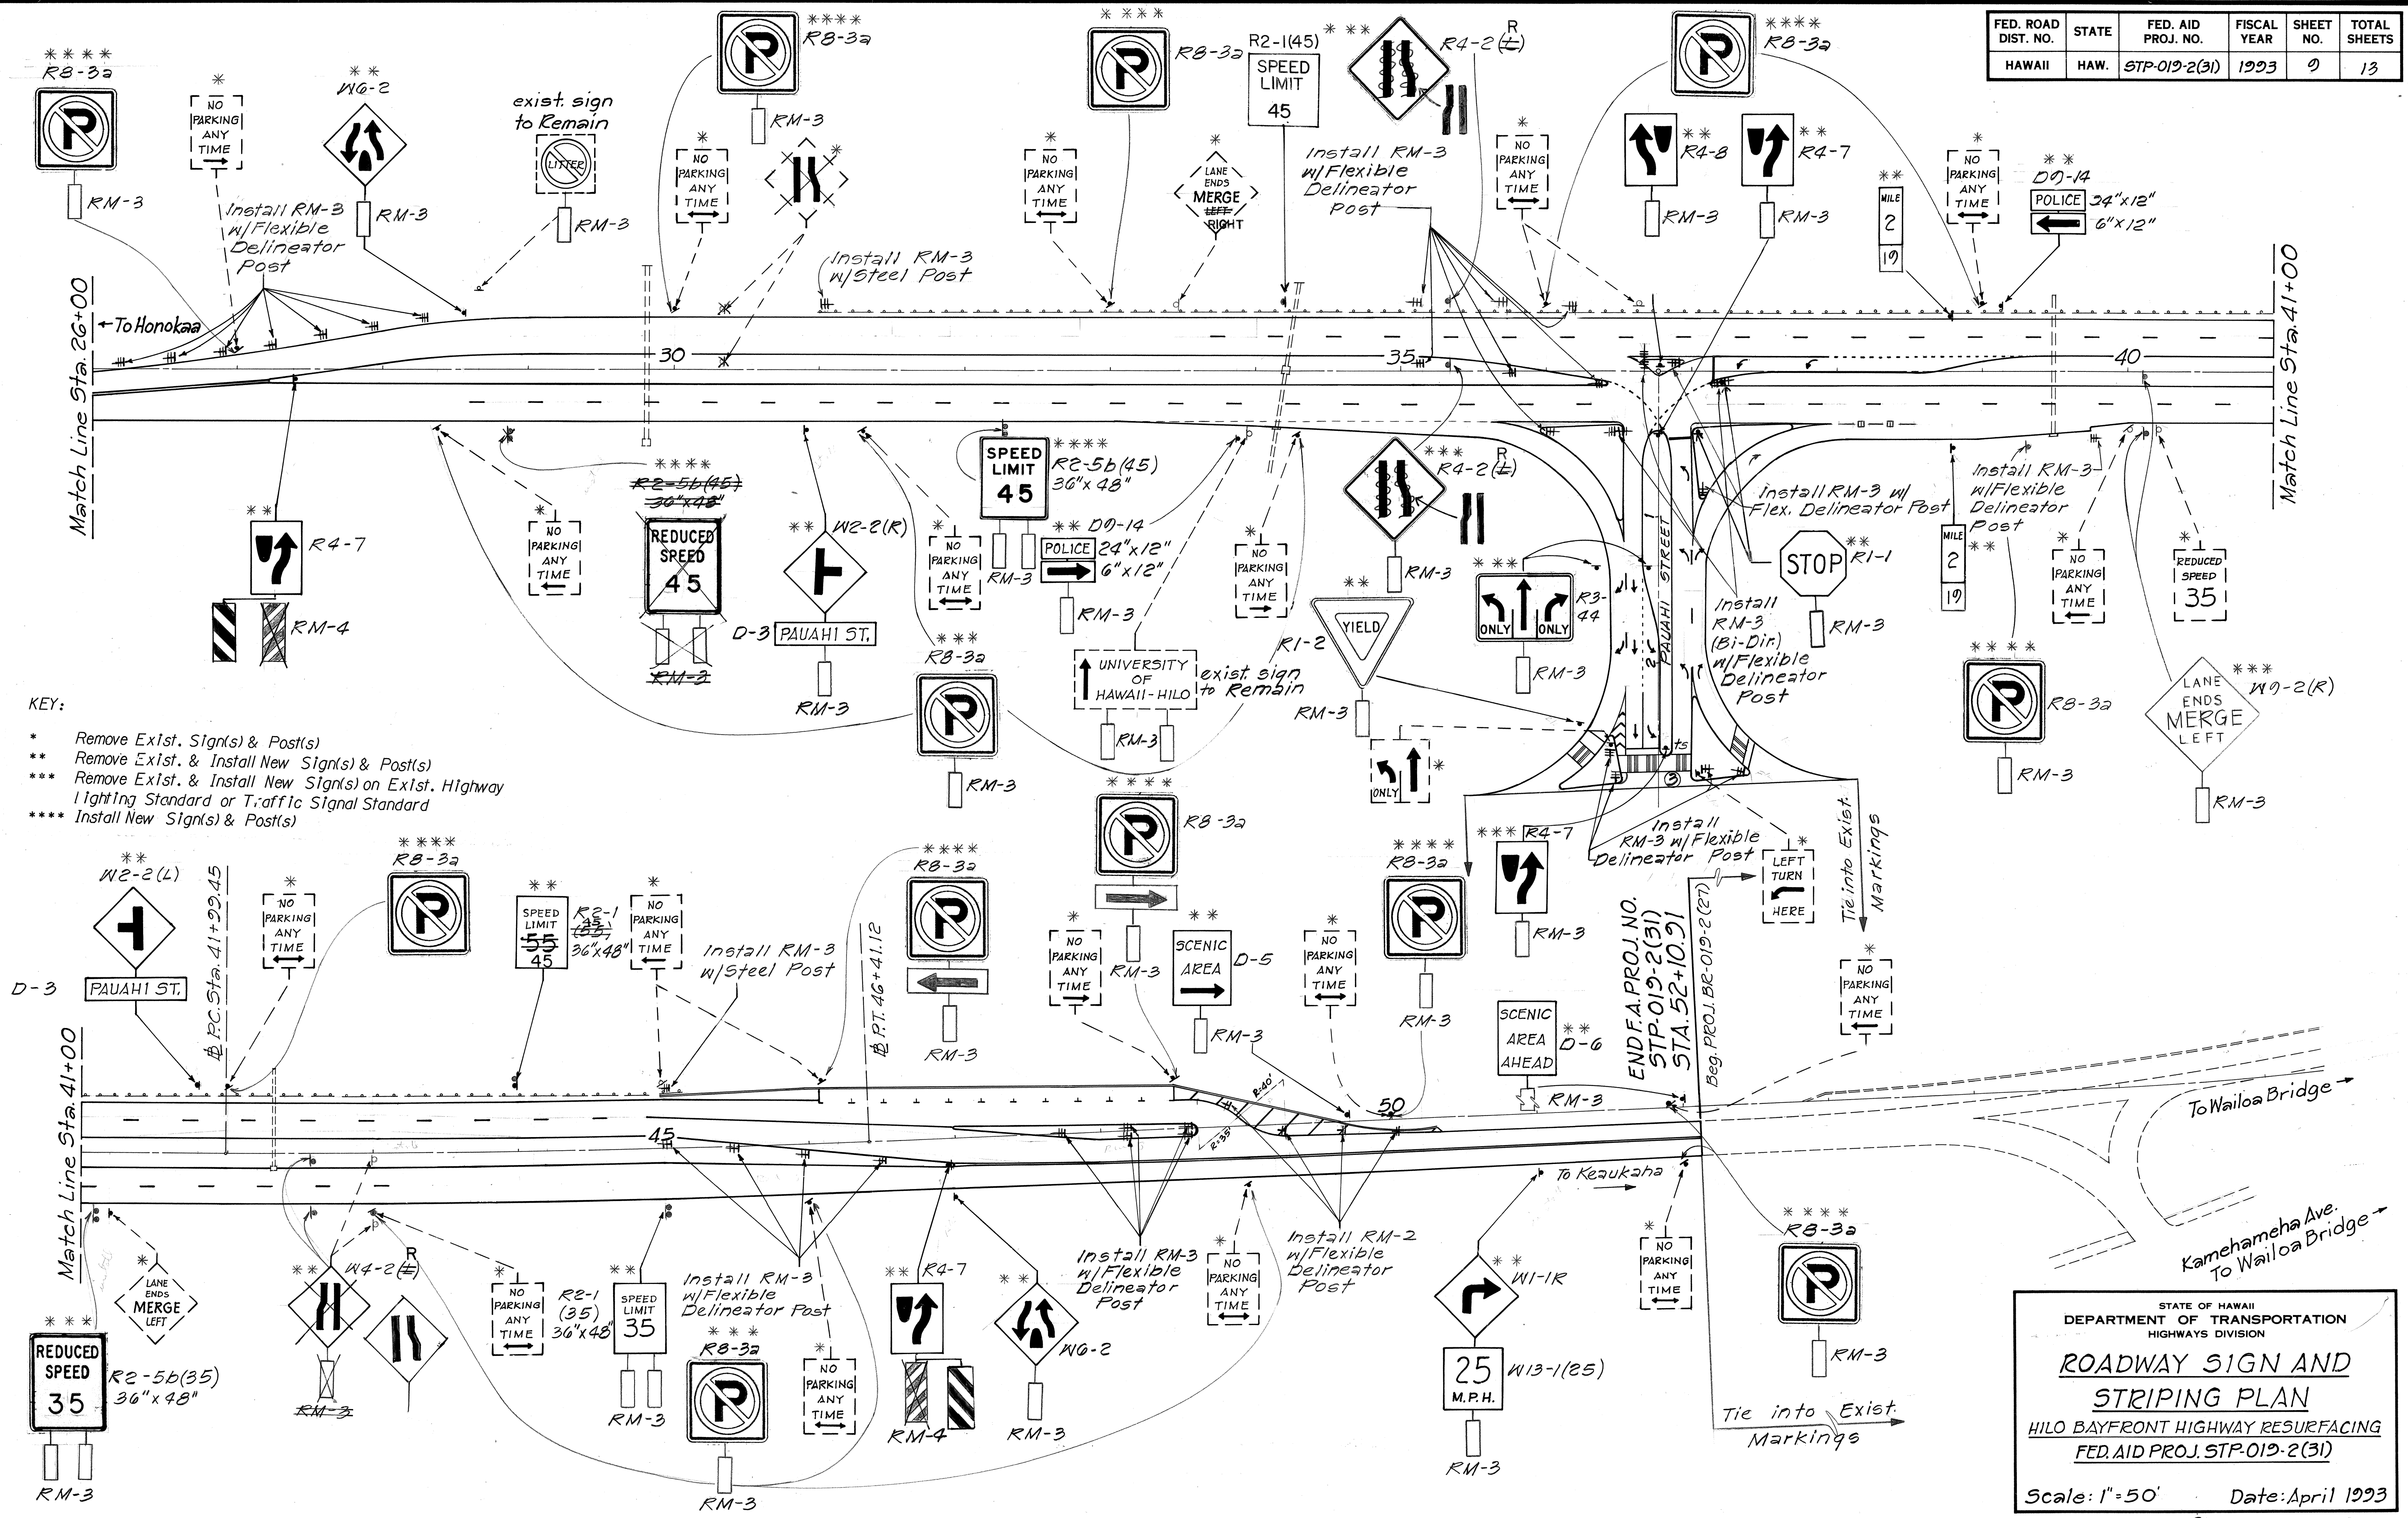

KEY:

- * Remove Exst. Sign(s) & Post(s)
- ** Remove Exst. & Install New Sign(s) & Post(s)
- *** Remove Exst. & Install New Sign(s) on Exst. Highway
- **** Lighting Standard or Traffic Signal Standard
- ***** Install New Sign(s) & Post(s)

DATE	_____
SURVEY PLOTTED BY	_____
PLAN	_____
DRAWN BY	_____
DESIGNED BY	_____
CHECKED BY	_____
NO.	_____

STATE OF HAWAII
DEPARTMENT OF TRANSPORTATION
HIGHWAYS DIVISION

ROADWAY SIGN AND STRIPING PLAN

HILO BAYFRONT HIGHWAY RESURFACING
FED. AID PROJ. STP-019-2(31)

Scale: 1"=50' Date: April 1993

SHEET No. 2 OF 2 SHEETS