FED. ROAD DIST. NO.	STATE	PROJ. NO.	FISCAL YEAR	SHEET NO.	TOTAL SHEETS
HAWAII	HAW.	19GH-01-94M	1994	1	12

INDEX TO DRAWINGS

SHEET NO.	DESCRIPTION
1	TITLE SHEET
2	STANDARD PLANS SUMMARY
3	GENERAL NOTES
4-5	BRIDGE IMPROVEMENT PLANS
6	TYPICAL SECTION
7	EXPANSION JOINT DETAILS
8	MISCELLANEOUS SCHEDULES
9	PAVEMENT MARKINGS
10	BRIDGE CONNECTION-TYPE I DETAILS & NOTES
11	BRIDGE CONNECTION-TYPE II DETAILS & NOTES
12	CONSTRUCTION SIGN PLAN & SCHEDULE

STATE OF HAWAII

DEPARTMENT OF TRANSPORTATION

HIGHWAYS DIVISION

HONOLULU, HAWAII

"AS-BUILT"

PLANS FOR

BRIDGE REPAIRS AT VARIOUS LOCATIONS ON HAWAII

PROJECT NO. 19GH-01-94M

DISTRICT OF NORTH HILO AND HAMAKUA
ISLAND OF HAWAII

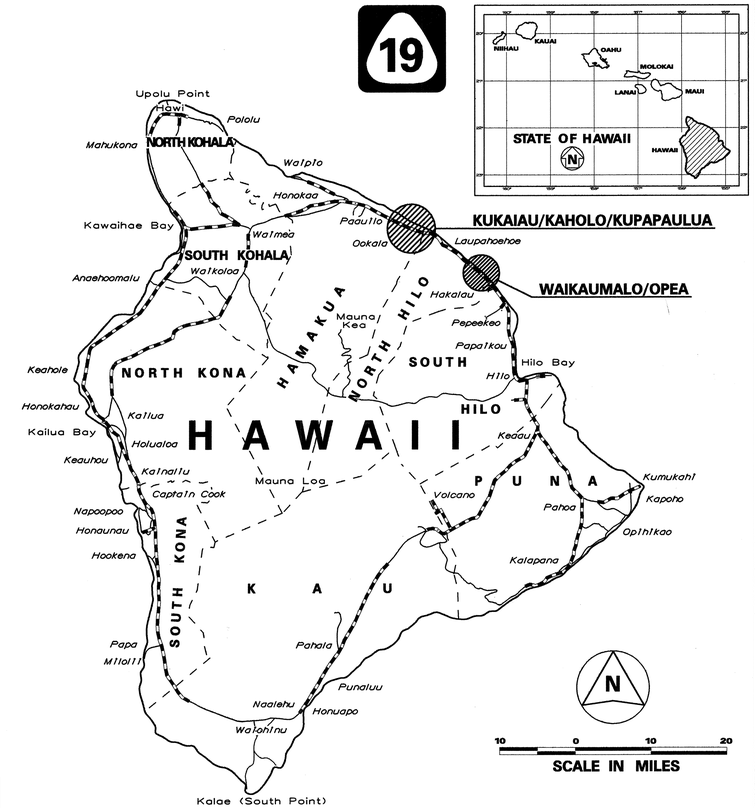

FEDERAL AID PROJECTS PREVIOUSLY CONSTRUCTED OR UNDER CONSTRUCTION

MILE POST 33.88 TO MILE POST 17.88

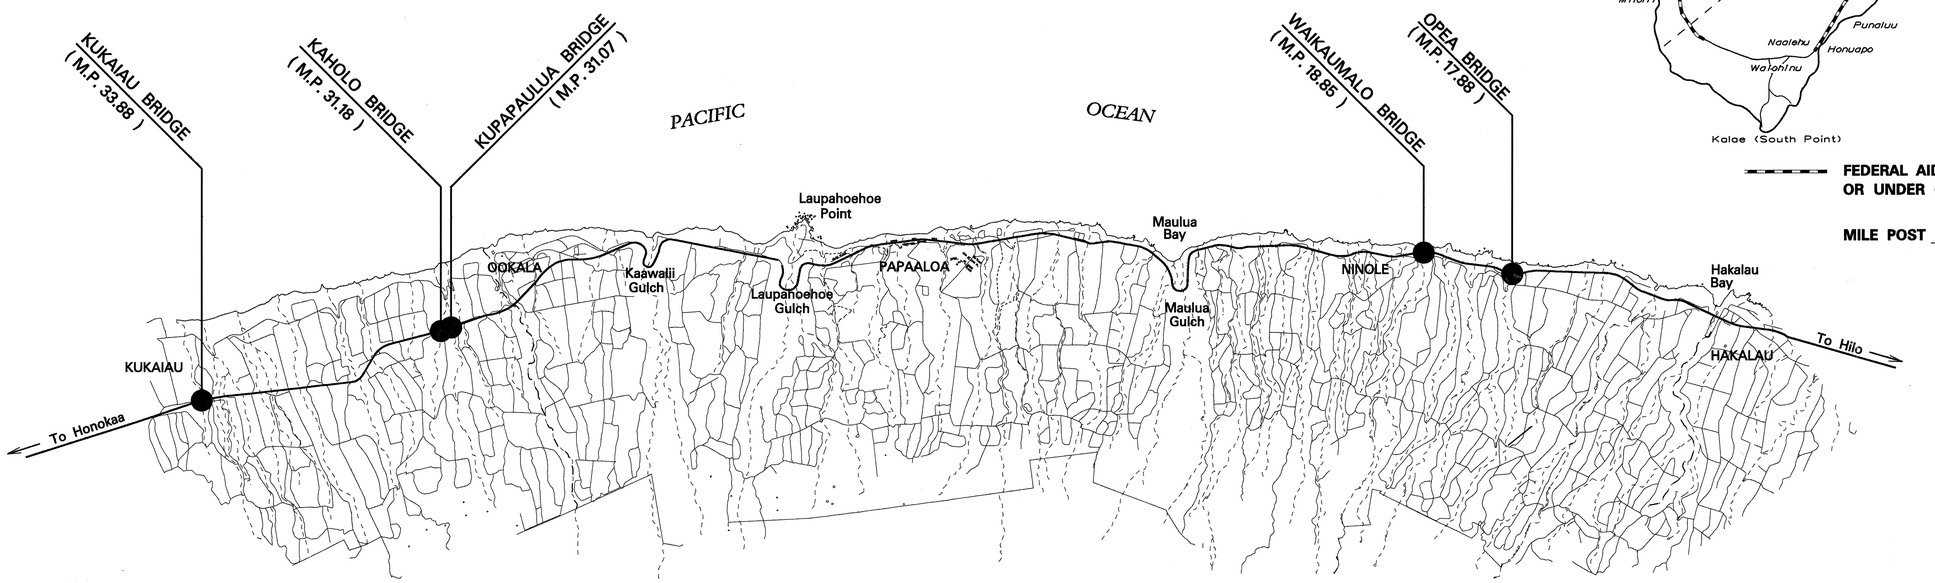

4 0 4 8 12
SCALE IN THOUSAND FEET

LAYOUT PLAN

N

CHANGES MADE DURING CONSTRUCTION HAVE BEEN INCORPORATED IN THESE PLANS.

Salvador Lanez — RESIDENT ENGINEER — 12/18/96 DATE

DEPARTMENT OF TRANSPORTATION
STATE OF HAWAII

APPROVED:

T. Harano — DIR. OF TRANSPORTATION — 5/23/94 DATE

HAWAII DISTRICT — DESIGNED BY
A. NISHIMURA — P. S. & E. BY
587-2244 — PHONE
MAY, 1994 — DATE