FED. ROAD DIST. NO.	STATE	FED. AID PROJ. NO.	FISCAL YEAR	SHEET NO.	TOTAL SHEETS
HAWAII	HAW.	STP-019-1(30)	1994	1	9

INDEX TO DRAWINGS

SHEET NO.	DESCRIPTION
1	TITLE SHEET
2	STANDARD PLANS SUMMARY
3	TYPICAL SECTIONS, DETAIL AND GENERAL NOTES
4-5	ROADWAY AND STRIPING PLAN
6	REFLECTOR & OBJECT MARKER & SIGN SCHEDULE
7	CATCH BASIN DETAIL & NOTES
8-9	MISC. SCHEDULES, DETAILS & NOTES

STATE OF HAWAII

DEPARTMENT OF TRANSPORTATION

HIGHWAYS DIVISION

HONOLULU, HAWAII

"AS-BUILT"

PLANS FOR

HAWAII BELT ROAD RESURFACING

MAULUA TO KAALAU BRIDGE

FED. AID PROJ. NO. STP-019-1(30)

DISTRICT OF NORTH HILO

ISLAND OF HAWAII

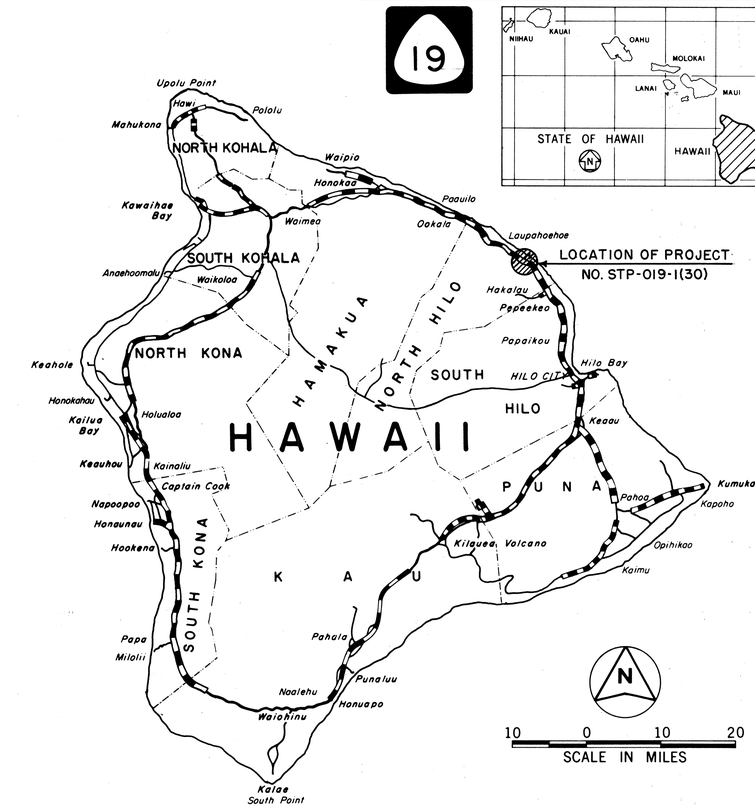

FEDERAL AID PROJECTS PREVIOUSLY CONSTRUCTED OR UNDER CONSTRUCTION

MILE POST 21.27 TO MILE POST 23.40 ~~23.34~~

FED-AID PROJ. NO. STP-019-1(30)

LENGTH OF PROJECT = 2.07 MILES

BEGIN PROJ. STP-019-1(30)

STA. ~~12+81.50 (M.P. 23.34)~~ 9+53.00 (M.P. 23.40)

STA. 85+00 (M.P. 21.27)

END PROJ. STP-019-1(30)

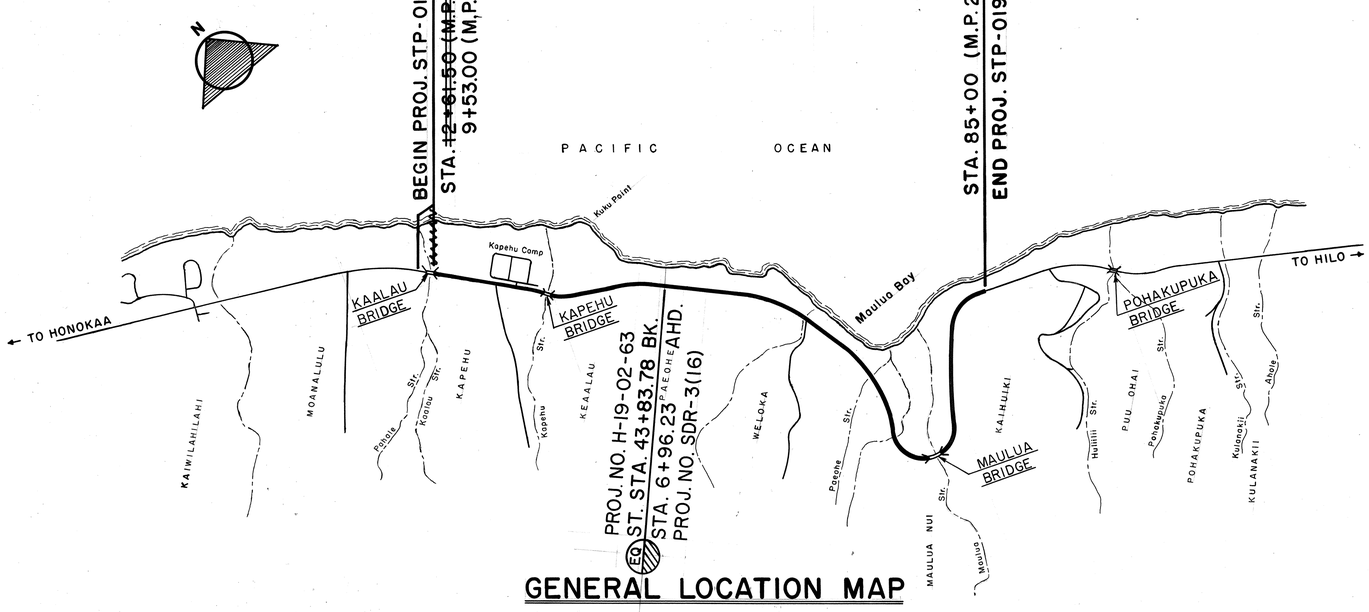

GENERAL LOCATION MAP

SCALE: 1" = 1000'

DESIGN DESIGNATION

ADT (1992)	6,350
ADT (2002)	6,910
DHV	620
D	60/40
T_{24}	10 %

CHANGES MADE DURING CONSTRUCTION HAVE BEEN INCORPORATED ON THESE PLANS EXCEPT CHANGES IN THE ORIGINAL THEORETICAL QUANTITIES. FOR ACTUAL QUANTITIES, REFER TO PROJECT LEDGER AND/OR COMPUTATION BOOK.

Salvador C. Yanem — 1/2/96

RESIDENT ENGINEER — DATE

DEPARTMENT OF TRANSPORTATION FEDERAL HIGHWAY ADMINISTRATION	
APPROVED:	
For DIVISION ADMINISTRATOR	3/25/93 DATE

DEPARTMENT OF TRANSPORTATION STATE OF HAWAII	
APPROVED:	
For DIR. OF TRANSPORTATION	2/11/93 DATE

HAWAII DISTRICT — DESIGNED BY

J. KASAMOTO — P. S. & E. BY

587-2250 — PHONE

Oct. 1992 — DATE

D-75