| FED. ROAD DIST. NO. | STATE | FED. AID PROJ. NO. | FISCAL YEAR | SHEET NO. | TOTAL SHEETS |
|---|---|---|---|---|---|
| HAWAII | HAW. | STP-019-1(23) | 1996 | 1 | 8 |

INDEX TO DRAWINGS


| SHEET NO. | DESCRIPTION |
|---|---|
| 1 | TITLE SHEET |
| 2 | STANDARD PLANS SUMMARY |
| 3 | GENERAL NOTES |
| 4 | NPDES GENERAL NOTES |
| 5 | TYPICAL SECTIONS |
| 6 | SHOULDER RUMBLE STRIP DETAILS AND NOTES |
| 7 | SIGN DETAILS AND NOTES |
| 8 | CONSTRUCTION SIGN, PAVEMENT MARKING DETAIL |


STATE OF HAWAII

# DEPARTMENT OF TRANSPORTATION

## HIGHWAYS DIVISION

HONOLULU, HAWAII

"AS-BUILT" PLANS FOR

# QUEEN KAAHUMANU HIGHWAY SHOULDER IMPROVEMENTS

## KEAHOLE TO WAIKOLOA

## FEDERAL AID PROJECT NO. STP-019-1(23)

DISTRICTS OF SOUTH KOHALA AND NORTH KONA
ISLAND OF HAWAII

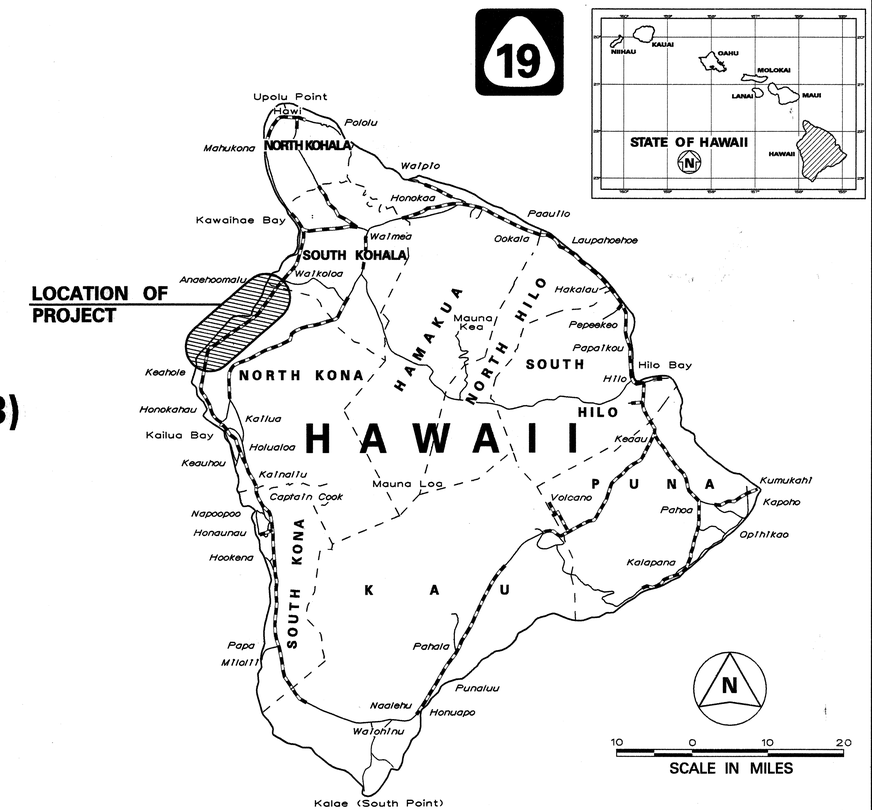


FEDERAL AID PROJECTS PREVIOUSLY CONSTRUCTED OR UNDER CONSTRUCTION

MILE POST 75.85 TO MILE POST 92.55

PROJECT LIMITS

BEGIN PROJECT
℄ STA. 258+20.00
M.P. 92.55

℄ STA. 1039+87.00

Exception Area

℄ STA. 1066+67.00

℄ STA. 1125+00.00 BK. = EQ.
℄ STA. 1140+96.94 AHD.

M.P. 75.85
℄ STA. 1143+30.00
END PROJECT

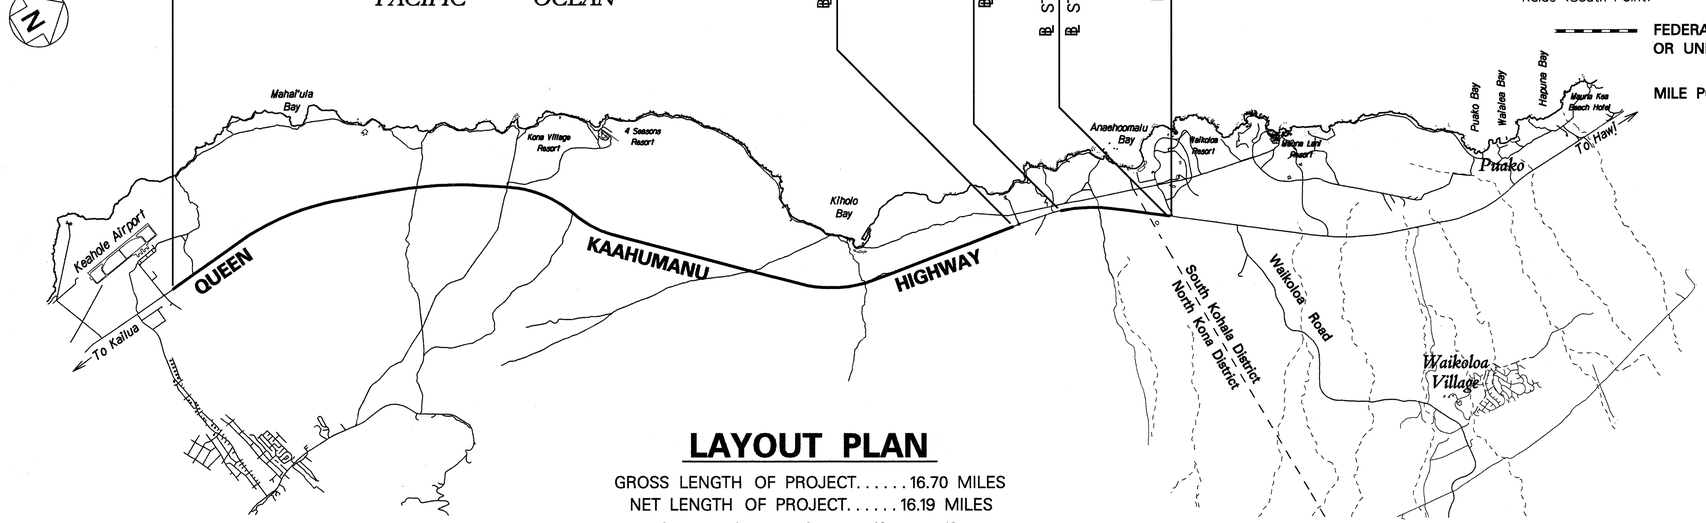


## LAYOUT PLAN

GROSS LENGTH OF PROJECT.....16.70 MILES
NET LENGTH OF PROJECT.....16.19 MILES

6 0 6 12 18
SCALE IN THOUSAND FEET

CHANGES MADE DURING CONSTRUCTION HAVE BEEN INCORPORATED ON THESE PLANS EXCEPT CHANGES IN THE ORIGINAL THEORETICAL QUANTITIES. FOR ACTUAL QUANTITIES, REFER TO PROJECT LEDGER AND/OR COMPUTATION BOOK.

Robert H.W. Lee, Jr. 4/18/02
RESIDENT ENGINEER DATE

DEPARTMENT OF TRANSPORTATION
STATE OF HAWAII

APPROVED:
5/20/96
DIR. OF TRANSPORTATION DATE

HAWAII DISTRICT
DESIGNED BY J. FUJIMOTO P. S. & E. BY 587-2249 PHONE MAY 1996 DATE