


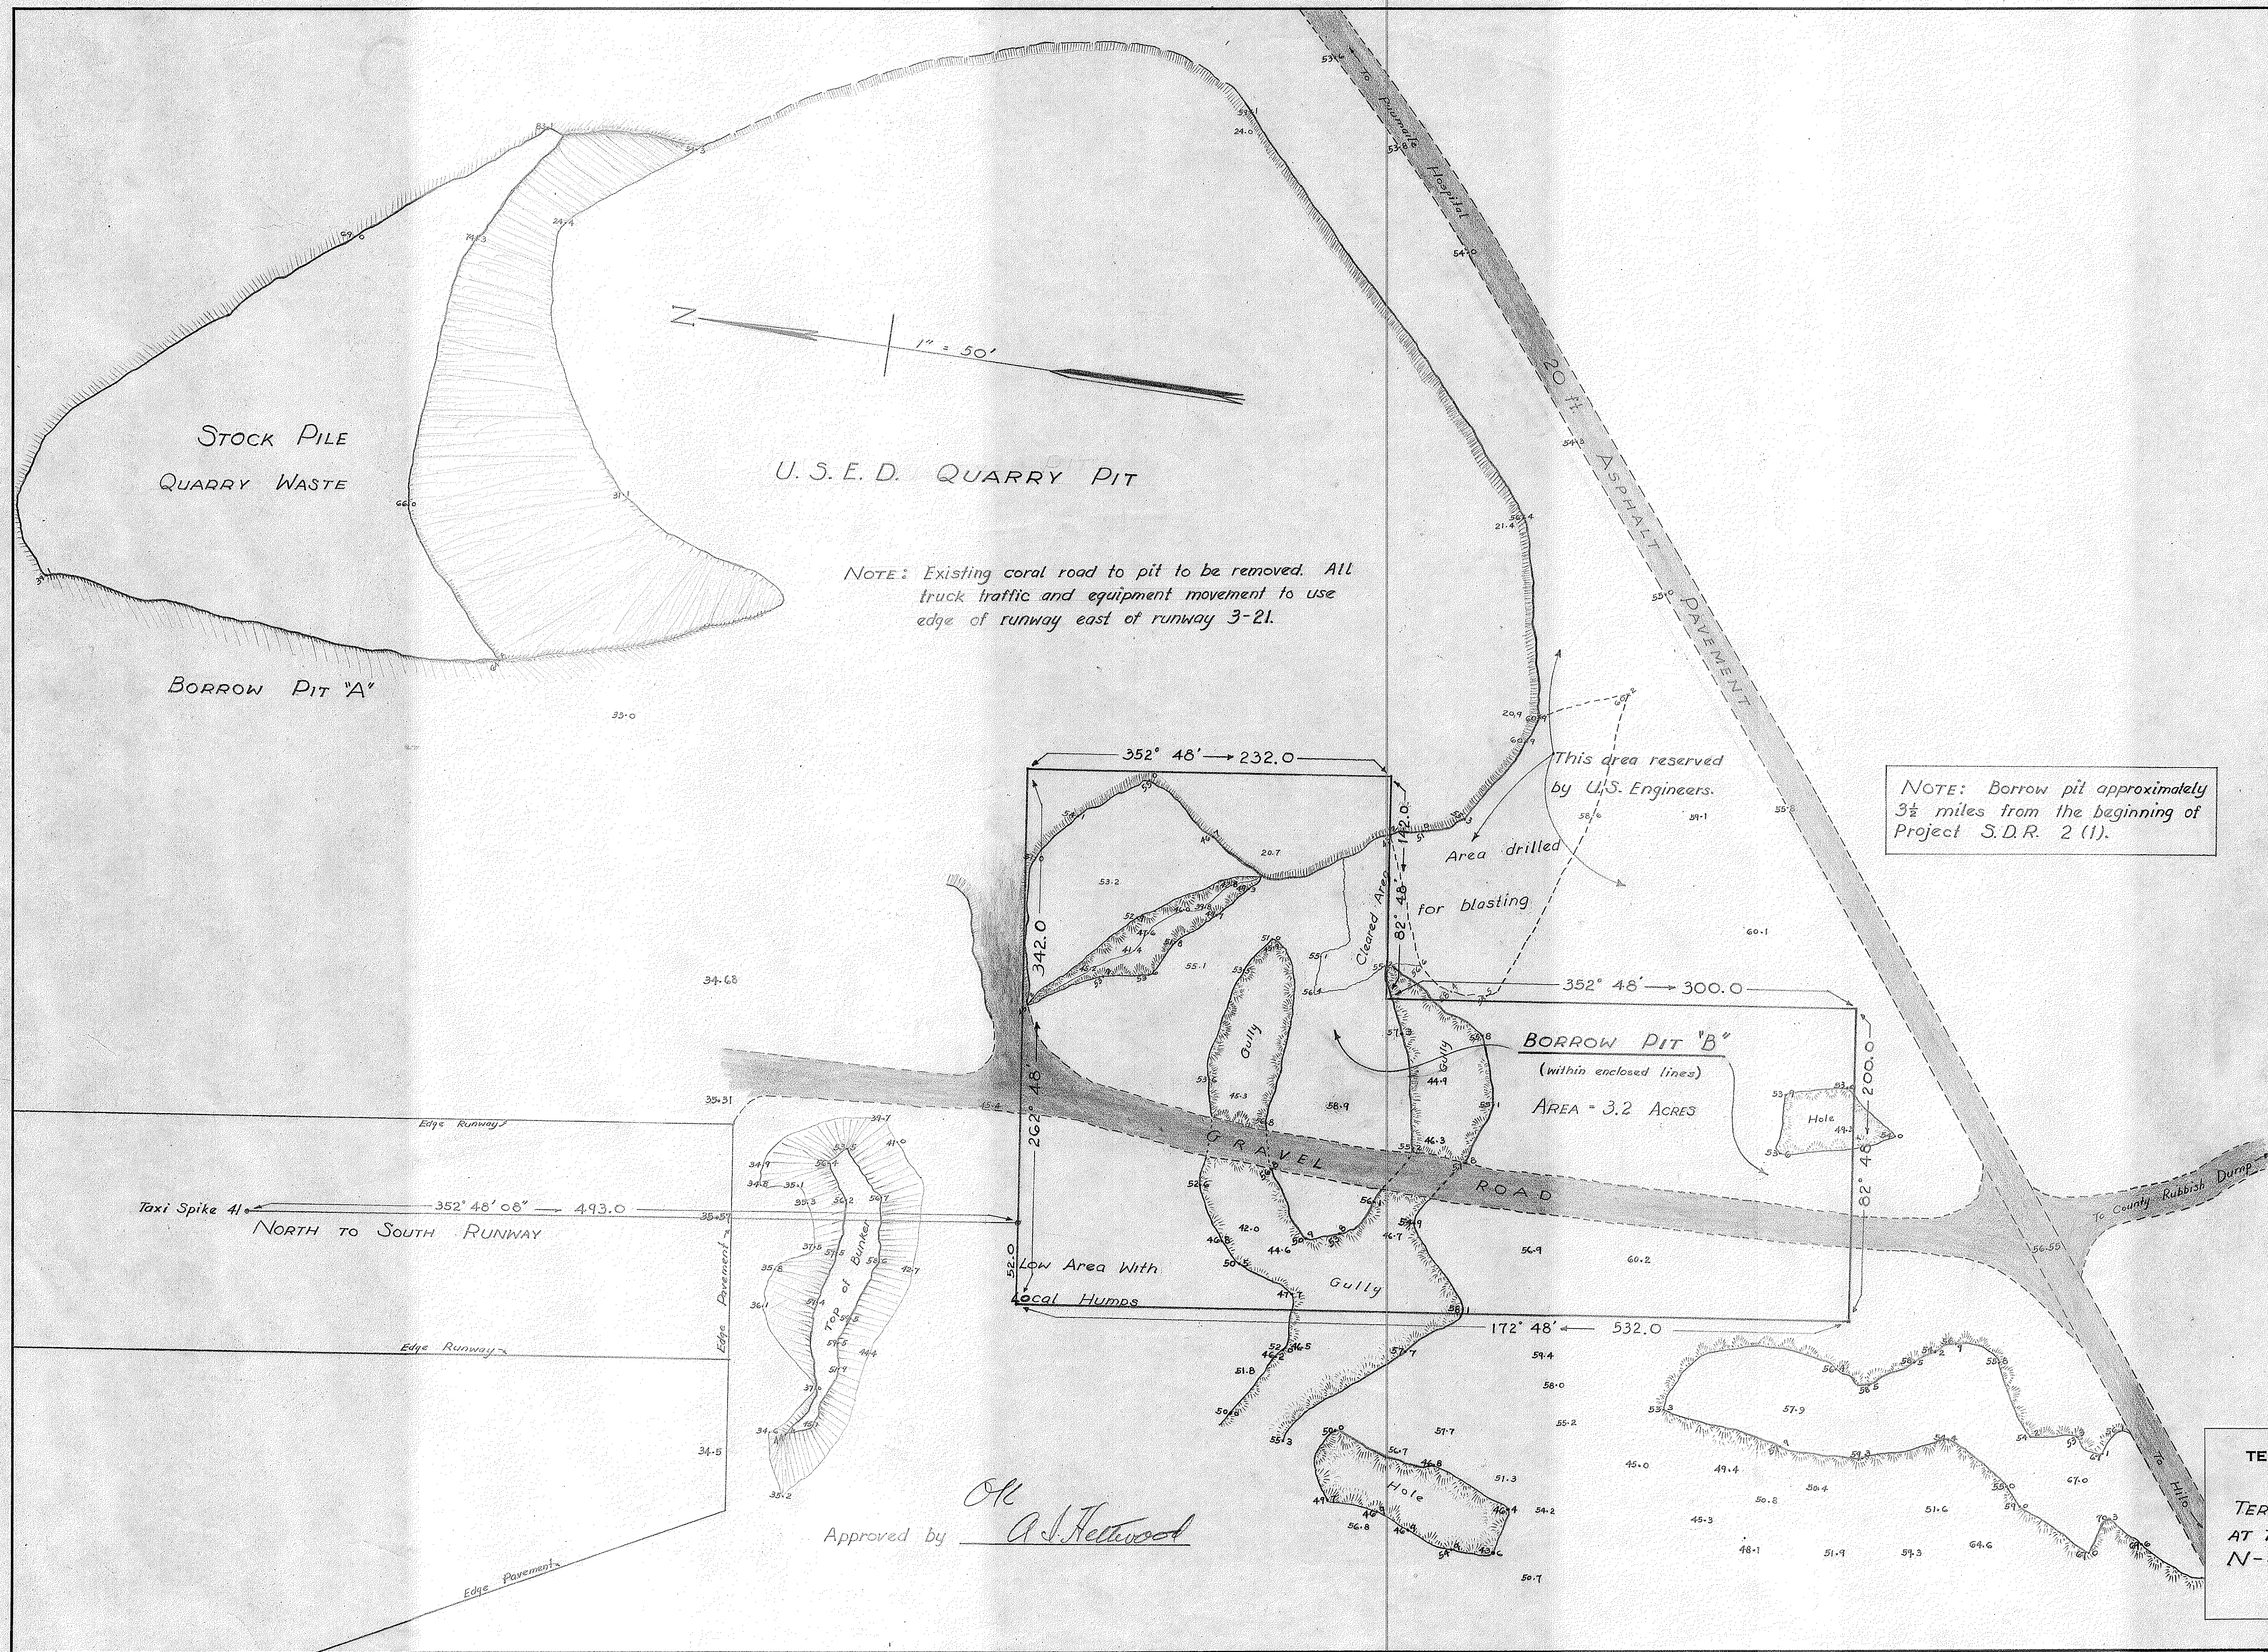

SURVEY PLOTTED BY	DATE
ORIGINAL PLAN	
TRACED BY	
QUANTITIES CHECKED BY	
CHECKED BY	
No.	

TERRITORIAL HIGHWAY DEPARTMENT
TERRITORY OF HAWAII

TERRITORIAL BORROW PIT LOCATED
AT THE SOUTH-EAST END OF THE
N-S RUNWAY HILO AIRPORT.

Scale: 1 in. = 50 ft. 10/6/47
SHEET No 1 OF 1 SHEETS

5275.4A