INDEX TO DRAWINGS	
SHEET	DESCRIPTION
5275.1	Title Sheet
.2	Typical Sections
.3-4	Plan and Profile
.4A	Borrow Pit Location Plan
.5	Standard Details
.6-12	Cross Sections

TERRITORY OF HAWAII
TERRITORIAL HIGHWAY DEPARTMENT
HONOLULU - T. H.

PLANS OF
• KALANIANAOLE STREET •
SEISMIC WAVE DAMAGE REHABILITATION
PROJECT NUMBER S. D. R. 2 (1)

KEAUKAHA SECTION
SOUTH HILO DISTRICT
ISLAND OF HAWAII

FED. ROAD DIST. NO.	STATE	FED. AID PROJ. NO.	FISCAL YEAR	SHEET NO.	TOTAL SHEETS
HAWAII	HAW.	SDR 2 (1)	1947	1	12

NOTE: ALL CHANGES MADE DURING CONSTRUCTION HAVE BEEN NOTED IN RED IN THESE TRACINGS AND CHECKED BY:

Walter C. Watson Jr.
RESIDENT ENGINEER
DATE. June 18 1949

SCALES

PLAN		1 IN. = 100 FT.
PROFILE	HOR.	1 IN. = 100 FT.
	VERT.	1 IN. = 5 FT.
CROSS SECTION	HOR.	1 IN. = 10 FT.
	VERT.	1 IN. = 5 FT.

CONVENTIONAL SIGNS USED

Centerline 155
Boundary Lines or,
Fences (Noted) or,
Existing Roadway
Box Culvert
Circular Culvert
Bridge
Railroad or,
Tree (Large) or,
Telephone Pole T.P.
Electric Line Pole E.P.
Water Main W_4 W_5 W_6, 8, ETC.
Water Valve W.V.
Water Valve Manhole W.V.H.
Storm Drain Manhole D.M.H.
Sewer Manhole S.M.H.
Fire Hydrant F.H.
Warning & Regulatory Signs Type
Centerline Monument

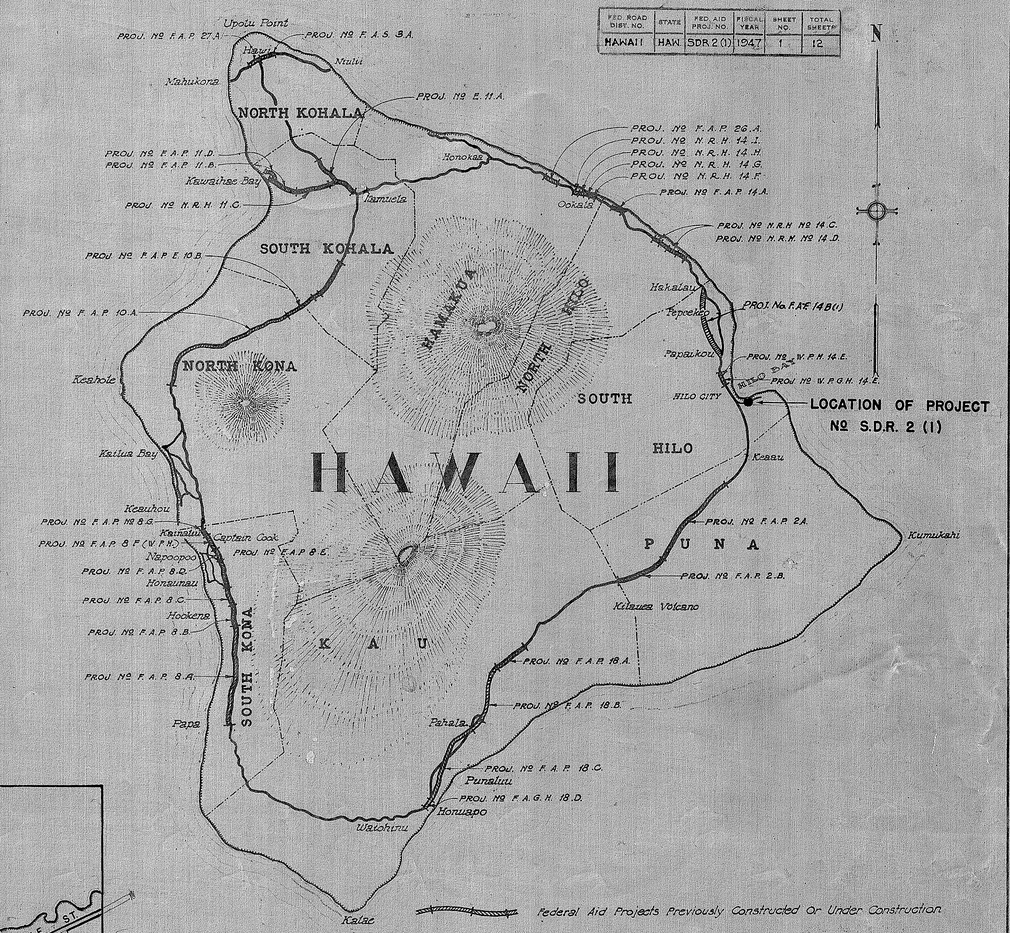

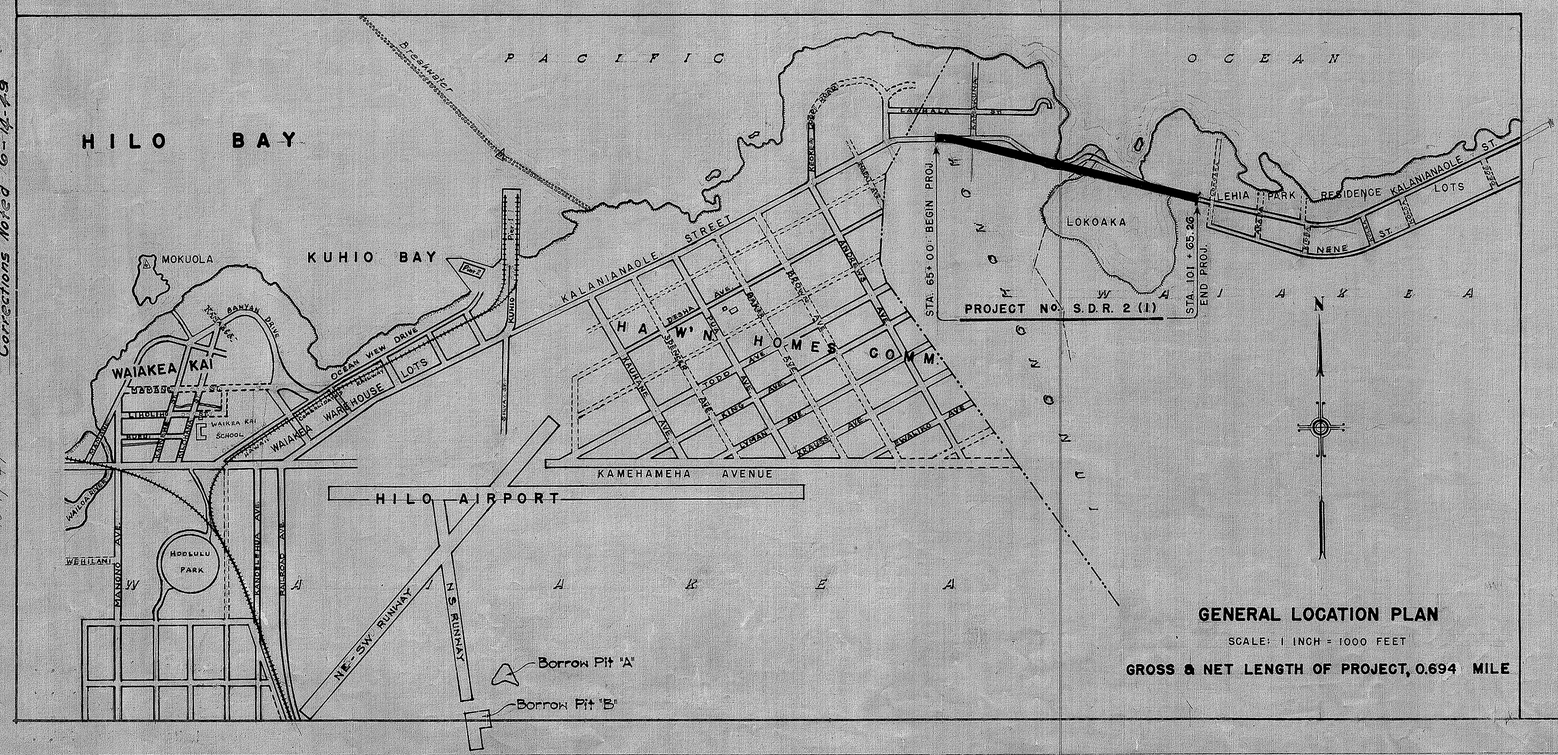

GENERAL LOCATION PLAN
SCALE: 1 INCH = 1000 FEET
GROSS & NET LENGTH OF PROJECT, 0.694 MILE

APPROVED: DATE 9-15-47
Ernest Bell
TERRITORIAL HIGHWAY ENGINEER

APPROVED: DATE 7-31-47
B.F. Rush
TERRITORIAL HIGHWAY ENGINEER

RECOMMENDED FOR APPROVAL: DATE [redacted]
DISTRICT ENGINEER
PUBLIC ROADS ADMINISTRATION
FEDERAL WORKS AGENCY

APPROVED: DATE [redacted]
DIVISION ENGINEER
PUBLIC ROADS ADMINISTRATION
FEDERAL WORKS AGENCY

Corrections Noted 6-11-49
10-17-47

5275.1