FED. ROAD DIST. NO.	STATE	PROJ. NO.	FISCAL YEAR	SHEET NO.	TOTAL SHEETS
HAWAII	HAW.	19A-01-98	2000	5	22

QUEEN KAAHUMANU HIGHWAY ℄ STA. 68+54± TO ℄ STA. 69+50± RT.

Remove 130± L.F. of exisitng guardrail Type-3 single with steel post. Install and coneect 140± L.F. of new guardrail Type-3 single with steel post and modified G-flare. See Details on Sheet 9.

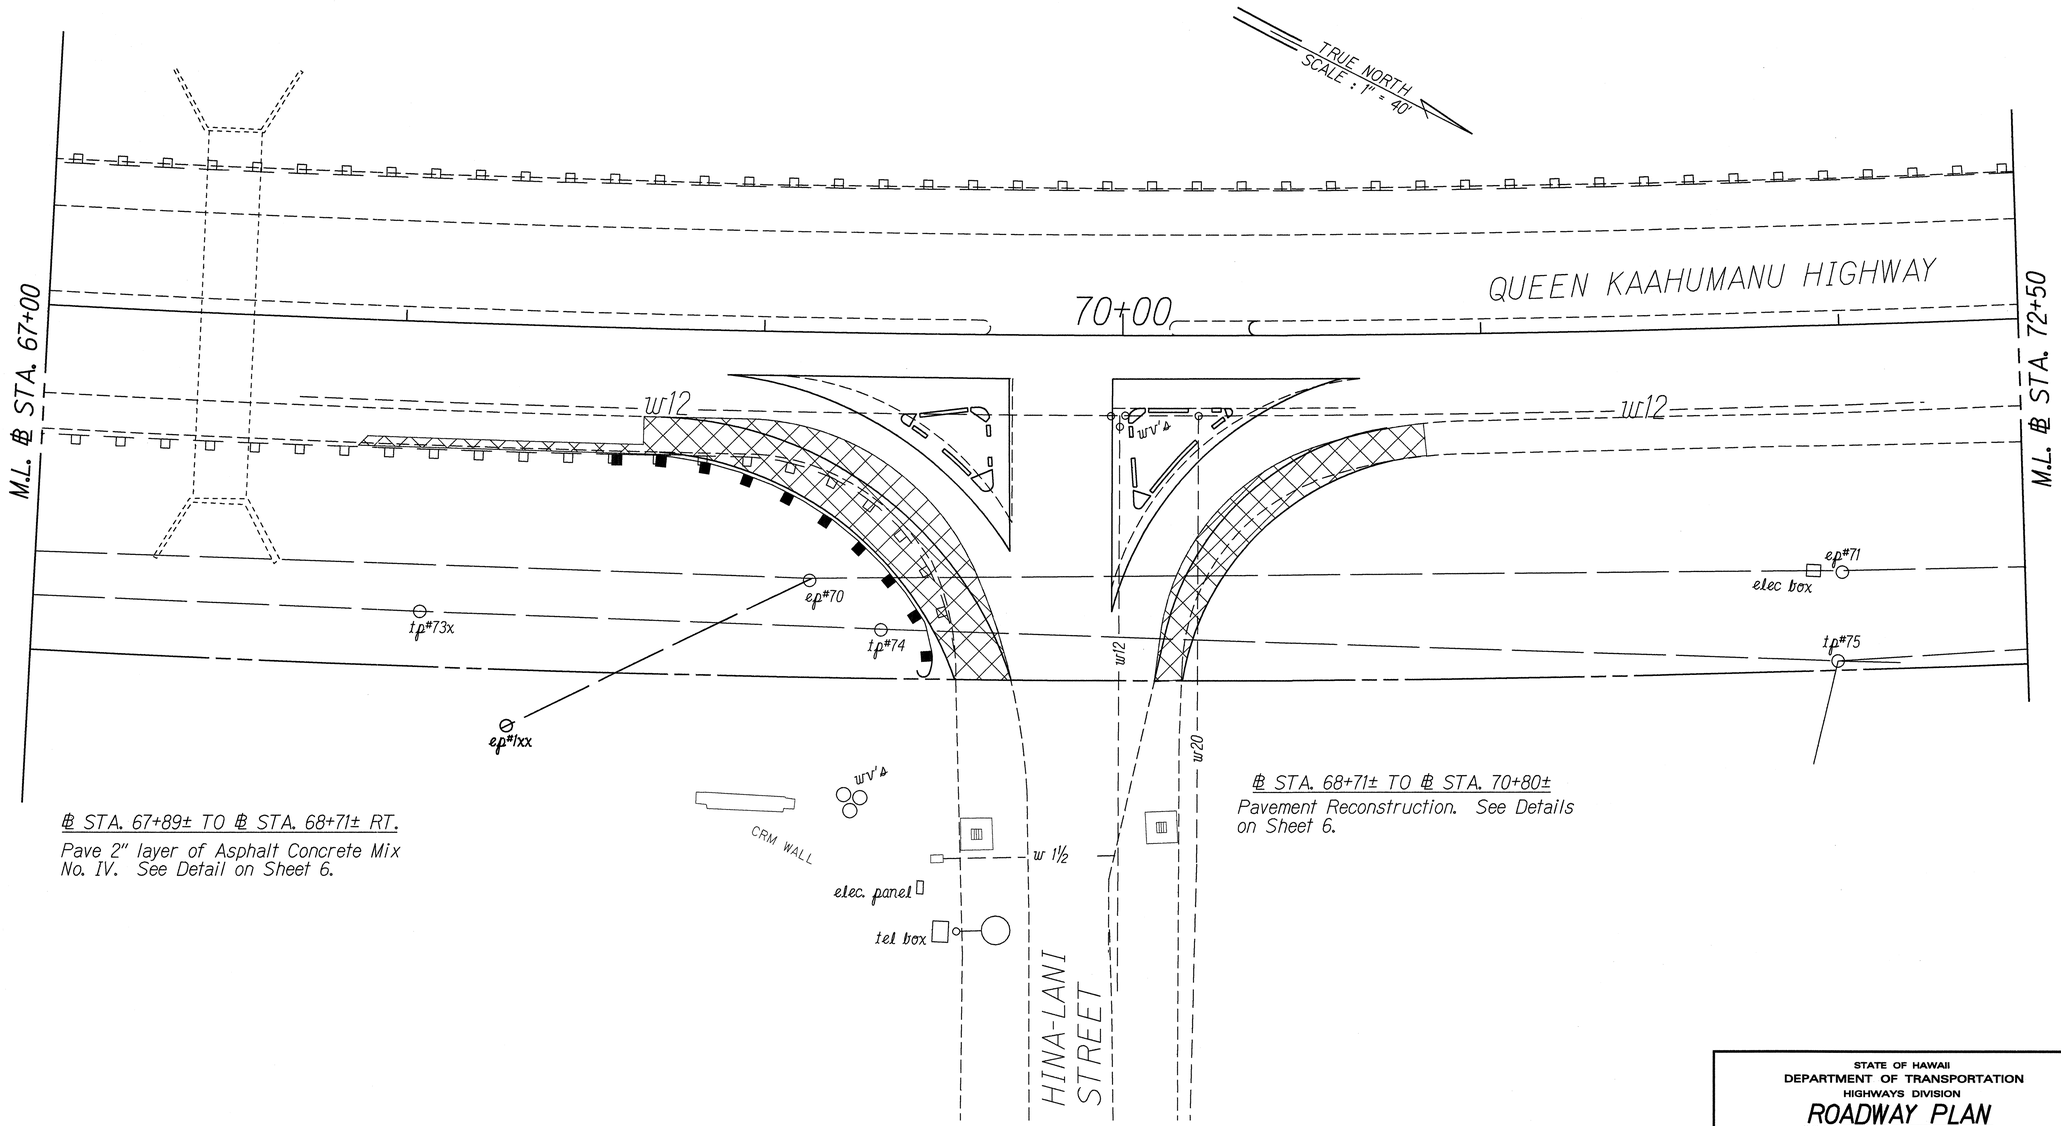

℄ STA. 67+89± TO ℄ STA. 68+71± RT.

Pave 2" layer of Asphalt Concrete Mix No. IV. See Detail on Sheet 6.

℄ STA. 68+71± TO ℄ STA. 70+80±

Pavement Reconstruction. See Details on Sheet 6.

ORIGINAL PLAN	SURVEY PLOTTED BY ____ DATE ____
	DRAWN BY M. Takafuji X
	TRACED BY ____
NOTE BOOK Idruby	VERIFIED BY Richard Akana
N. Sakihara	QUANTITIES BY ____
	CHECKED BY ____

STATE OF HAWAII
DEPARTMENT OF TRANSPORTATION
HIGHWAYS DIVISION

ROADWAY PLAN

QUEEN KAAHUMANU HIGHWAY
Installation of Traffic Signals
at Hina-Lani Street
Project No. 19A-01-98


SHEET No. 1 OF 1 SHEETS