FED. ROAD DIST. NO.	STATE	FED. AID PROJ. NO.	FISCAL YEAR	SHEET NO.	TOTAL SHEETS
HAWAII	HAW.	NH-019-2(54)	2001	1	30

19

INDEX TO DRAWINGS

SHEET NO.	DESCRIPTION
1	TITLE SHEET
2	STANDARD PLANS SUMMARY
3	GENERAL NOTES AND LEGEND
4 – 5	NPDES NOTES
6 – 8	TYPICAL SECTIONS
9 – 10	TYPICAL SECTION AND MISC. DETAIL
11 – 17	CURB RAMPS DETAILS
18 – 20	ROADWAY PLANS
21	DRAINAGE SUMMARY AND NOTES
22 – 25	DRAINAGE DETAILS
26 – 29	PAVEMENT MARKING AND SIGNING
30	TRAFFIC SUMMARIES

STATE OF HAWAII

DEPARTMENT OF TRANSPORTATION

HIGHWAYS DIVISION

HONOLULU, HAWAII

"AS-BUILT"

PLANS FOR

KAMEHAMEHA AVENUE BIKEWAY IMPROVEMENTS

HILO BAYFRONT HIGHWAY TO KALANIANAOLE AVENUE

FEDERAL AID PROJECT NO. NH-019-2(54)

DISTRICT OF HILO

ISLAND OF HAWAII

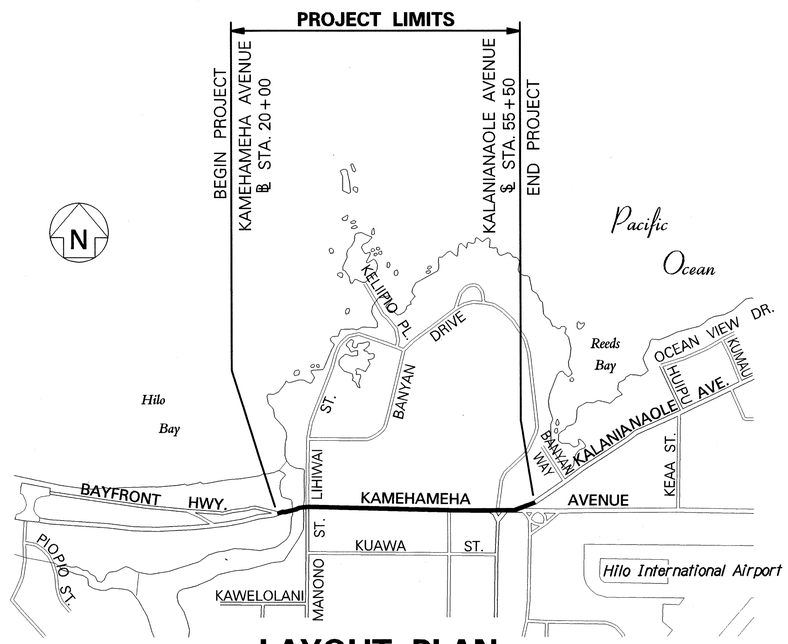

LAYOUT PLAN

GROSS LENGTH OF PROJECT..... 1.04 MILES

NET LENGTH OF PROJECT..... 1.04 MILES

7.5 0 7.5 15 22.5

SCALE IN HUNDRED FEET

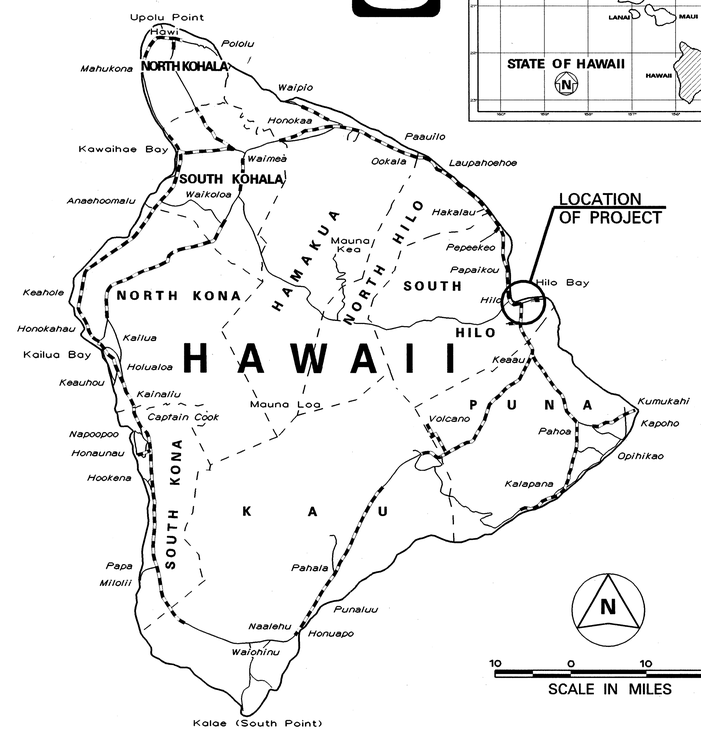

FEDERAL AID PROJECTS PREVIOUSLY CONSTRUCTED OR UNDER CONSTRUCTION

MILE POST 1.83 TO MILE POST 0.79

HILO BAYFRONT HIGHWAY TO MANONO STREET DESIGN DESIGNATION

ADT (2001)	27,700
ADT (2011)	29,600
DHV	2,520
D	55/45
T_{24}	4.0%
V	40 M.P.H.

MANONO STREET TO KALANIANAOLE AVENUE DESIGN DESIGNATION

ADT (2001)	18,200
ADT (2011)	19,500
DHV	1,560
D	55/45
T_{24}	4.0%
V	40 M.P.H.

CHANGES MADE DURING CONSTRUCTION HAVE BEEN INCORPORATED ON THESE PLANS EXCEPT CHANGES IN THE ORIGINAL THEORETICAL QUANTITIES. FOR ACTUAL QUANTITIES, REFER TO PROJECT LEDGER AND/OR COMPUTATION BOOK.

J. L. Char 3-31-05

RESIDENT ENGINEER DATE

DEPARTMENT OF TRANSPORTATION
STATE OF HAWAII

APPROVED:

for DIR. OF TRANSPORTATION 10-12-01 DATE

UNIT "A" — DESIGNED BY C. YAMASAKI P. S. & E. BY 692-7572 PHONE SEPT., 2001 DATE