FED. ROAD DIST. NO.	STATE	FED. AID PROJ. NO.	FISCAL YEAR	SHEET NO.	TOTAL SHEETS
HAWAII	HAW.	BR-019-2(43)	2000	1	65

INDEX TO DRAWINGS

SHEET NO.	DESCRIPTION
1	TITLE SHEET
2	STANDARD PLANS SUMMARY
3	INDEX TO DRAWINGS
4	ESTIMATED QUANTITIES
5	GENERAL NOTES
6	TRAFFIC CONTROL PLAN
7–15	KAPUE BRIDGE
16–27	KAIEIE BRIDGE
28–39	KALAOA BRIDGE
40–60	HAKALAU BRIDGE
61–65	CABLE RESTRAINER

STATE OF HAWAII

DEPARTMENT OF TRANSPORTATION

HIGHWAYS DIVISION

HONOLULU, HAWAII

"AS-BUILT"

PLANS FOR

HAWAII BELT ROAD

SEISMIC RETROFIT OF VARIOUS BRIDGES VICINITY OF PAPAIKOU

PROJECT NO. BR-019-2(43)

DISTRICT OF SOUTH HILO

ISLAND OF HAWAII

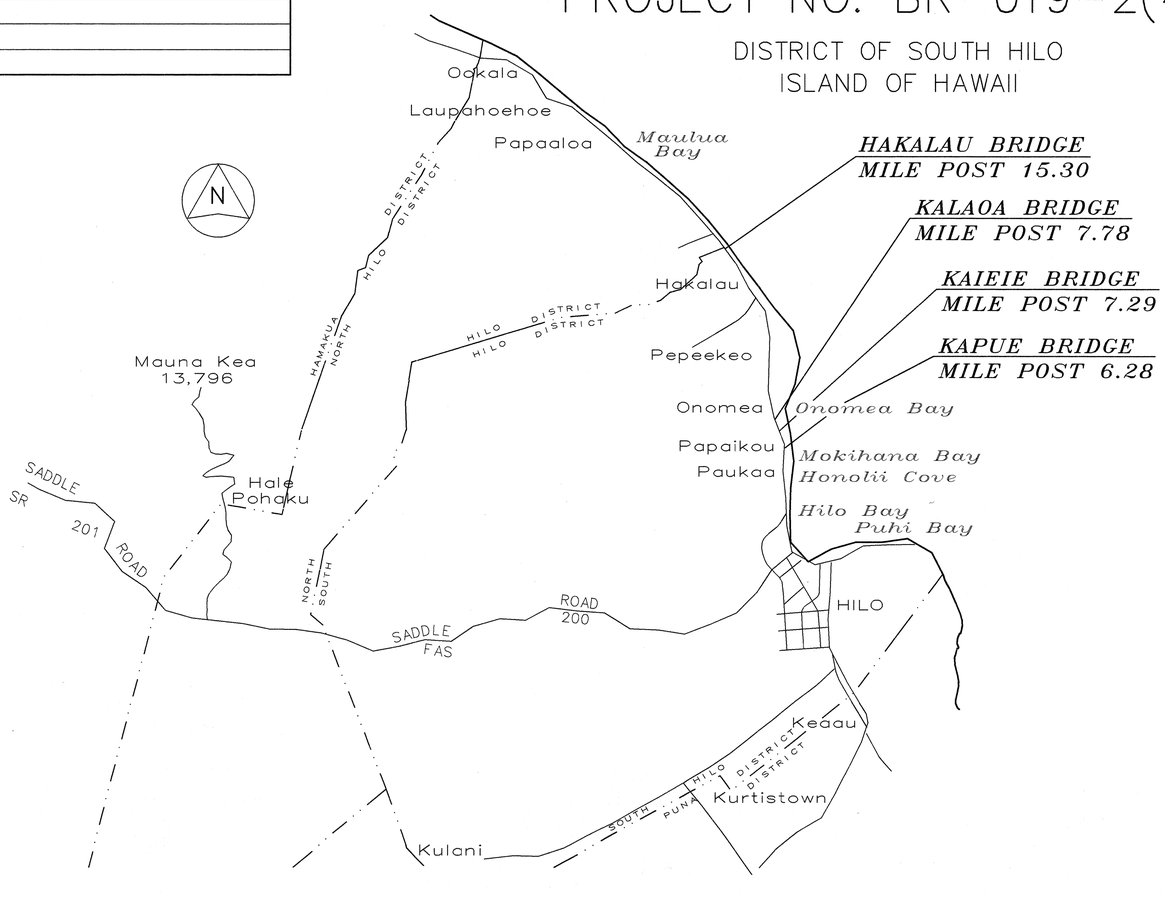

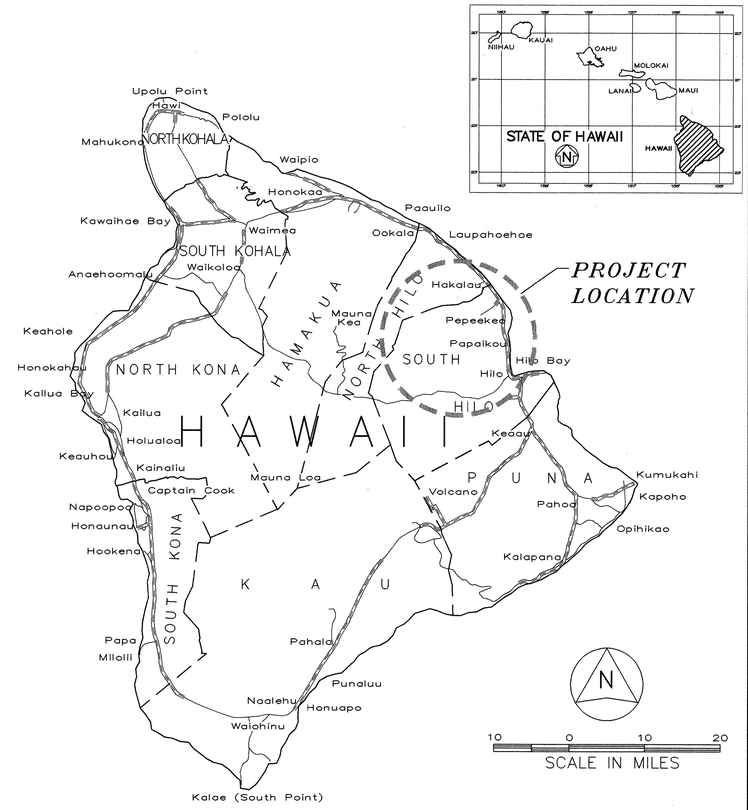

CHANGES MADE DURING CONSTRUCTION HAVE BEEN INCORPORATED ON THESE PLANS EXCEPT CHANGES IN THE ORIGINAL THEORETICAL QUANTITIES. FOR ACTUAL QUANTITIES, REFER TO PROJECT LEDGER AND/OR COMPUTATION BOOK.

RESIDENT ENGINEER — DATE 2-14-03

DEPARTMENT OF TRANSPORTATION
STATE OF HAWAII

APPROVED:

DIR. OF TRANSPORTATION — DATE 8/9/99

KSF, INC. — DESIGNED BY — E. BARROGA, JR. — PHONE 692-7546 — DATE 8/12/99

P. S. & E. BY

ORIGINAL PLAN — SURVEY PLOTTED BY — TRACED BY — DESIGNED BY — QUANTITIES BY — CHECKED BY — DATE

NOTE BOOK No.

FILE: 2002B-1.DWG
PLOT: 1 = 1