INDEX TO DRAWINGS	
SHEET NO.	DESCRIPTION
1	TITLE SHEET
2	STANDARD PLANS SUMMARY
3	GENERAL NOTES
4	BRIDGE JOINT DETAILS
5	MAULUA BRIDGE PLAN
6	PAHEEHEE BRIDGE PLAN
7	KAPUE BRIDGE PLAN
8	PUKIHAE BRIDGE PLAN
9	CONSTRUCTION SIGN PLAN AND SCHEDULE

FED. ROAD DIST. NO.	STATE	PROJ. NO.	FISCAL YEAR	SHEET NO.	TOTAL SHEETS
HAWAI'I	HAW.	HWY-H-08-00M	2000	1	9

STATE OF HAWAI'I

DEPARTMENT OF TRANSPORTATION

HIGHWAYS DIVISION

HONOLULU, HAWAI'I

"AS-BUILT"

PLANS FOR

MAULUA/PAHEEHEE/KAPUE/PUKIHAE BRIDGE JOINT REPAIRS

PROJECT NO. HWY-H-08-00M

DISTRICTS OF NORTH & SOUTH HILO

ISLAND OF HAWAI'I

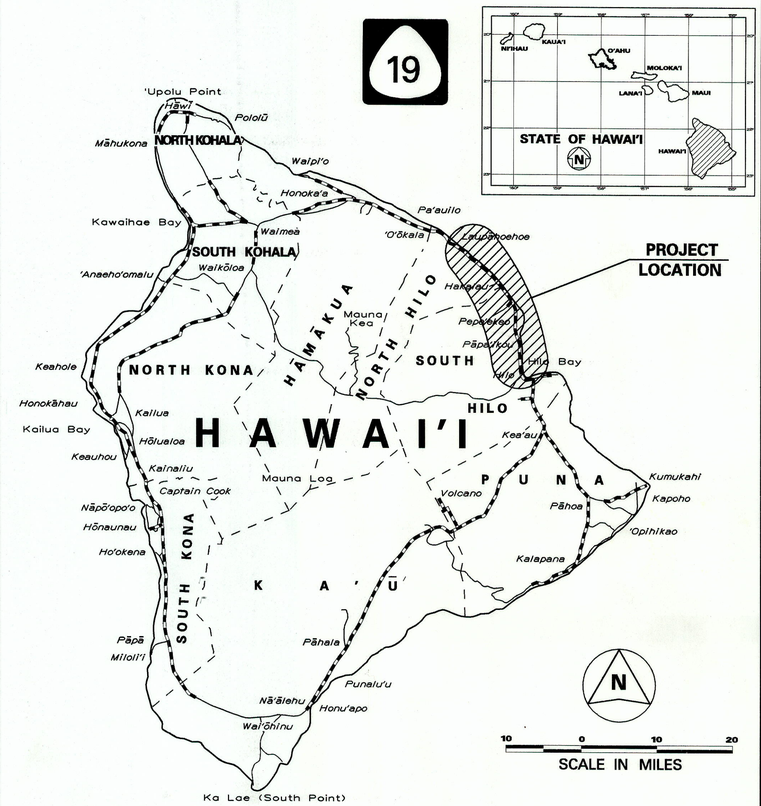

FEDERAL AID PROJECTS PREVIOUSLY CONSTRUCTED OR UNDER CONSTRUCTION

MAULUA BRIDGE	MILE POST 21.76
PAHEEHEE BRIDGE	MILE POST 13.56
KAPUE BRIDGE	MILE POST 6.53
PUKIHAE BRIDGE	MILE POST 3.09

PROJECT NO. HWY-H-08-00M

PROJECT LOCATIONS

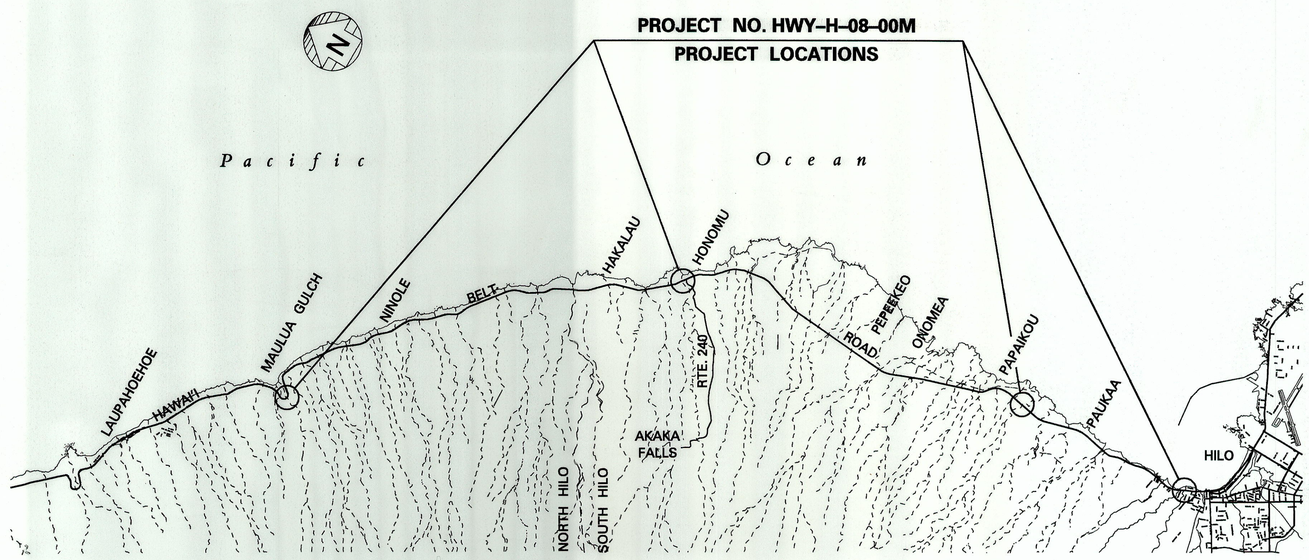

1 0 1 2 3
SCALE IN MILES

LAYOUT PLAN

NO SIGNIFICANT CHANGES WERE MADE DURING CONSTRUCTION ON THESE PLANS EXCEPT CHANGES IN THE ORIGINAL THEORETICAL QUANTITIES. FOR ACTUAL QUANTITIES, REFER TO PROJECT LEDGER AND/OR COMPUTATION BOOK.

RESIDENT ENGINEER — DATE 6/9/14

HWY-H DESIGNED BY	R. TAIRA P. S. & E. BY
933-8866 PHONE	APRIL 2000 DATE

DEPARTMENT OF TRANSPORTATION
STATE OF HAWAII

APPROVED:

DIR. OF TRANSPORTATION — DATE 4/26/00