FED. ROAD DIST. NO.	STATE	FED. AID PROJ. NO.	FISCAL YEAR	SHEET NO.	TOTAL SHEETS
HAWAII	HAW.	NH-019-2(53)	2001	1	15

INDEX TO DRAWINGS	
SHEET NO.	DESCRIPTION
1	TITLE SHEET
2	STANDARD PLANS SUMMARY
3	GENERAL NOTES
4-5	WATER POLLUTION AND EROSION CONTROL NOTES
6-12	HAKALAU BRIDGE PLANS AND ELEVATIONS
13-14	PAHEEHEE BRIDGE PLANS AND ELEVATIONS
15	CONSTRUCTION SIGN AND SCHEDULE

STATE OF HAWAII

DEPARTMENT OF TRANSPORTATION

HIGHWAYS DIVISION

HONOLULU, HAWAII

"AS-BUILT"

PLANS FOR

HAWAII BELT ROAD

CLEAN AND PAINT STEEL MEMBERS

PAHEEHEE AND HAKALAU BRIDGES

FEDERAL AID PROJECT NO. NH-019-2(53)

DISTRICT OF SOUTH HILO

ISLAND OF HAWAII

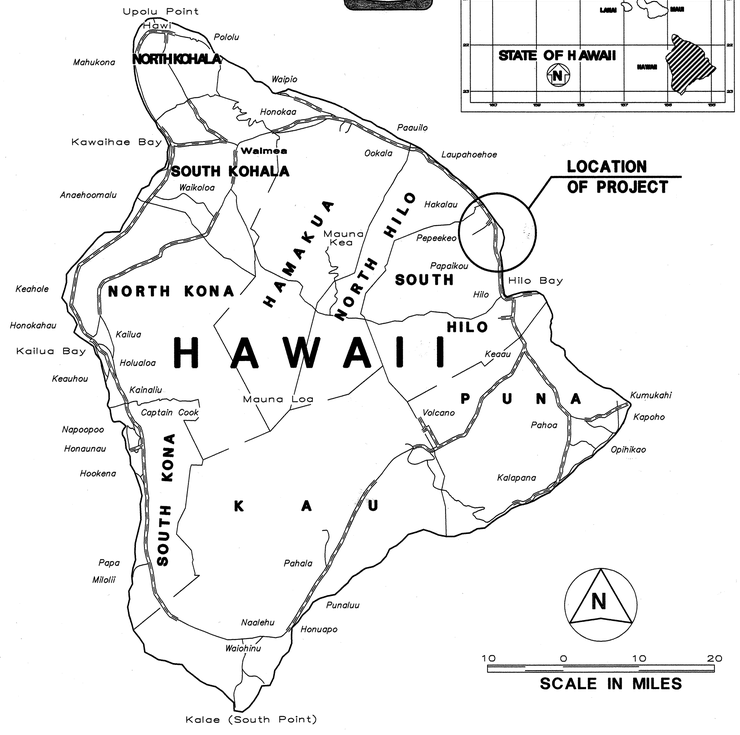

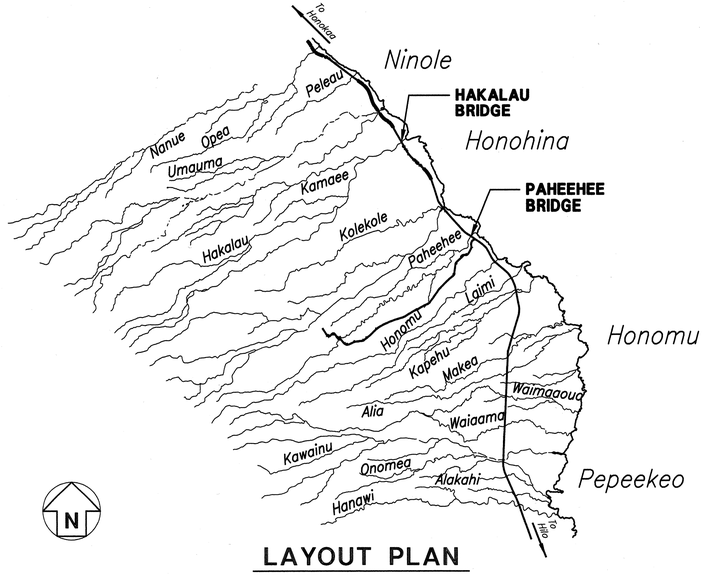

LAYOUT PLAN

FEDERAL AID PROJECTS PREVIOUSLY CONSTRUCTED OR UNDER CONSTRUCTION

MILE POST 13.95 — PAHEEHEE BRIDGE

MILE POST 15.74 — HAKALAU BRIDGE

NO SIGNIFICANT CHANGES WERE MADE DURING CONSTRUCTION ON THESE PLANS EXCEPT CHANGES IN THE ORIGINAL THEORETICAL QUANTITIES. FOR ACTUAL QUANTITIES, REFER TO PROJECT LEDGER AND EXCAVATION BOOK.

RESIDENT ENGINEER — DATE 6/19/06

DEPARTMENT OF TRANSPORTATION
STATE OF HAWAII

APPROVED:

for DIR. OF TRANSPORTATION — DATE 3-21-01

KAI Hawaii, Inc.	Rorbert Taira	Jan 2001
DESIGNED BY	P. S. & E. BY	DATE
	933-8866	
	PHONE	