FED. ROAD DIST. NO.	STATE	FED. AID PROJ. NO.	FISCAL YEAR	SHEET NO.	TOTAL SHEETS
HAWAII	HAW.	NH-019-2(55)	2004	1	112

INDEX TO DRAWINGS

SHEET NO.	DESCRIPTION
1	TITLE SHEET
2	STANDARD PLANS SUMMARY
3	GENERAL NOTES AND LEGEND
4-5	WATER POLLUTION & EROSION CONTROL NOTES
6-8	TYPICAL SECTIONS
9	GENERAL PLAN
10-16	ROADWAY PLANS
17	PAVEMENT RECONSTRUCTION SCHEDULE
18	GUARDRAIL SCHEDULE
19	PAVEMENT MARKINGS, LEGEND, DETAILS & NOTES
20	SIGNAGE NOTES
21-27	SIGNAGE & PAVEMENT MARKING PLANS
28-31	PROJECT SCHEDULES
32	MISCELLANEOUS DETAILS
33	CONSTRUCTION SIGNS
34	CONSTRUCTION PHASING PLAN
35-36	WORK ZONE PHASING PLAN, DETAILS & NOTES
37-51	GUARDRAIL DETAILS
52-112	STRUCTURAL DRAWINGS

CHANGES MADE DURING CONSTRUCTION HAVE BEEN INCORPORATED ON THESE PLANS EXCEPT CHANGES IN THE ORIGINAL THEORETICAL QUANTITIES. FOR ACTUAL QUANTITIES, REFER TO PROJECT LEDGER AND/OR COMPUTATION BOOK.

RESIDENT ENGINEER — DATE 5/3/21

STATE OF HAWAII

DEPARTMENT OF TRANSPORTATION

HIGHWAYS DIVISION

HONOLULU, HAWAII

"AS-BUILT"

PLANS FOR

HAWAII BELT ROAD RESURFACING

EAST PAAUILO BRIDGE TO KAALA BRIDGE

M.P. 35.95 TO M.P. 33.00

FEDERAL-AID PROJECT NO. NH-019-2(55)

DISTRICT OF HAMAKUA

ISLAND OF HAWAII

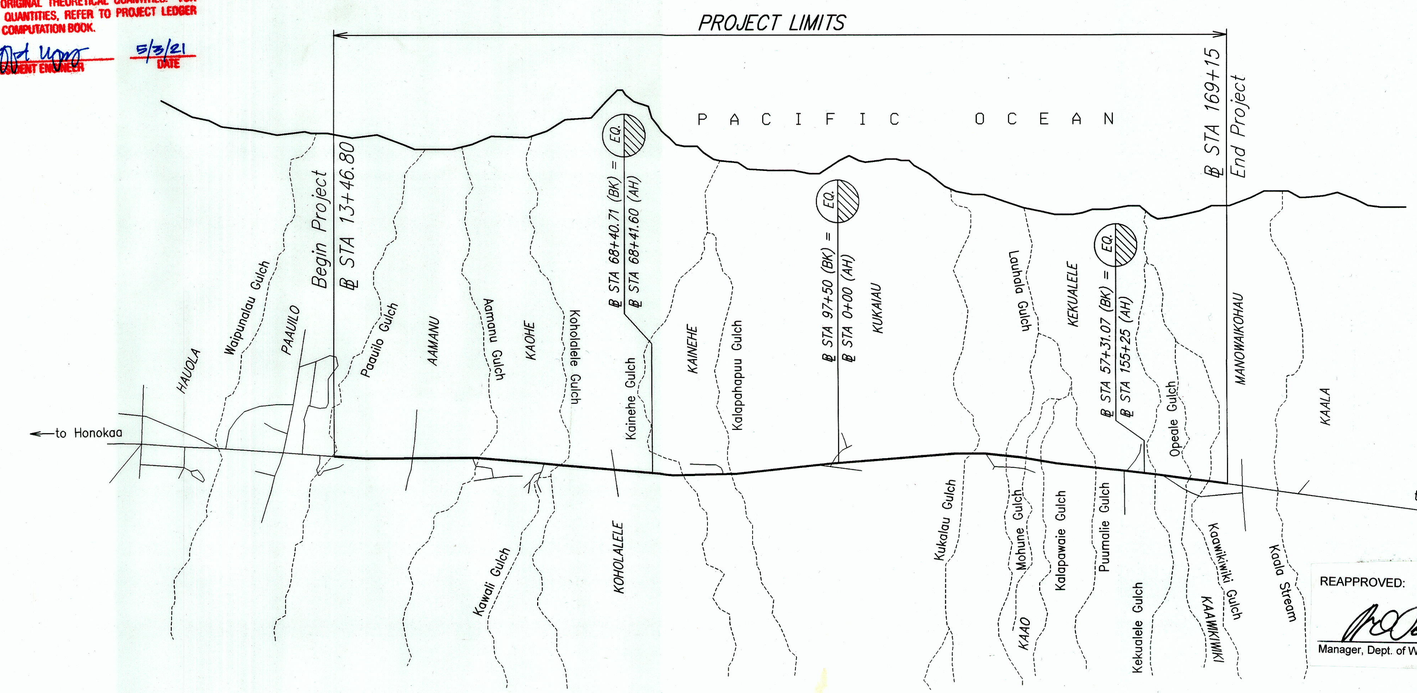

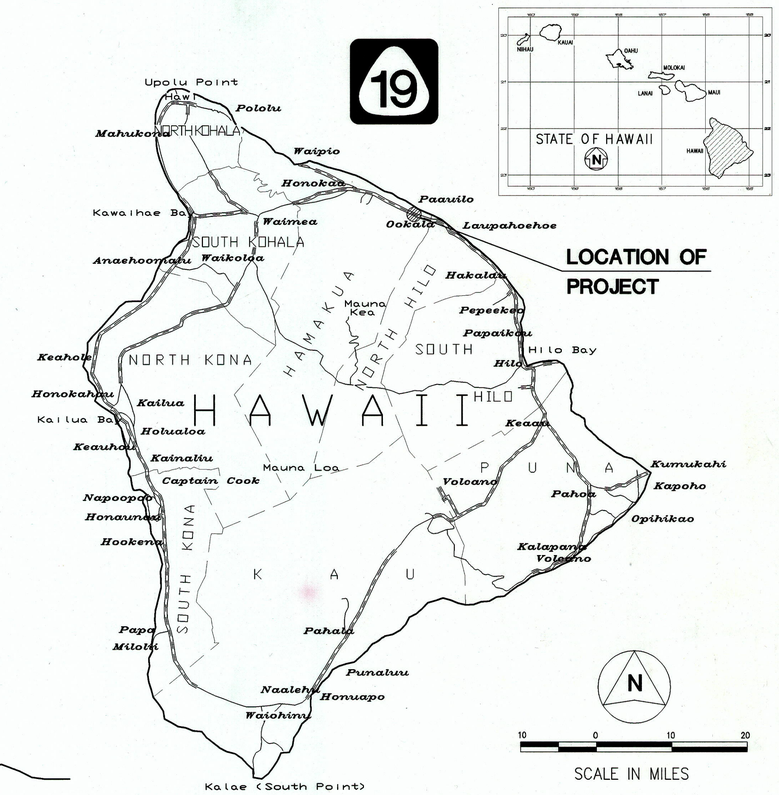

LOCATION OF PROJECT

FEDERAL AID PROJECTS PREVIOUSLY CONSTRUCTED OR UNDER CONSTRUCTION

MILE POST 35.95 TO MILE POST 33.00

DESIGN DESIGNATION

ADT (2003)	6,730
ADT (2013)	7,740
DHV	660
D	55/45
T_{24}	8.5%
V	60 M.P.H.

1 1/2 0 1

SCALE IN MILE

LAYOUT PLAN

LENGTH OF PROJECT: 2.95 MILES

N

REAPPROVED:

Manager, Dept. of Water Supply — Date 11/14/06

APPROVED:

Manager, Dept. of Water Supply — Date 4/23/04

DEPARTMENT OF TRANSPORTATION
STATE OF HAWAII

APPROVED:

for DIR. OF TRANSPORTATION — DATE 5-7-04

MITSUNAGA & ASSOCIATES — DESIGNED BY

HWY-H — MANAGED BY

933-8866 — PHONE

APRIL 2004 — DATE