DIST. NO.	STATE	FED. NO.	FISCAL YEAR	SHEET NO.	TOTAL SHEETS
HAWAII	HAW	A-132-01-60	1960	1	10

April 7, 1960

INDEX TO DRAWINGS

SHEET	DESCRIPTION
1	TITLE SHEET
2	TYPICAL SECTIONS
3-4	PLAN & PROFILE
5-9	CROSS SECTIONS
10	STANDARD DETAILS

STATE OF HAWAII
DEPARTMENT OF TRANSPORTATION
BUREAU OF HIGHWAYS
AS-BUILT
PLANS OF
KAPOHO - PAHOA ROAD
PROJECT NO. A-132-01-60
DISTRICT OF PUNA
ISLAND OF HAWAII

SCALES

PLAN ..... 1 INCH = 100 FT.
PROFILE ..... HOR. 1 INCH = 100 FT.
VER. 1 INCH = 10 FT.
CROSS SECTION ..... HOR. 1 INCH = 10 FT.
VER. 1 INCH = 10 FT.

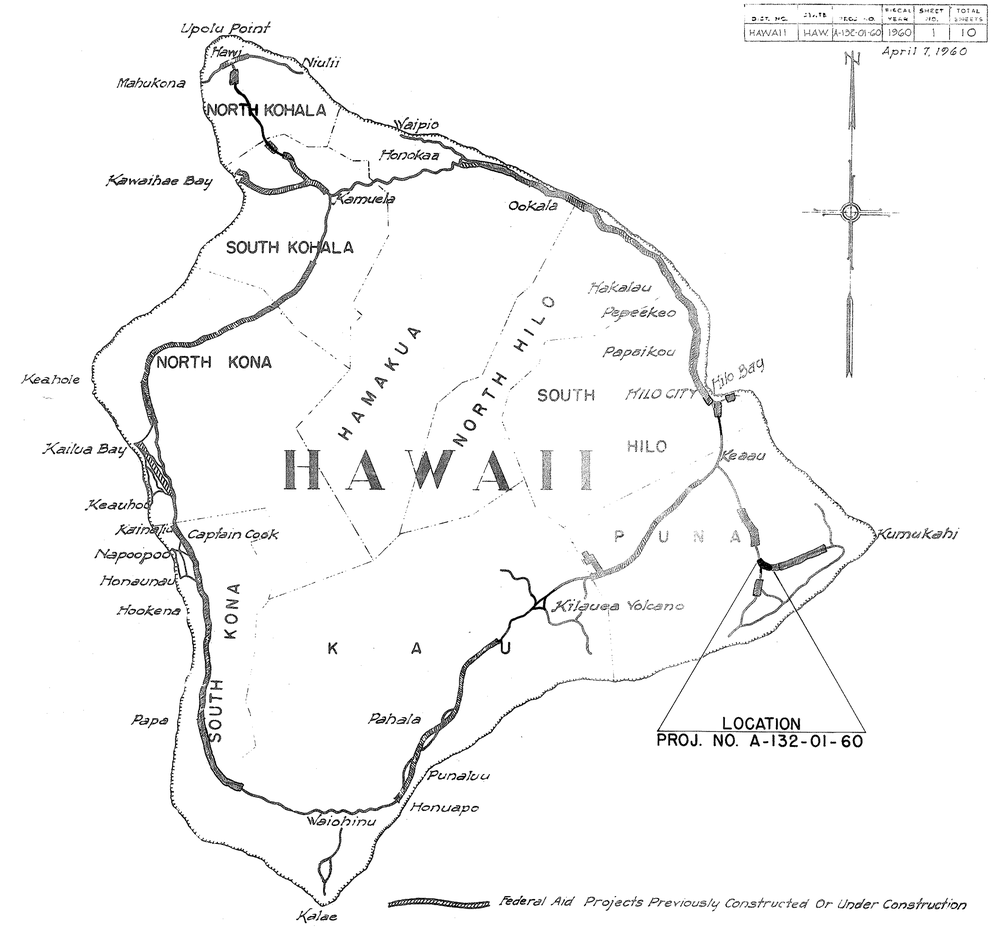

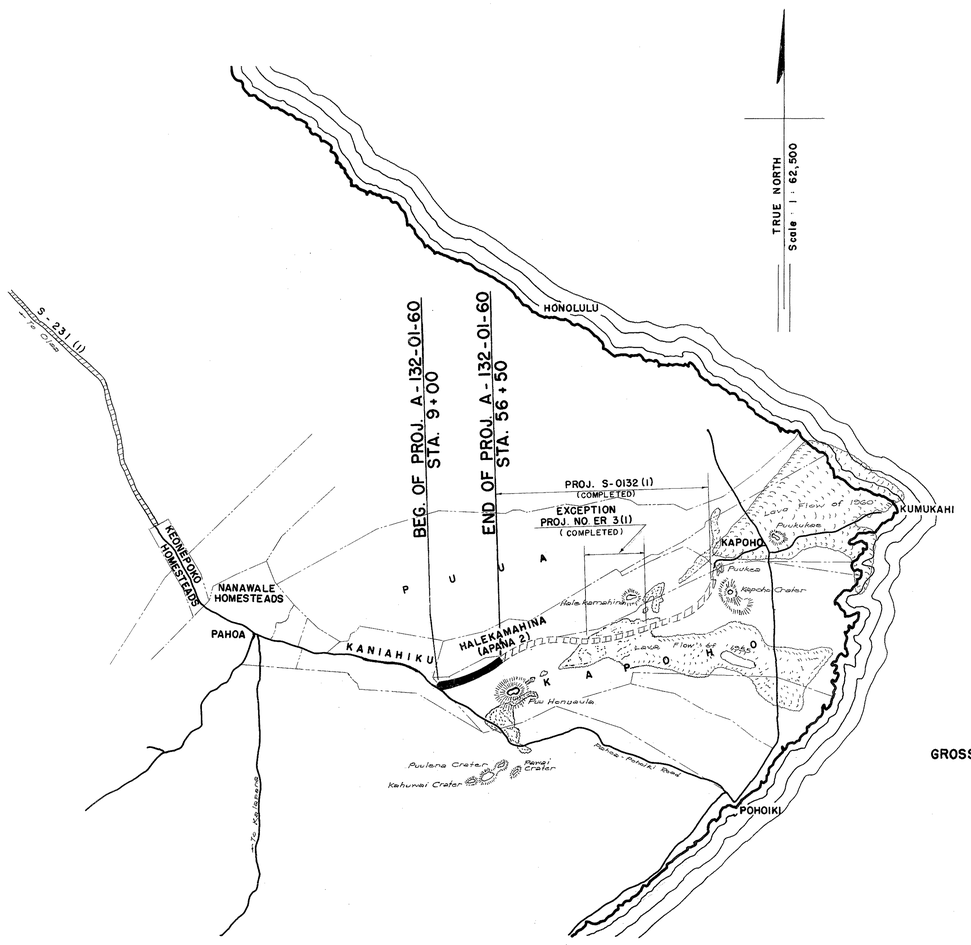

GROSS & NET LENGTH OF PROJECT ..... 0.900 MILES

NOTE:
ALL CHANGES MADE DURING CONSTRUCTION HAVE BEEN NOTED IN RED ON THESE TRACINGS AND CHECKED BY:

PROJECT ENGINEER

10/24/60
DATE

APPROVED: DATE MARCH 22, 1960
DIRECTOR OF TRANSPORTATION

AUTHORIZED BY ACT 224, SLH 1959 SECTION 1(a), ITEM 5B(2), PAR. 9.8

ORIGINAL PLAN	SURVEY PLOTTED BY DESIGNED BY DRAWN BY TRACED BY QUANTITIES BY CHECKED BY	DATE
NOTE BOOK		

A013201G0.1