INDEX TO DRAWINGS	
SHEET	DESCRIPTION
1	TITLE SHEET
2	TYPICAL SECTIONS
3-4	PLAN AND PROFILE
5	MISCELLANEOUS DETAILS
6-9	STANDARD DETAILS
10-13	CROSS SECTIONS

STATE OF HAWAII
DEPARTMENT OF TRANSPORTATION
HIGHWAYS DIVISION

"AS BUILT" PLANS OF

KEAAU - PAHOA ROAD

FEDERAL AID SECONDARY PROJECT NO. S-0130(9)

DISTRICT OF PUNA
ISLAND OF HAWAII

FED. ROAD DIST. NO.	STATE	FED. AID PROJ. NO.	FISCAL YEAR	SHEET NO.	TOTAL SHEETS
HAWAII	HAW.	S-0130(9)	1966	1	13

SCALES

PLAN ..... 1 INCH = 100 FT.
PROFILE ..... HOR. 1 INCH = 100 FT.
VER. 1 INCH = 10 FT.
CROSS SECTION ..... HOR. 1 INCH = 10 FT.
VER. 1 INCH = 10 FT.

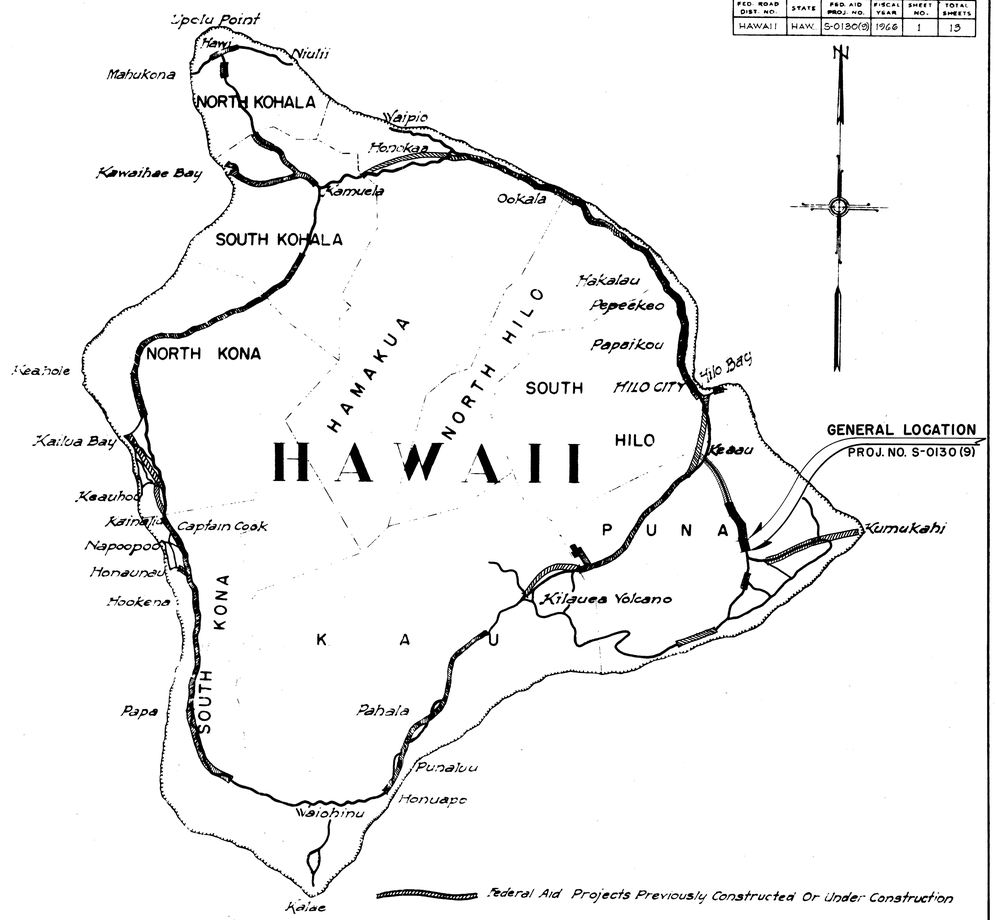

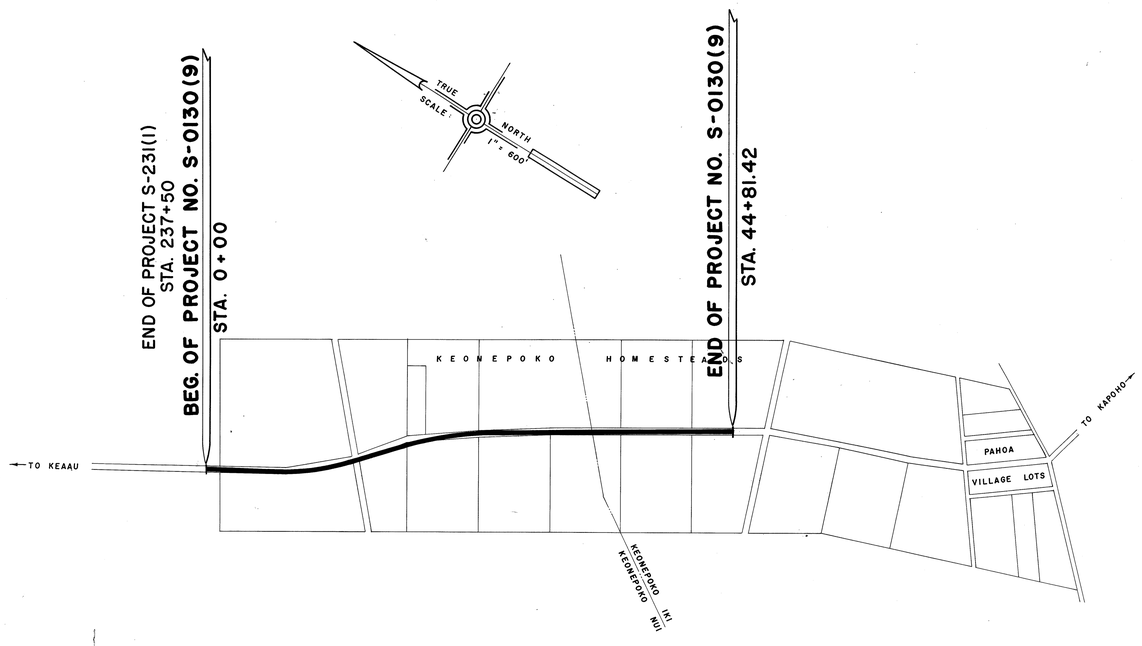

DESIGN CLASSIFICATION

ADT (1965) 800
Design ADT (1985) .. 3000
DHV ..... 12 %
D 60/40
T ..... 13 %
V ..... 60 M.P.H.

LAYOUT OF PROJECT

GROSS & NET LENGTH OF PROJECT.....0.849 Mi.

NOTE:
ALL CHANGES MADE DURING CONSTRUCTION HAVE BEEN NOTED ON THESE TRACINGS IN RED AND CHECKED BY:

Denzo Kodani
PROJECT ENGINEER

DATE

APPROVED: DATE 11-10-66
for DIRECTOR OF TRANSPORTATION

DEPARTMENT OF COMMERCE
BUREAU OF PUBLIC ROADS
APPROVED:
DIVISION ENGINEER DATE 11-22-66

ORIGINAL PLAN — NEW WORK
SURVEY PLOTTED BY
DRAWN BY R. Terada DATE Nov. '66
TRACED BY
QUANTITIES BY
QUANTITIES CHECKED BY
CHECKED BY