FED. ROAD DIST. NO.	STATE	FED. AID PROJ. NO.	FISCAL YEAR	SHEET NO.	TOTAL SHEETS
HAWAII	HAW.	S-0130(7)	1967	23	53

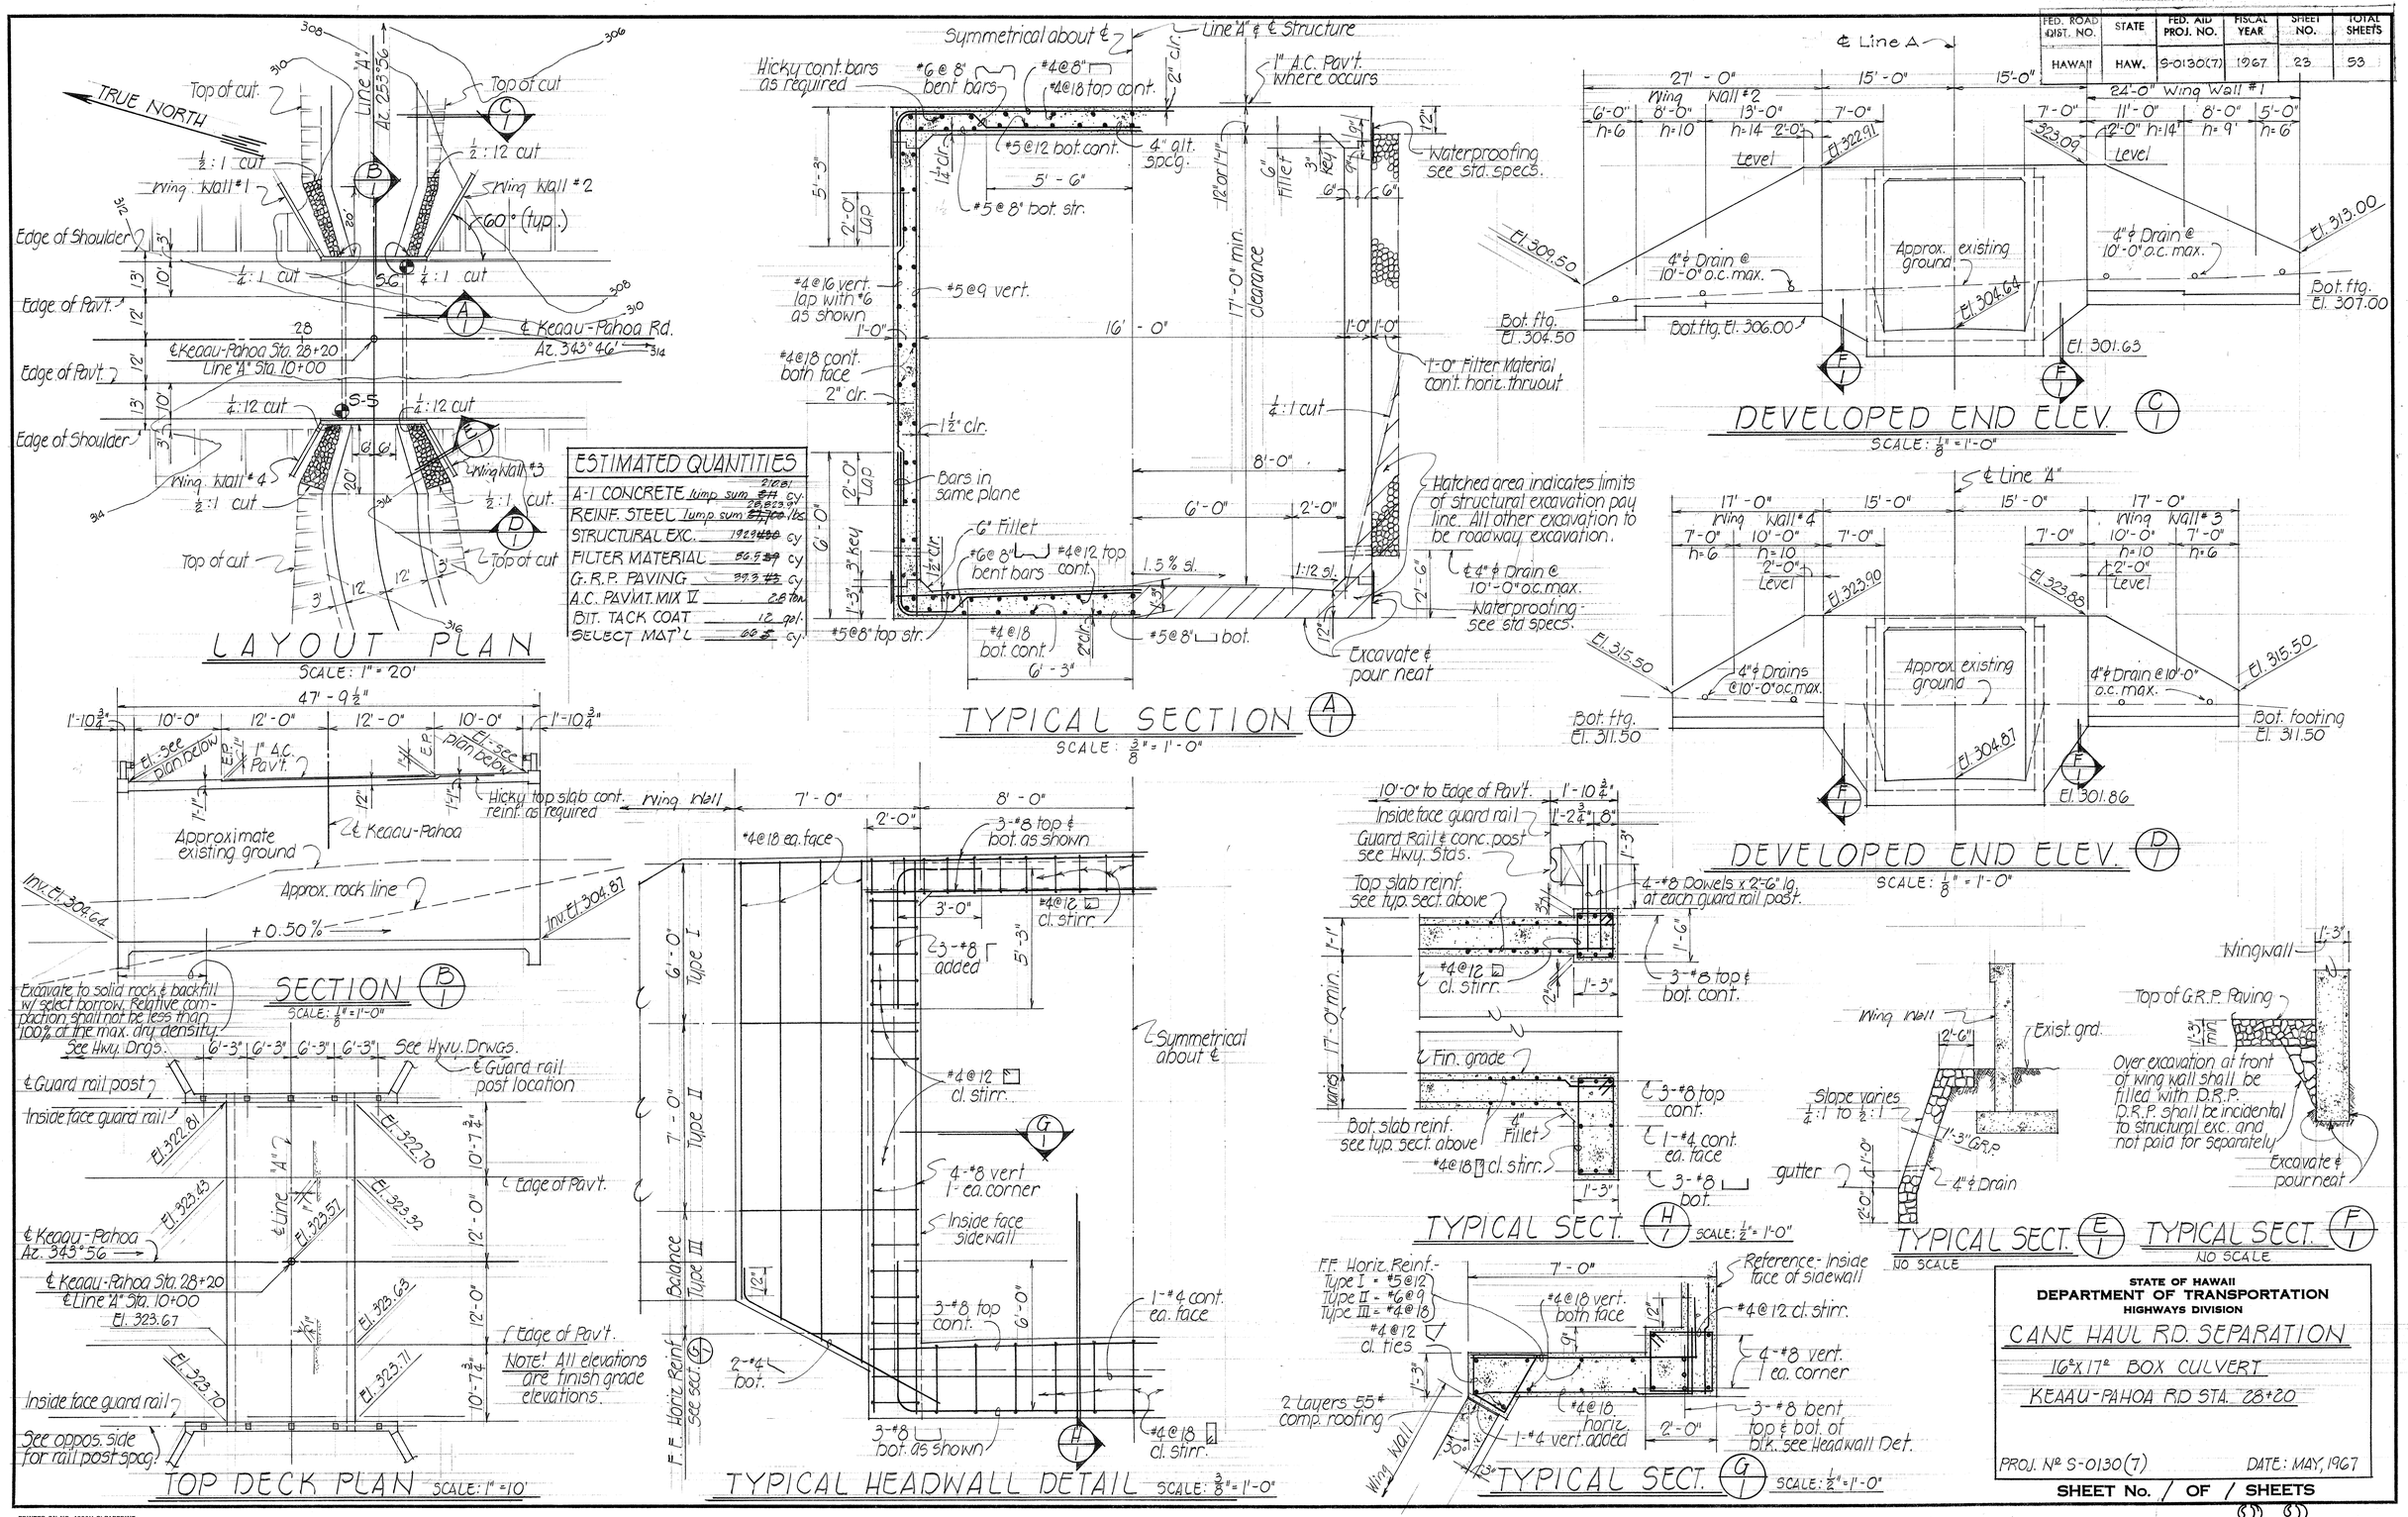

ESTIMATED QUANTITIES		
A-1 CONCRETE	lump sum ~~[illegible]~~	216.81 cy.
REINF. STEEL	lump sum ~~[illegible]~~	28,823.9 lbs.
STRUCTURAL EXC.	192.9 ~~[illegible]~~	cy
FILTER MATERIAL	56.5 ~~[illegible]~~	cy
G.R.P. PAVING	39.3 ~~[illegible]~~	cy
A.C. PAV'MT. MIX V	28	ton
BIT. TACK COAT	12	gal.
SELECT MAT'L	60 ~~[illegible]~~	cy

ORIGINAL PLAN	SURVEY PLOTTED BY	DATE
	DRAWN BY J. Ellison	4/20/67
	TRACED BY	" " "
	DESIGNED BY L. Chan	" " "
NOTE BOOK	QUANTITIES BY L. Chan	" " "
No.	CHECKED BY R. Kawamura	" " "

STATE OF HAWAII
DEPARTMENT OF TRANSPORTATION
HIGHWAYS DIVISION

CANE HAUL RD. SEPARATION

16' x 17' BOX CULVERT

KEAAU-PAHOA RD STA. 28+20

PROJ. No. S-0130(7) DATE: MAY, 1967

SHEET No. / OF / SHEETS

PRINTED ON NO. 1000H CLEARPRINT